SH

File/Permit #: 2024-53374

IREDELL COUNTY HEALTH DEPARTMENT
JANE HINSON, MS, BSN, RN
HEALTH DIRECTOR

Public Health
Prevent. Promote. Protect.
Iredell County Health Department

EXISTING SYSTEM APPROVAL

Issued by: ☒ Local Health Department ☐ AOWE ☐ Certified Inspector

☒ Existing System Approval
- ☐ Site modification (e.g., storage shed) or footprint addition with no DDF or wastewater strength increase
- ☒ Reconnection when the proposed facility is in the same footprint as existing/previous facility

☐ Construction Authorization/Notice of Intent to Construct

[issued for reconnection when the proposed facility is not in the same footprint as existing/previous facility pursuant to Session Law 2023-77, Section 5.(c)]
[certified inspectors are not authorized to approve reconnections outside of footprint pursuant to Session Law 2023-77, Section 5.(c)]

Applicant: Doug Folding
Mailing Address: 1270 Northside Dr
City: Statesville
State: NC Zip: 28625
Phone #: 832-207-1947
Email: dfolding@hallowayfamilyhomes.com

Owner: Chris Walkup
Mailing Address: 144 Hickory Hollar Dr
City: Statesville
State: NC Zip: 28625
Phone #: 619-559-5788
Email:

PIN/Lot Identifier: 3792-35-8002
Property Location/Address: 144 Hickory Hollar Dr, Statesville 28625 (No Sub)
Facility Type: ☒ House/Modular ☐ Mobile/Manufactured Home ☐ Business ☐ Other:

Operation Permit/ATO #: 2024-53374 Design Daily Flow: 360 GPD
Number of Bedrooms: 3 Max # Occupants: 6 Other:
Wastewater Strength: ☒ Domestic ☐ High Strength ☐ Industrial Process Wastewater
Water Supply: ☒ Private well ☐ Public well ☐ Shared well ☐ Municipal Supply ☐ Spring ☐ Other:

Proposed Property Improvement: Rebuilding house that burned down in same spot. See attached operation permit dated 11/15/23.

All of the following must be checked for approval:

***For Reconnections:**
- ☒ Site complies with its Operation Permit or the wastewater system was in use prior to July 1, 1977
- ☒ No current or past uncorrected malfunction of the system as described in 15A NCAC 18E .1303(a)(2)
- ☒ DDF and wastewater strength for the proposed facility do not exceed that of the existing system
- ☒ Facility meets the setbacks in Section .0600 of 15A NCAC 18E
- ☒ Existing system is being operated and maintained in accordance with Section .1300 of 15A NCAC 18E and permit conditions.

***For Site Modifications or Footprint Expansions:**
- ☐ Proposed structure meets the setbacks in Section .0600 of 15A NCAC 18E

Approval Conditions: System appeared to be functioning at time of inspection.

Inspector's Printed Name: Cory Whicker Inspector Certification #: 3014
Inspector's Signature: Cory Whit Date: 5/21/24

See attached site sketch

EXISTING SYSTEM APPROVAL

SITE SKETCH

Operation Permit/ATO #: 2024-53374 PIN/Lot Identifier: 3792-35-8002

Owner: Chris Walkup Property Location/Address: 144 Hickory Hollar Dr, Statesville 28625

See attached by ICHD

5/21/24

Include the existing and proposed structures and applicable setbacks.

Central Office
318 Turnersburg Hwy
Statesville, NC 28625
704-878-5300

Mooresville Site
610 E. Center Avenue
Mooresville, NC 28115
704-664-5281

Environmental Health
349 N. Center Street
Statesville, NC 28677
704-878-5305 x3456

www.co.iredell.nc.us/161/Health-Department

ICHD - ENVIRONMENTAL HEALTH DIVISION

Statesville Office (704) 878-5305 Mooresville Office (704) 660-3625 PERMIT # 0SWP-2022-1554

SEPTIC: IMPROVEMENT PERMIT / AUTHORIZATION TO CONSTRUCT / OPERATION PERMIT / EXISTING SYSTEM

PIN # 3792 -- 35 -- 8002

APPLICANT/OWNER: Chris Walkup APPLICANT ADDRESS: 10515 Ironwood Ave, Santee CA

SITE ADDRESS: 144 Hickory Hollar Dr, Statesville 28625 PHONE: 619-559-5188 ALT. PHONE -

SITE DIRECTIONS: Hwy 70 W - Hickory Hollar SAP CONTROLLED: ☐ YES ☒ NO

SUBDIVISION: - SECTION: -- LOT # -- LOT AREA: 8 acres DESIGN FLOW: 360 gpd L.T.A.R.: 0.3


Septic Tank	1000 (gal)	STB	760	Date	9/30/23	☒ New System ☐ Repair ☐ Expansion	System Type: I II (III) IV V VI	☒ Residence	No. Bedrooms 3
Pump Tank	(gal)	PT		Date		System Description:	25% reduction	☐ Business	No. Persons 6
Pump Make		Model		Serial #		Repair System Description:	25% reduction	☐ Other	No. Employees
# Nitrification Fields	1	# Lines	3	Linear Ft	300'	Maintenance Agreement Required:	☐ YES ☒ NO	☐ Slab	☒ Crawl Space
Trench Width	36 in	Trench Bottom Depth ~~(Low side)~~	36" max	Gravel Depth	-	☒ GRAVITY	☐ PRESSURE	☐ Basement w/ plumbing	☐ Basement w/o plumbing

Water Supply: ☒ Private ☐ Public ☐ Community

Comments / Conditions: Install lines on contour with the land. Do not grade, park, or drive on septic area.

* House plans too big, does not impact septic. *

INITIAL SITE SKETCH

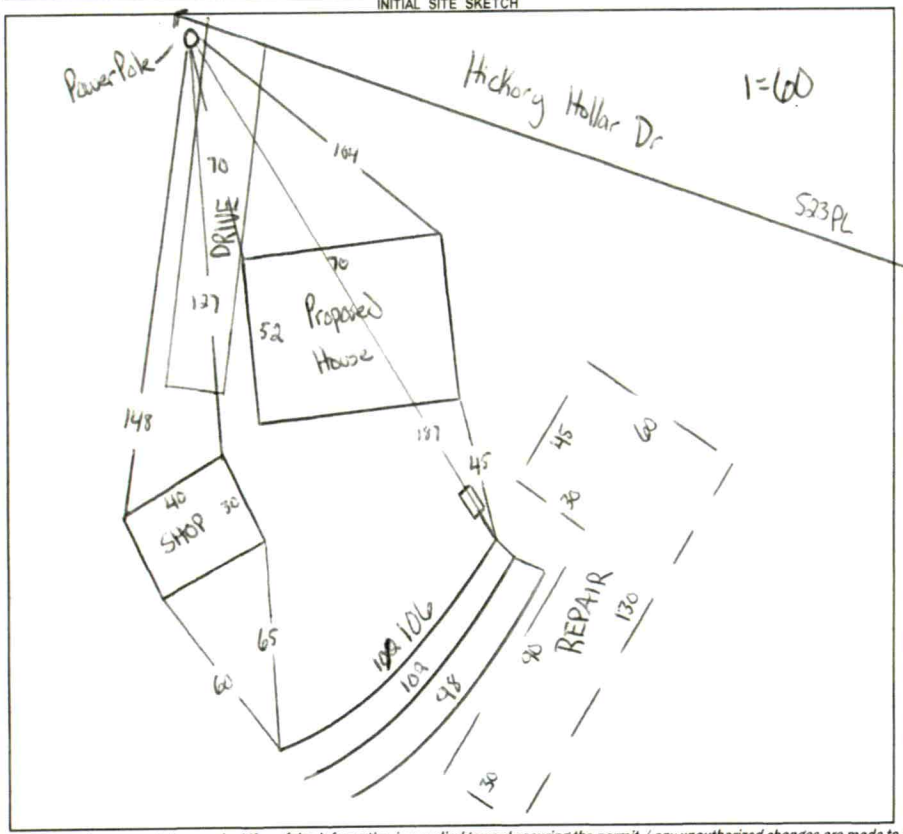

AS BUILT SKETCH

FOR SEPTIC FINAL INSPECTION CALL: 704-664-3703 between 8am-9am the day the inspection is needed. Be sure to speak with an inspector to confirm your time.

Installed as Drawn

5/21/24

CW

Permit can be suspended or revoked if any false information is supplied toward securing the permit / any unauthorized changes are made to the site / any unauthorized changes are made in the installation of the system. **CONTACT A LOCATOR SERVICE PRIOR TO ANY EXCAVATION**

☐ **IMPROVEMENT PERMIT** ***with plat*** *valid without expiration.* ☒ **IMPROVEMENT PERMIT** ***with site plan*** *valid for 60 mos.* ☒ **AUTHORIZATION TO CONSTRUCT** *valid for period equal to IMPROVEMENT PERMIT--not to exceed 60 mo.*

Owner / Applicant Signature: Online Signature Date:

IMPROVEMENT PERMIT by: Cary Hill Date: 11/14/22

AUTHORIZATION TO CONSTRUCT by: Cary Hill Date: 3/8/23

Installed by: Tim Summey

OPERATION PERMIT by: Cary Hill Date: 11/15/23

Existing System Inspected by: Date:

FOR SEPTIC FINAL INSPECTION: CALL 704-664-3703 between 8am-9am the day the inspection is needed.