R-pair

IREDELL COUNTY HEALTH DEPARTMENT

STATESVILLE 704-878-5305 MOORESVILLE 704-664-5281

IMPROVEMENT PERMIT / AUTHORIZATION TO CONSTRUCT / OPERATION PERMIT / EXISTING SYSTEM INSPECTION

PERMIT # Repair PIN # 3792-36-2996 DATE 6 May 09

OWNER or APPLICANT Rebecca Ferrera PHONE: Business (704) 902-4040 Home:

OWNER or APPLICANT ADDRESS 175 Sharon School Rd.

LOCATION / DIRECTIONS Hwy 40 W TL Sharon School Rd Last House on Rt.

SUBDIVISION BLOCK / SECTION LOT # LOT AREA 1.3 Ac± DESIGN FLOW 360 gpd L.T.A.R. 0.3

Septic Tank Gallons: STB Date

Pump Tank Gallons: P T Date

Pump Make Model Serial #

Nitrification Field No Fields 1 No Lines 400 Linear Feet 200

Trench Width 36" Max. Trench Bottom Depth 36" Gravel Depth 24

☐ New System ☑ Repair ☐ Expansion System Type I II III IV V VI

System Description: 25% Reduction

Repair System Description:

Maintenance Agreement Required ☐ YES ☐ NO

☑ GRAVITY ☐ PRESSURE

☑ Residence No. Bedrooms 3

☐ Business No. Persons

☐ Other No. Employees

☐ Slab ☑ Crawl Space

☐ Basement w/plumbing ☐ Basement w/o plumbing

Water Supply: ☐ Private ☑ Public ☐ Community

Comments / Conditions: Both existing wells must be abandoned before system installed.

Comments / Conditions: New Polyfoam Filter Tee


INITIAL SITE SKETCH

Please see Attached Site sketch.

Add 800 Ft² to existing system

* Replace Tank if necessary.

AS BUILT SKETCH

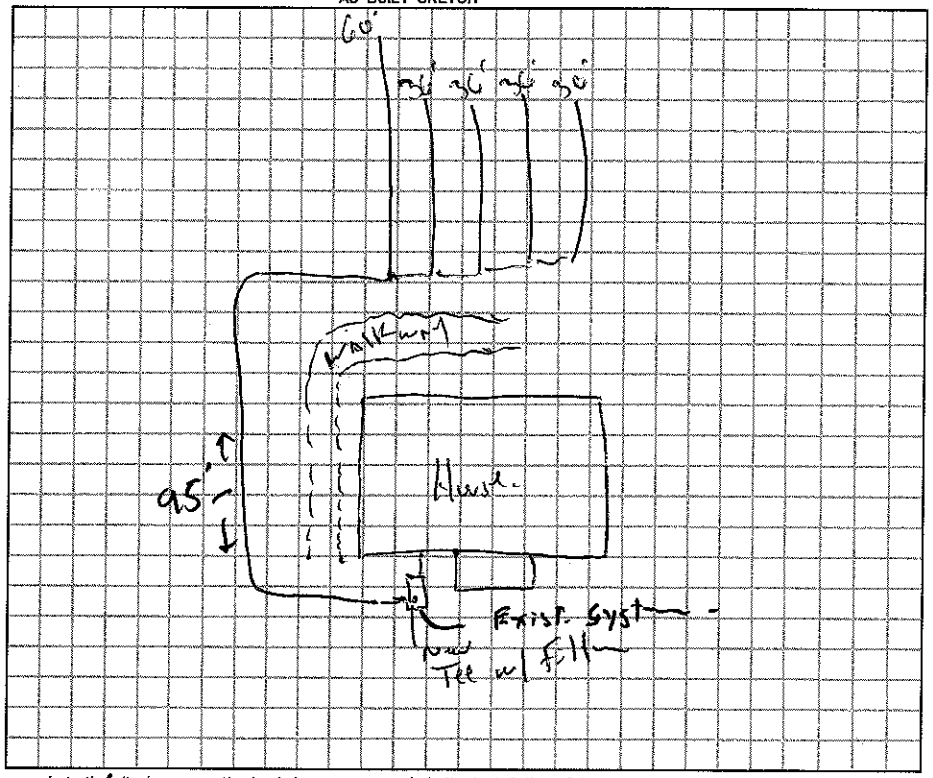

Permit can be suspended or revoked if any false information is supplied toward securing the permit / any unauthorized changes are made to the site / any unauthorized changes are made in the installation of the system.

☐ *IMPROVEMENT PERMIT w / plat valid without expiration.* ☐ *IMPROVEMENT PERMIT w / site plan valid for 60 mos.* ☑ *AUTHORIZATION TO CONSTRUCT valid for period equal to IMPROVEMENT PERMIT-not to exceed 60 mo.*

Owner / Applicant Signature: Rebecca Ferrera Date May 8

Improvement Permit by: Date

Authorization to Construct by: R.S. Date 6 May 09

Installed by: Cyndy Thompson

Operation Permit by: R.S. Date: 19 May 09

Existing System Inspected by: Date:

YOU SHOULD CONTACT A LOCATOR SERVICE PRIOR TO ANY EXCAVATION.

WHITE COPY Environmental Health YELLOW COPY (Final) Owner / Applicant PINK COPY (Initial) Owner / Applicant