IREDELL COUNTY HEALTH DEPARTMENT

STATESVILLE 704-878-5305 MOORESVILLE 704-664-5281

IMPROVEMENT PERMIT / CERTIFICATE OF COMPLETION / OPERATION PERMIT / EXISTING SYSTEM INSPECTION

PROPERTY DESCRIPTION NO. 16088 DATE 7-8-94 TAX MAP NO. 8H-1-A-34 Watershed: ☐ Yes ☑ No

OWNER OR CONTRACTOR Doug Walden PHONE: Business _____ Home 872-0867

ADDRESS _____

LOCATION Hwy 70W TR Sharon School Rd Lot on R behind 2nd House on R.

SUBDIVISION NA BLOCK / SECTION – LOT – LOT AREA 1.9 acres SITE CLASS. P.S. DESIGN FLOW 360 L.T.A.R. .35 gpd/ft²

Septic Tank: 1000 Gallons; STB 1012 Date 4-4-94

Pump Tank: – Gallons; PT – Date –

Pump Make: – Model – Serial No. –

Nitrification Field: No Fields 1 Square Feet 1035 Linear Feet 345'

No Lines 3 Trench Width 36" Max Trench Bottom Depth 24" Gravel Depth 12"

☑ New System ☐ Repair System Type: I, II, III, IV, V, VI

System Description: Conventional, gravity fed

Repair System Description: " "

Maintenance Agreement Required: ☐ Yes ☑ No

☑ House/Mod. Home No. Bedrooms 3

☐ Mobile Home No. Bathrooms 3

☐ Business No. Employees _____

☐ Other _____

☐ Slab ☐ Crawl Space ☑ Basement w/plumbing ☐ Basement wo/plumbing


Water Supply: ☐ Individual ☐ Community ☑ Public

Comments:

Comments: Route surface drainage and down spouts around septic system. Keep water line 10' from any part of septic system. 100% Repair Area below system, conventional, gravity fed

INITIAL SITE SKETCH

AS BUILT SKETCH

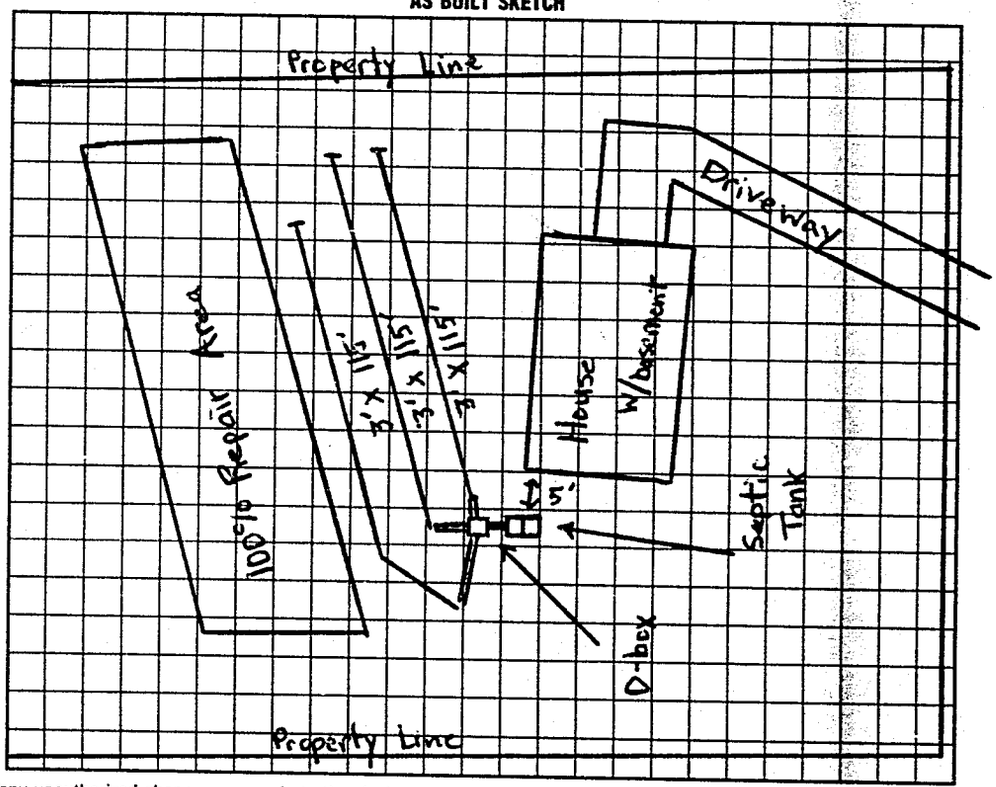

I understand that this permit can be suspended or revoked if any false information is supplied toward securing the permit/any unauthorized changes are made to the site/any unauthorized changes are made in the installation of the system. Improvement Permit is valid for 60 months from date of issuance.

Signed: _____

Improvement Permit by: Michael J. Dennis date 4-8-93

Existing System Inspection by: _____ date _____

Installed by: Harry Reep

Certificate of Completion by: Michael J. Dennis date 7-8-94

Operation Permit by: _____ date _____

HEALTH DEPT. COPY: WHITE INSPECTION COPY (FINAL): GREEN OWNER COPY (FINAL): YELLOW INSPECTION COPY (INITIAL): PINK OWNER COPY (INITIAL): GOLD