IREDELL COUNTY HEALTH DEPARTMENT

STATESVILLE 704-878-5305 (C) MOORESVILLE 704-664-5281

IMPROVEMENT PERMIT / AUTHORIZATION TO CONSTRUCT / OPERATION PERMIT / EXISTING SYSTEM INSPECTION

PERMIT# 101512 PIN# 3792-38-6161 DATE 8-13-01

OWNER OR CONTRACTOR ROBERT SHARPE PHONE: Business (704) 872-3653 Home

ADDRESS 160 SHARON SCHOOL RD, STATESVILLE, NC 28677

LOCATION I-40 WEST, TL SHARON SCH. RD, ON, LEFT BEHIND BOX # 170

SUBDIVISION ABERNATHY FARMS BLOCK / SECTION LOT 20 LOT AREA ACREAGE SITE CLASS PS DESIGN FLOW 360 L.T.A.R. 0.30 GAD/A-2

Septic Tank: 1000 Gallons: STB 1012 Date 4-10-02
Pump Tank: Gallons: PT Date
Pump Make: Model Serial No.
Nitrification Field: No Fields 1 Square Feet 1200 Linear Feet 400
No Lines SIX Trench Width 36" Max Trench Bottom Depth 36" Gravel Depth 12"

☑ New System ☐ Repair System Type: I (II) III IV V VI
System Description: CONVENTIONAL GRAVITY
Repair System Description: CONV. GRAVITY
Maintenance Agreement Required: ☐ Yes ☑ No
☐ Slab ☑ Crawl Space ☐ Basement w/plumbing ☐ Basement wo/plumbing


☐ House/Mod. Home No. Bedrooms 3
☑ Mobile Home No. Bathrooms 2
☐ Business No. Employees
☐ Other

Water Supply: ☑ Individual ☐ Public ☐ Community
WELL

Comments/Conditions: ① CONTACT HEALTH DEPT. AFTER CLEARING TO FLAG-OUT SYSTEM ② USE ONE FLOW DIVIDER TEE TO ACHIEVE EQUAL DISTRIBUTION INTO TWO SETS OF DROP BOXES

Comments/Conditions: SEPTIC TANK WITH MARKER INSTALLED USING "POLYLOK" FILTER

INITIAL SITE SKETCH

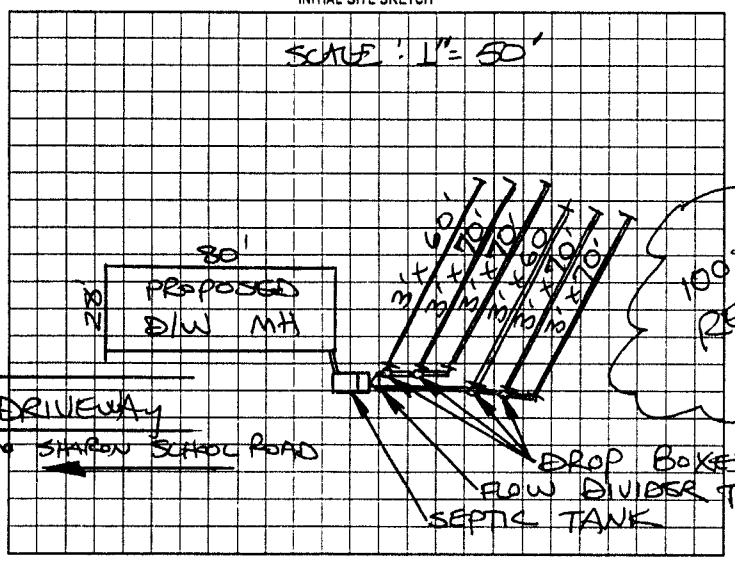

AS BUILT SKETCH

SYSTEM INSTALLED ACCORDING TO INITIAL SITE SKETCH

Permit can be suspended or revoked if any false information is supplied toward securing the permit/any unauthorized changes are made to the site/any unauthorized changes are made in the installation of the system. Improvement Permit with plat valid without expiration. Improvement Permit with site plan valid for sixty months. Authorization to Construct is valid for a period equal to that of Improvement Permit – not to exceed sixty months.

Signed: [signature] date 8/13/01 Installed by: FORREST STAFFORD

Improvement Permit by: STEVE HEDRICK date 8-13-01 Operation Permit by: STEVE HEDRICK date 7-22-02

Authorization to Construct by: STEVE HEDRICK date 8-13-01 Existing System Inspection by: date

HEALTH DEPT. COPY WHITE OWNER COPY (FINAL) YELLOW OWNER COPY (INITIAL) PINK