Clayton Homes

IREDELL COUNTY HEALTH DEPARTMENT

STATESVILLE 704-878-5305 MOORESVILLE 704-664-5281

IMPROVEMENT PERMIT / AUTHORIZATION TO CONSTRUCT / OPERATION PERMIT / EXISTING SYSTEM INSPECTION

PERMIT# ~~04239~~ 11973 PIN# 3792 46 4421 DATE March 16, 01

OWNER OR CONTRACTOR Stewart W. Smith PHONE: Business (252) 522-2675 Home

ADDRESS 2133 Oakview St. Kinston, N.C. 28504

LOCATION From Stov 70 WEST past jct w/ Eutola Rd. TL Rosa Jane Ct. 2nd lot on left

SUBDIVISION C.A. Stewart Est BLOCK / SECTION LOT 2 LOT AREA ±.56 Ac SITE CLASS. PS DESIGN FLOW 360 gpd L.T.A.R. .3

Septic Tank: 1000 Gallons; STB 312 Date 3-5-04
Pump Tank: Gallons; PT Date
Pump Make: Model Serial No.
Nitrification Field: No Fields 1 Square Feet 1200 Linear Feet 400
No Lines 5 @ 80' Trench Width 36" Max Trench Bottom Depth 36" Gravel Depth 12"

☑ New System ☐ Repair System Type: I, II, III, IV, V, VI
System Description: *Gravity conventional
Repair System Description: Same
Maintenance Agreement Required: ☐ Yes ☑ No

☑ House/Mod. Home No. Bedrooms 3
☐ Mobile Home No. Bathrooms 2
☐ Business No. Employees
☐ Other


☐ Slab ☑ Crawl Space ☐ Basement w/plumbing ☐ Basement wo/plumbing

Water Supply: ☐ Individual ☑ Public ☐ Community


Comments:/Conditions: * Do not cut/lower house site
House plans submitted, House in same location.

Comments:/Conditions: ① Zabel Filter ② #5 Stone ③ D-Boxes used instead of drop boxes, being a relatively flat lot ④ Alterations illustrated in as-built sketch

INITIAL SITE SKETCH

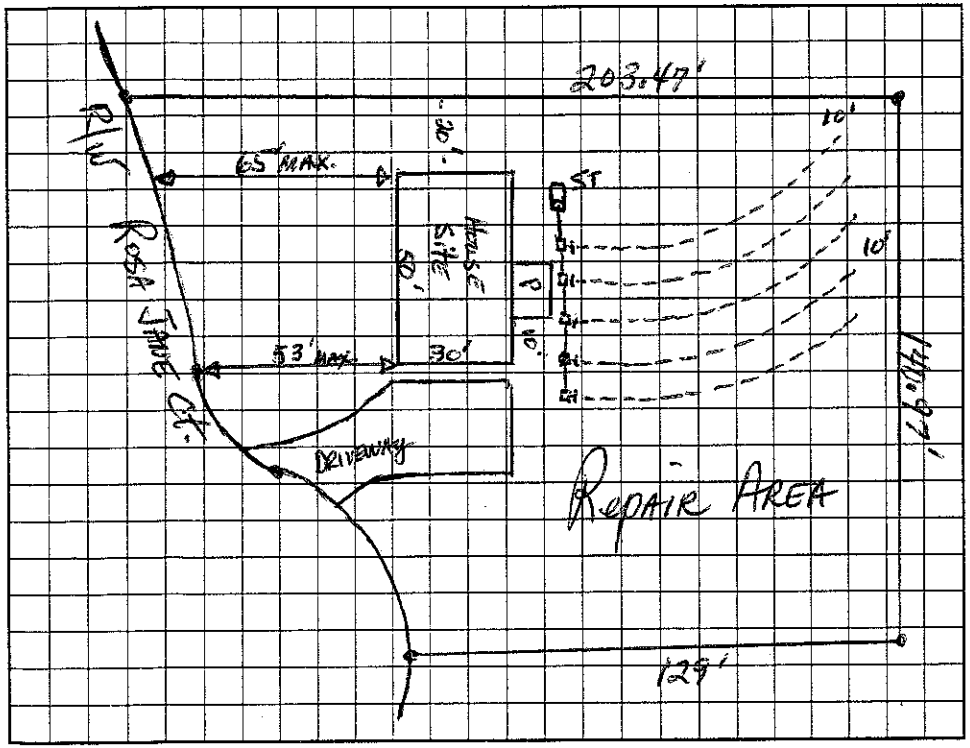

AS BUILT SKETCH Scale 1"=50'

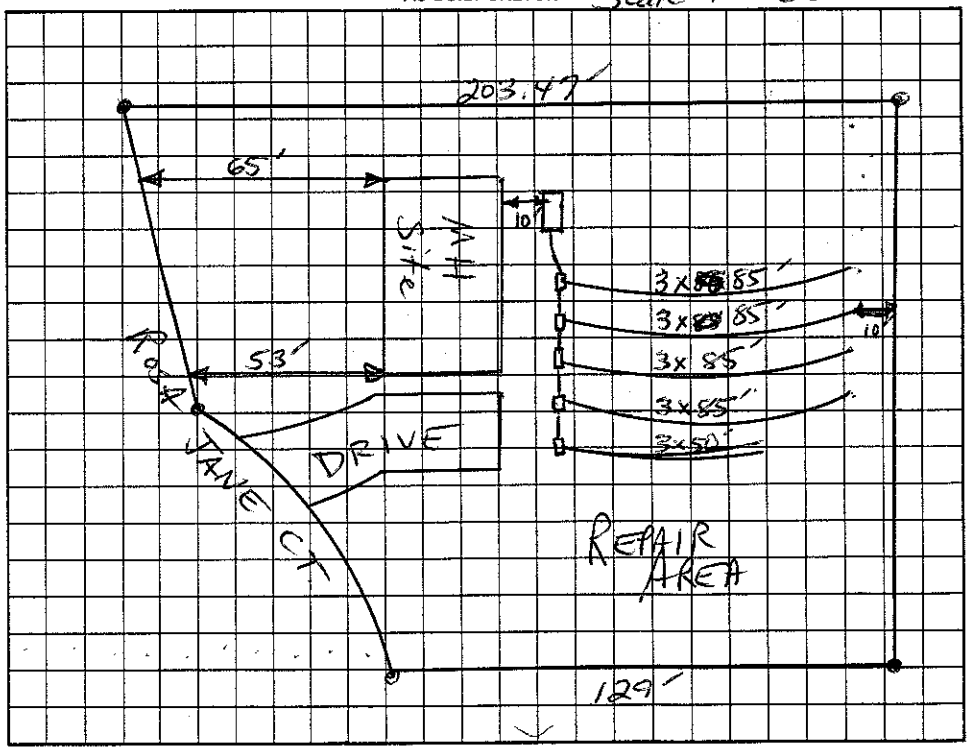

Permit can be suspended or revoked if any false information is supplied toward securing the permit/any unauthorized changes are made to the site/any unauthorized changes are made in the installation of the system. Improvement Permit with plat valid without expiration. Improvement Permit with site plan valid for sixty months. Authorization to Construct is valid for a period equal to that of Improvement Permit – not to exceed sixty months.

Signed: date 7-19-01
Improvement Permit by: , RS date 3-16-01
Authorization to Construct by: date 3-19-04

Installed by: Specialty Septic
Operation Permit by: Christopher M. Sherrill, RS date 4-7-04
Existing System Inspection by: date

HEALTH DEPT. COPY: WHITE OWNER COPY (FINAL): YELLOW OWNER COPY (INITIAL): PINK