IREDELL COUNTY HEALTH DEPARTMENT

STATESVILLE 704-878-5305 MOORESVILLE 704-664-5281

IMPROVEMENT PERMIT / AUTHORIZATION TO CONSTRUCT / OPERATION PERMIT / EXISTING SYSTEM INSPECTION

PERMIT# 79658 PIN# 3792566528 DATE 3-24-99

OWNER OR CONTRACTOR Stephen R Sipes PHONE: Business Home 872 6106

ADDRESS 206 Magnolia St. Statesville, N.C.

LOCATION To W Before & Fenfola Rt on Rt.

SUBDIVISION BLOCK / SECTION LOT LOT AREA 4.51 acres SITE CLASS. PS DESIGN FLOW 360 L.T.A.R. .33

Septic Tank: 1000 Gallons; STB 1012 Date 12-23-01
Pump Tank: Gallons; PT Date
Pump Make: Model Serial No.
Nitrification Field: No Fields 1 Square Feet 1080 Linear Feet 360
No Lines 4 Trench Width 36" Max Trench Bottom Depth 36" Gravel Depth 12"

[x] New System [ ] Repair System Type: I, II, III, IV, V, VI
System Description: Conv. Gravity
Repair System Description: " "
Maintenance Agreement Required: [ ] Yes [x] No


[ ] House/Mod. Home No. Bedrooms 3
[x] Mobile Home No. Bathrooms 2
[ ] Business No. Employees
[ ] Other
[ ] Slab [x] Crawl Space [ ] Basement w/plumbing [ ] Basement wo/plumbing

Water Supply: [x] Individual [ ] Public [ ] Community


Comments/Conditions:

Comments/Conditions: POLYLOK FILTER & MARKER

INITIAL SITE SKETCH

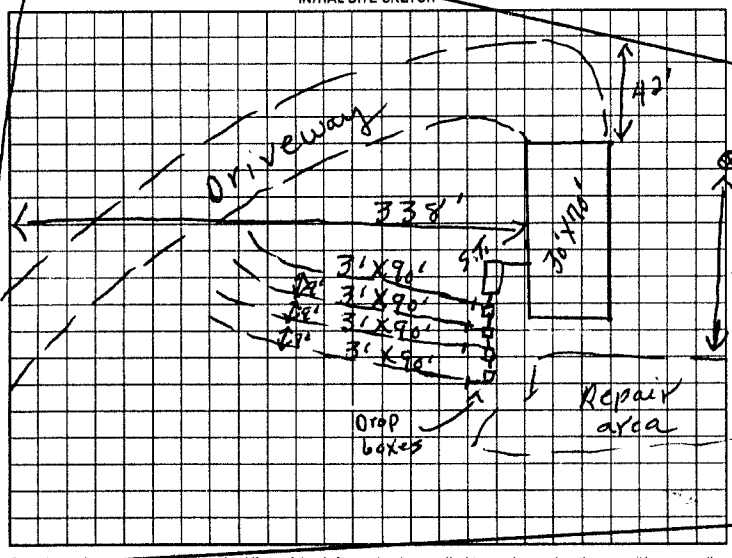

AS BUILT SKETCH

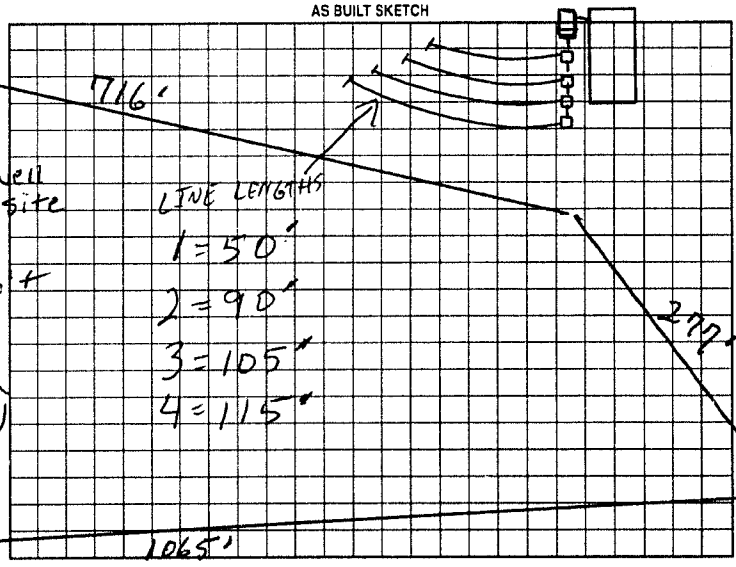

Permit can be suspended or revoked if any false information is supplied toward securing the permit/any unauthorized changes are made to the site/any unauthorized changes are made in the installation of the system. Improvement Permit with plat valid without expiration. Improvement Permit with site plan valid for sixty months. Authorization to Construct is valid for a period equal to that of Improvement Permit – not to exceed sixty months.

Signed: X [signature] date

Installed by: Tommy Pryce

Improvement Permit by: P-C-Moore date 3-24-99

Operation Permit by: [signature] date 5-17-02

Authorization to Construct by: P-C-Moore date 3-24-99

Existing System Inspection by: date

HEALTH DEPT. COPY: WHITE OWNER COPY (FINAL): YELLOW OWNER COPY (INITIAL): PINK