IREDELL COUNTY HEALTH DEPARTMENT

STATESVILLE 704-878-5305 130.00 Paid MOORESVILLE 704-664-5281

IMPROVEMENT PERMIT / AUTHORIZATION TO CONSTRUCT / OPERATION PERMIT / EXISTING SYSTEM INSPECTION

PERMIT# 120477 PIN# 3792-57-6957 DATE 5/13/04

OWNER OR CONTRACTOR BOYCE GALLIHER PHONE: Business 872-1047/902-7308 Home

ADDRESS 165 ASHLEY ACRES, STATESVILLE NC 28677

LOCATION HWY 70 WEST - TR ASHLEY ACRES - ON LT.

SUBDIVISION GALLIHER ESTATES BLOCK / SECTION LOT 1 LOT AREA 1.5AC SITE CLASS PS DESIGN FLOW 360GPD L.T.A.R. 1.36 GPD/FT2

Septic Tank: 1000 Gallons; STB 760 Date 3-22-04
Pump Tank: Gallons; PT Date
Pump Make: Model Serial No.
Nitrification Field: No Fields 1 Square Feet 900 Linear Feet 300
No Lines 3 @ 100' Trench Width 36" Max Trench Bottom Depth 36" Gravel Depth N/A

☑ New System ☐ Repair System Type: I, II, III, IV, V, VI
System Description: GRAVITY 25% REDUCTION
Repair System Description: LP PANEL
Maintenance Agreement Required: ☐ Yes ☑ No


☑ House/Mod. Home No. Bedrooms 3
☐ Mobile Home No. Bathrooms 2
☐ Business No. Employees
☐ Other
☐ Slab ☑ Crawl Space ☐ Basement w/plumbing ☐ Basement wo/plumbing

Water Supply: ☑ Individual ☐ Public ☐ Community

Comments:/Conditions:

Comments:/Conditions: ZABEL TEE / POLYLOK FILTER
INSTALLED AS DRAWN

1"=40' INITIAL SITE SKETCH

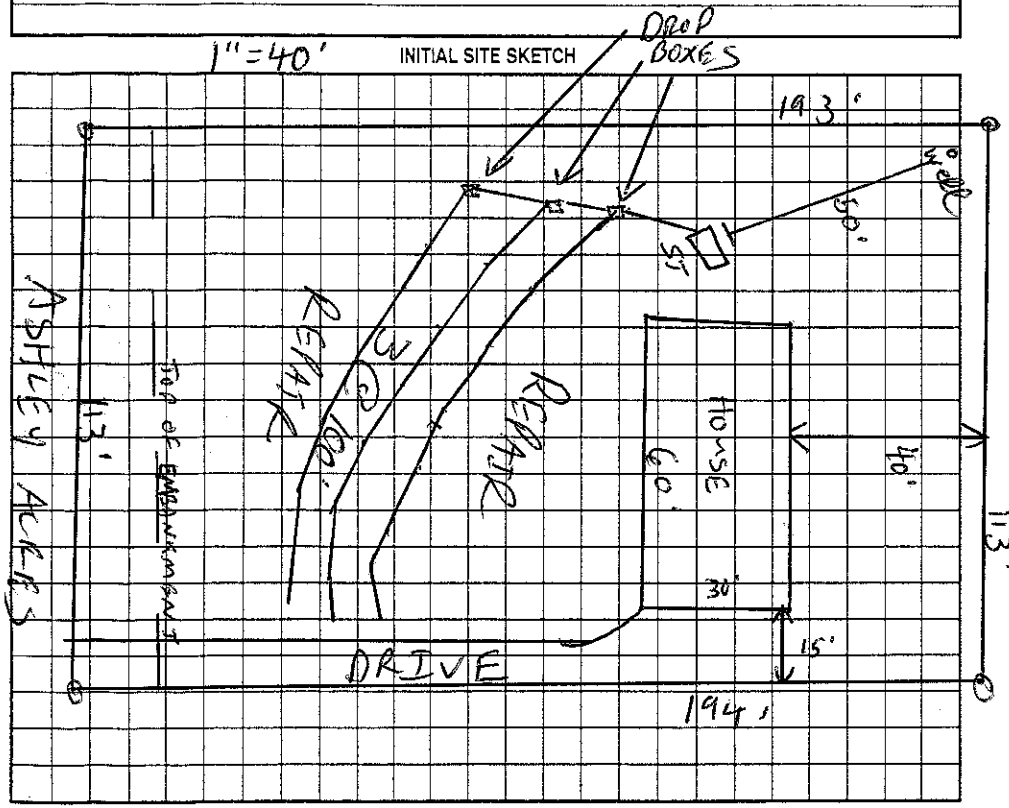

AS BUILT SKETCH

LEVEL 15' OFF 3' CUT EMBANKMENT CUT SHOT DROP BOXES & OUTLET LEVEL IS 6" ABOVE DISTRIBUTION CHAMBER. WILL RUN UP TO DROP BOX. DO NOT REMOVE ANY COVER OR [redacted] 6" COVER WILL NOT BE MAINTAINED. INSTALLED 300' OVER 4 CHAMBER. WARRANTY ATTACHED

Permit can be suspended or revoked if any false information is supplied toward securing the permit/any unauthorized changes are made to the site/any unauthorized changes are made in the installation of the system. Improvement Permit with plat valid without expiration. Improvement Permit with site plan valid for sixty months. Authorization to Construct is valid for a period equal to that of Improvement Permit – not to exceed sixty months.

Signed: Boyce Galliher date 5-14-04 Installed by: ABEE GRADING

Improvement Permit by: C. Gaskins RS date 5/13/04 Operation Permit by: [signature] date 8-11-04

Authorization to Construct by: C. Gaskins RS date 5/13/04 Existing System Inspection by: date

HEALTH DEPT. COPY: WHITE OWNER COPY (FINAL): YELLOW OWNER COPY (INITIAL): PINK