IREDELL COUNTY HEALTH DEPARTMENT

STATESVILLE 704-878-5305 MOORESVILLE 704-664-5281

IMPROVEMENT PERMIT / AUTHORIZATION TO CONSTRUCT / OPERATION PERMIT / EXISTING SYSTEM INSPECTION

130.00 Pd. 953 10D

PERMIT# 120479 PIN# 3792-55-5004 DATE 5/13/04

OWNER OR CONTRACTOR BOYCE GALLIHER PHONE: Business Home 872-1047

ADDRESS 165 ASHLEY ACRES RD STATESVILLE NC 28677

LOCATION 70 WEST - R ASHLEY ACRES - ON RT

SUBDIVISION GALLIHER ESTATES BLOCK / SECTION LOT 5 LOT AREA .54c SITE CLASS. PS DESIGN FLOW 360GPD L.T.A.R. .3600/1012

Septic Tank: 1000 Gallons; STB 825 Date 10-04

Pump Tank: Gallons; PT Date

Pump Make: Model Serial No.

Nitrification Field: No Fields 1 Square Feet 900 Linear Feet 300

No Lines 4@75' Trench Width 36" Max Trench Bottom Depth 36" Gravel Depth N/A

☑ New System ☐ Repair System Type: I, II, III, IV, V, VI

System Description: GRAVITY 25% REDUCTION

Repair System Description: GRAVITY PANEL

Maintenance Agreement Required: ☐ Yes ☑ No

☑ House/Mod. Home No. Bedrooms 3

☐ Mobile Home No. Bathrooms 2

☐ Business No. Employees

☐ Other

☐ Slab ☑ Crawl Space ☐ Basement w/plumbing ☐ Basement wo/plumbing


Water Supply: ☑ Individual ☐ Public ☐ Community

Comments:/Conditions:


DROP BOXES

Comments:/Conditions: MET OWNER/CUSTOMER. CHANGED SYSTEM TO 3x100', ONLY PUT ON 45x28 HOME & I FLAGGED OUT SYSTEM. OWNER AUTHORIZES REPAIR TO CHANGE TO LP PANEL REPAIR x Boyce Galliher

1"=40' INITIAL SITE SKETCH

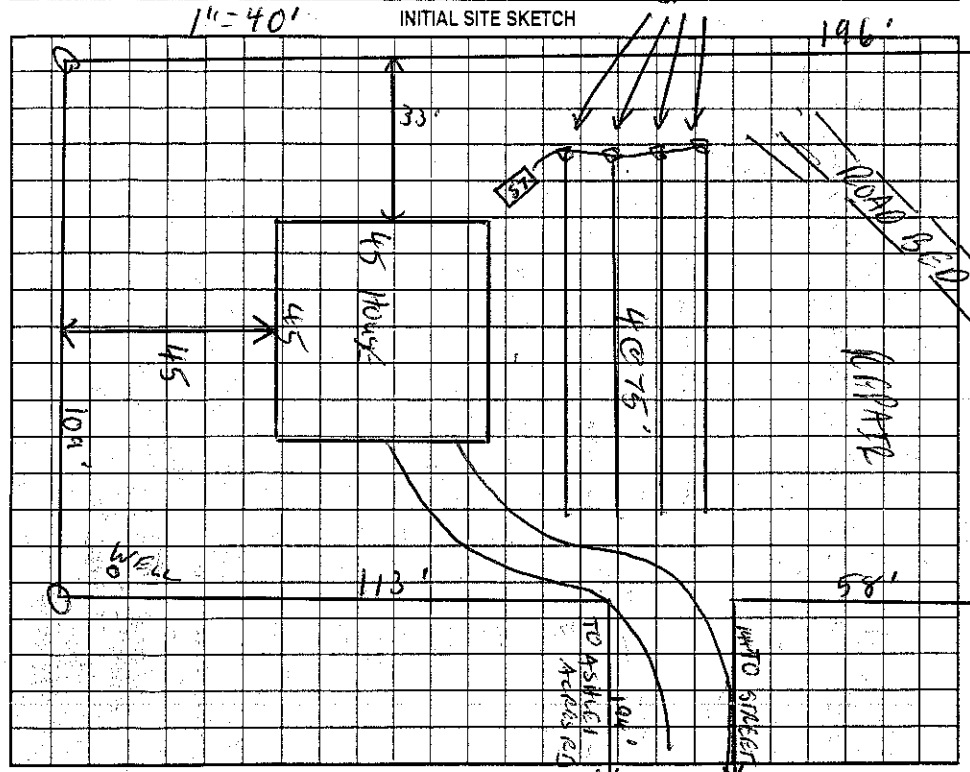

AS BUILT SKETCH SYSTEM 10' OFF P/L

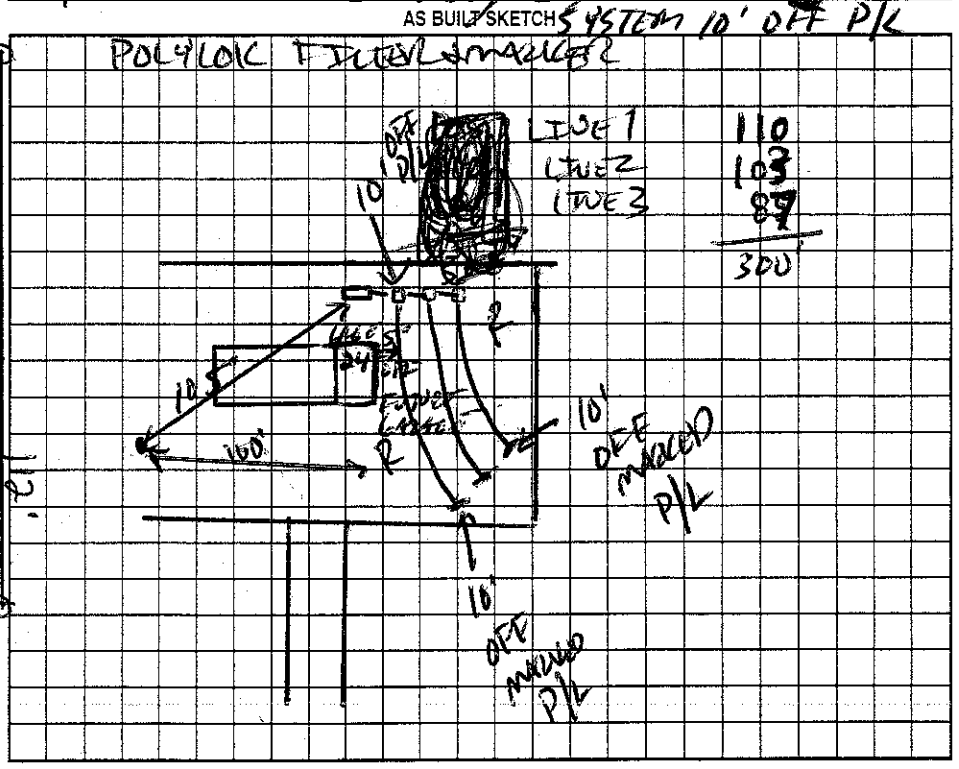

Permit can be suspended or revoked if any false information is supplied toward securing the permit/any unauthorized changes are made to the site/any unauthorized changes are made in the installation of the system. Improvement Permit with plat valid without expiration. Improvement Permit with site plan valid for sixty months. Authorization to Construct is valid for a period equal to that of Improvement Permit – not to exceed sixty months.

Signed: Boyce Galliher date 5-14-04

Improvement Permit by: C. Hayes RS date 5/13/04

Authorization to Construct by: C. Hayes RS date 5/13/04

Installed by: DOBS BACKHOE

Operation Permit by: J. Cook RS date 6-11-05

Existing System Inspection by: date

HEALTH DEPT. COPY: WHITE OWNER COPY (FINAL): YELLOW OWNER COPY (INITIAL): PINK