IREDELL COUNTY HEALTH DEPARTMENT

CI 130.00 Pg. 4

STATESVILLE 704-878-5305 MOORESVILLE 704-664-5281

IMPROVEMENT PERMIT / AUTHORIZATION TO CONSTRUCT / OPERATION PERMIT / EXISTING SYSTEM INSPECTION

PERMIT# 12078 PIN# 3792 586160 DATE 5/13/04

OWNER OR CONTRACTOR BOYCE GALLIHER PHONE: Business 872-1047 Home

ADDRESS 165 ASHLEY ACRES RD STATESVILLE NC 28677

LOCATION 70 WEST - TR ASHLEY ACRES - ON LT

SUBDIVISION GALLIHER ESTATES BLOCK / SECTION LOT 2 LOT AREA 1.54C SITE CLASS. PS DESIGN FLOW 360GPD L.T.A.R. ~~360~~ .35 gal/ft²

Septic Tank: 1000 Gallons; STB 1007 Date 8-9-05
Pump Tank: Gallons; PT Date
Pump Make: Model Serial No.
Nitrification Field: No Fields 1 Square Feet 780 Linear Feet 260
No Lines 4 Trench Width 36" Max Trench Bottom Depth 36" Gravel Depth

☑ New System ☐ Repair System Type: I, II, III, IV, V, VI
System Description: GRAVITY 25% REDUCTION
Repair System Description: REPAIR
Maintenance Agreement Required: ☐ Yes ☑ No


☑ House/Mod. Home No. Bedrooms 3
☐ Mobile Home No. Bathrooms 2
☐ Business No. Employees
☐ Other
☐ Slab ☑ Crawl Space ☐ Basement w/plumbing ☐ Basement wo/plumbing

Water Supply: ☑ Individual ☐ Public ☐ Community


Comments:/Conditions:

Comments:/Conditions: V.I.D TANK ONLY ON 10-6-05 - ZABEL F. Itw
62 INSTALLED DURING WET
70 SOIL CONDITIONS
70

INITIAL SITE SKETCH 1"=40'

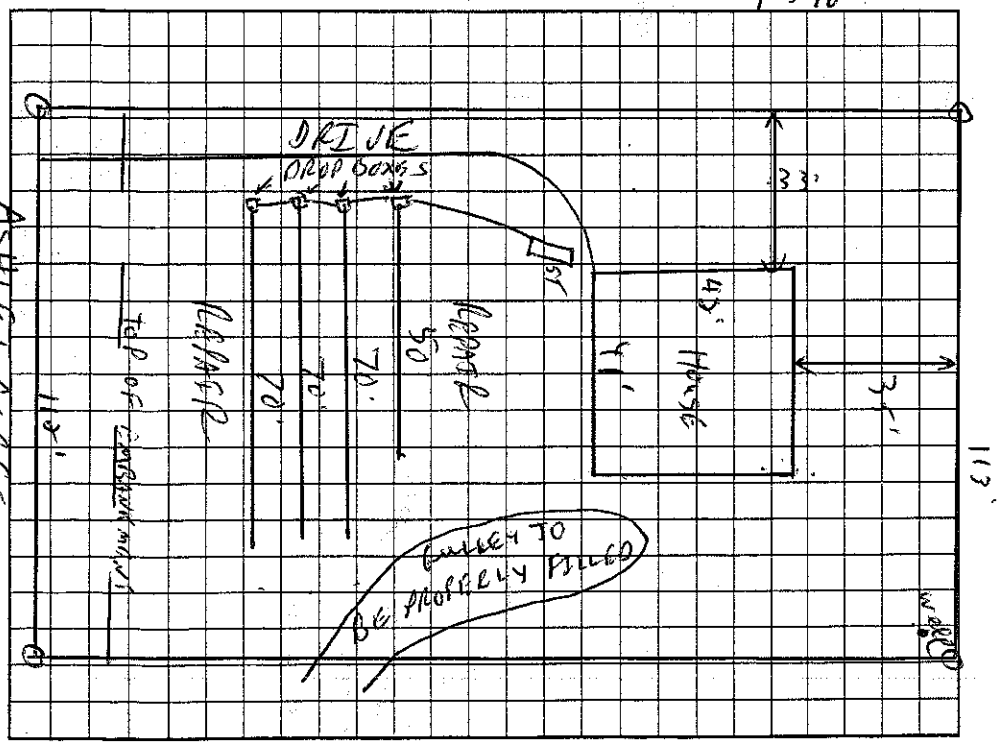

AS BUILT SKETCH

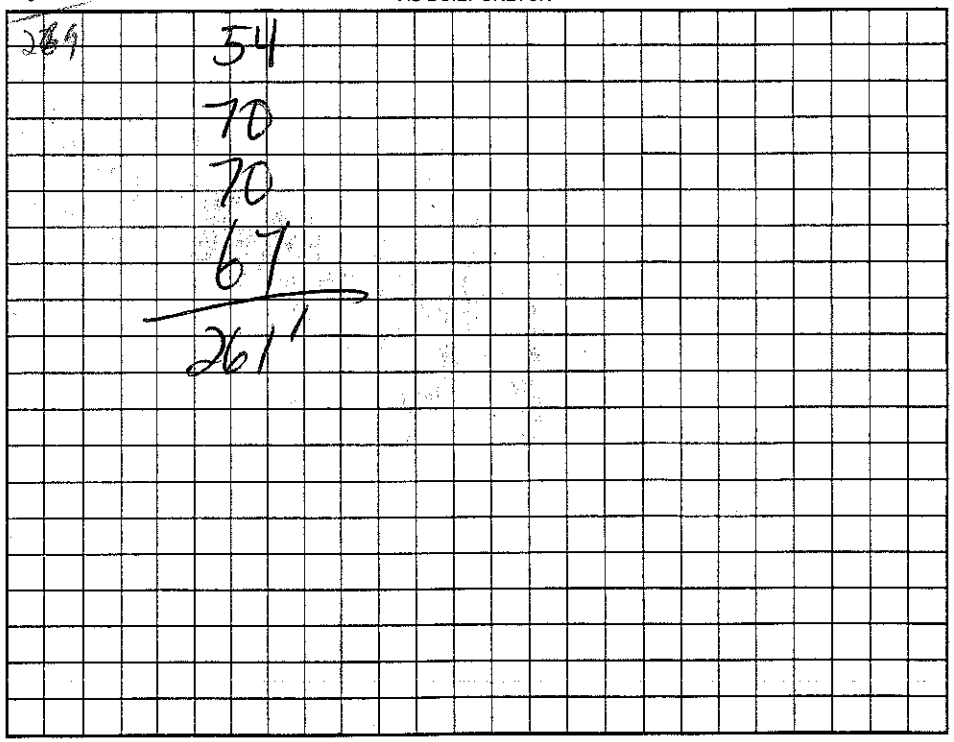

Permit can be suspended or revoked if any false information is supplied toward securing the permit/any unauthorized changes are made to the site/any unauthorized changes are made in the installation of the system. Improvement Permit with plat valid without expiration. Improvement Permit with site plan valid for sixty months. Authorization to Construct is valid for a period equal to that of Improvement Permit – not to exceed sixty months.

Signed: Boyce Galliher date 5-14-04
Improvement Permit by: date 5/13/04
Authorization to Construct by: date 5/13/04

Installed by: Tim Galliher Self Installed
Operation Permit by: date 10-18-05
Existing System Inspection by: date

HEALTH DEPT. COPY: WHITE OWNER COPY (FINAL): YELLOW OWNER COPY (INITIAL): PINK