# IREDELL COUNTY HEALTH DEPARTMENT

STATESVILLE 704-878-5305 MOORESVILLE 704-664-5281

## IMPROVEMENT PERMIT / AUTHORIZATION TO CONSTRUCT / OPERATION PERMIT / EXISTING SYSTEM INSPECTION

PERMIT# 12375D PIN# 3792-60-1484 JOHNNY MEREDITH DATE 5-8-05

OWNER OR CONTRACTOR STATESVILLE BRICK CO PHONE: Business 704-872-4123 Home

ADDRESS P.O. BOX 471 STATESVILLE, NC 28687

LOCATION TOWEST (L) BRICKYARD RD (R) GRAVEL RD (L) AT 1ST DRIVE ON TOP OF HILL BEHIND MH

SUBDIVISION BLOCK / SECTION LOT LOT AREA 94.94AC SITE CLASS PS DESIGN FLOW 975 L.T.A.R. .5

Septic Tank: 2000 Gallons; STB 653 Date 6-23-04
Pump Tank: 2000 Gallons; PT 96 Date 5-25-04
Pump Make: GOULDS Model [illegible] Serial No. 1PWE2016H.V
Nitrification Field: No Fields 1 Square Feet EQ=1083 Linear Feet 816
No Lines 6X136' Trench Width 36" Max Trench Bottom Depth 36" Gravel Depth N/A

[X] New System [ ] Repair System Type: I, II, [III], IV, V, VI
System Description: PUMP 250/6 REDUCT
Repair System Description: SAME
Maintenance Agreement Required: [ ] Yes [X] No

[ ] House/Mod. Home No. Bedrooms
[ ] Mobile Home No. Bathrooms
[X] Business No. Employees 39
[ ] Other FACTORY 39 EMPLOYEES
[X] Slab [ ] Crawl Space [ ] Basement w/plumbing [ ] Basement wo/plumbing

Water Supply:
[X] Individual
[ ] Public
[ ] Community
WELC

Comments:/Conditions: (1) FOLLOW PLANS SUBMITTED BY TONEY JAILORS & ASSOCIATES, INC FOR SYSTEM DESIGN; (2) INSTALL LINES ON CONTOURS & MAINTAIN SETBACKS

INITIAL SITE SKETCH

SEE TONY JAILORS ATTACHED PLAN

Comments:/Conditions: - TOFF TITE Filter & RMV/VENT @ 12"S FRS 5-14-05 LC
- 5-14-05 V'D LINES LC
NEEDS ELECTRICAL PRESSURE SET
-5-23-05 SET PRESSURE, NEEDS ELECTRICAL LC

AS BUILT SKETCH

Permit can be suspended or revoked if any false information is supplied toward securing the permit/any unauthorized changes are made to the site/any unauthorized changes are made in the installation of the system. Improvement Permit with plat valid without expiration. Improvement Permit with site plan valid for sixty months. Authorization to Construct is valid for a period equal to that of Improvement Permit – not to exceed sixty months.

Signed: [signature] date

Improvement Permit by: [signature] date 5-8-05


Authorization to Construct by: [signature] date 5-8-05


Installed by: A-1 BACKHOE

Operation Permit by: STEVE HEDRICK date 10/29/12

Existing System Inspection by: date

HEALTH DEPT. COPY: WHITE OWNER COPY (FINAL): YELLOW OWNER COPY (INITIAL): PINK

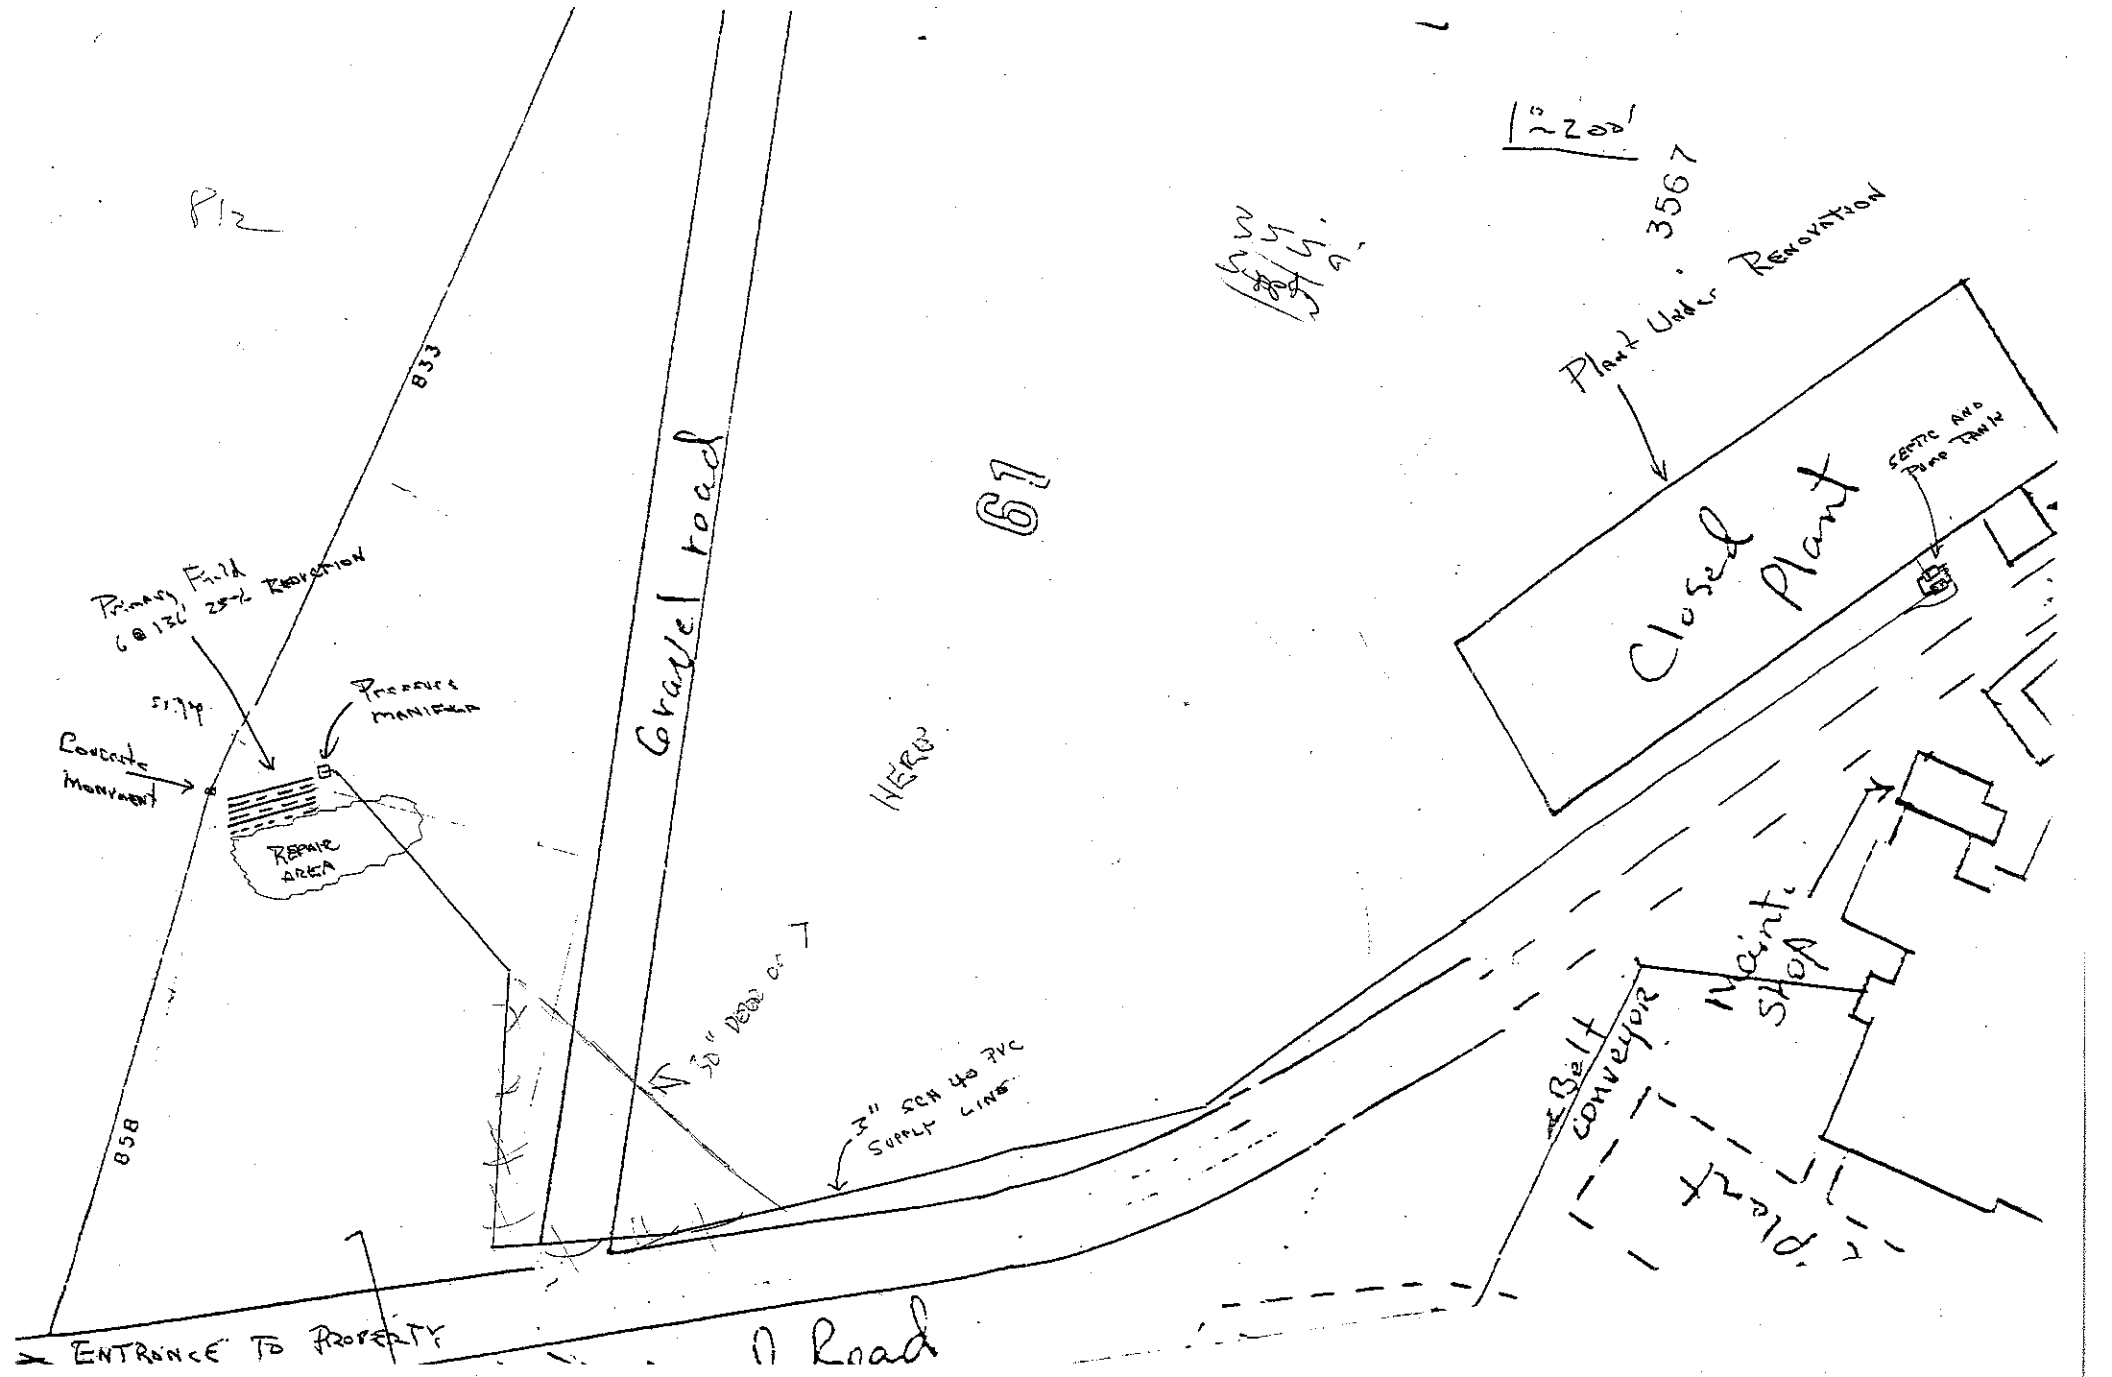
P12
833
Gravel road
61
HERE
Primary Field
Pressure Manifold
Repair Area
50' Deep Cut
3" SCH 40 PVC Supply Line
858
ENTRANCE TO PROPERTY
Road
Plant Under Renovation
Closed Plant
Septic and Pump Tank
Maint. Shop
Belt Conveyor
Yard
3567

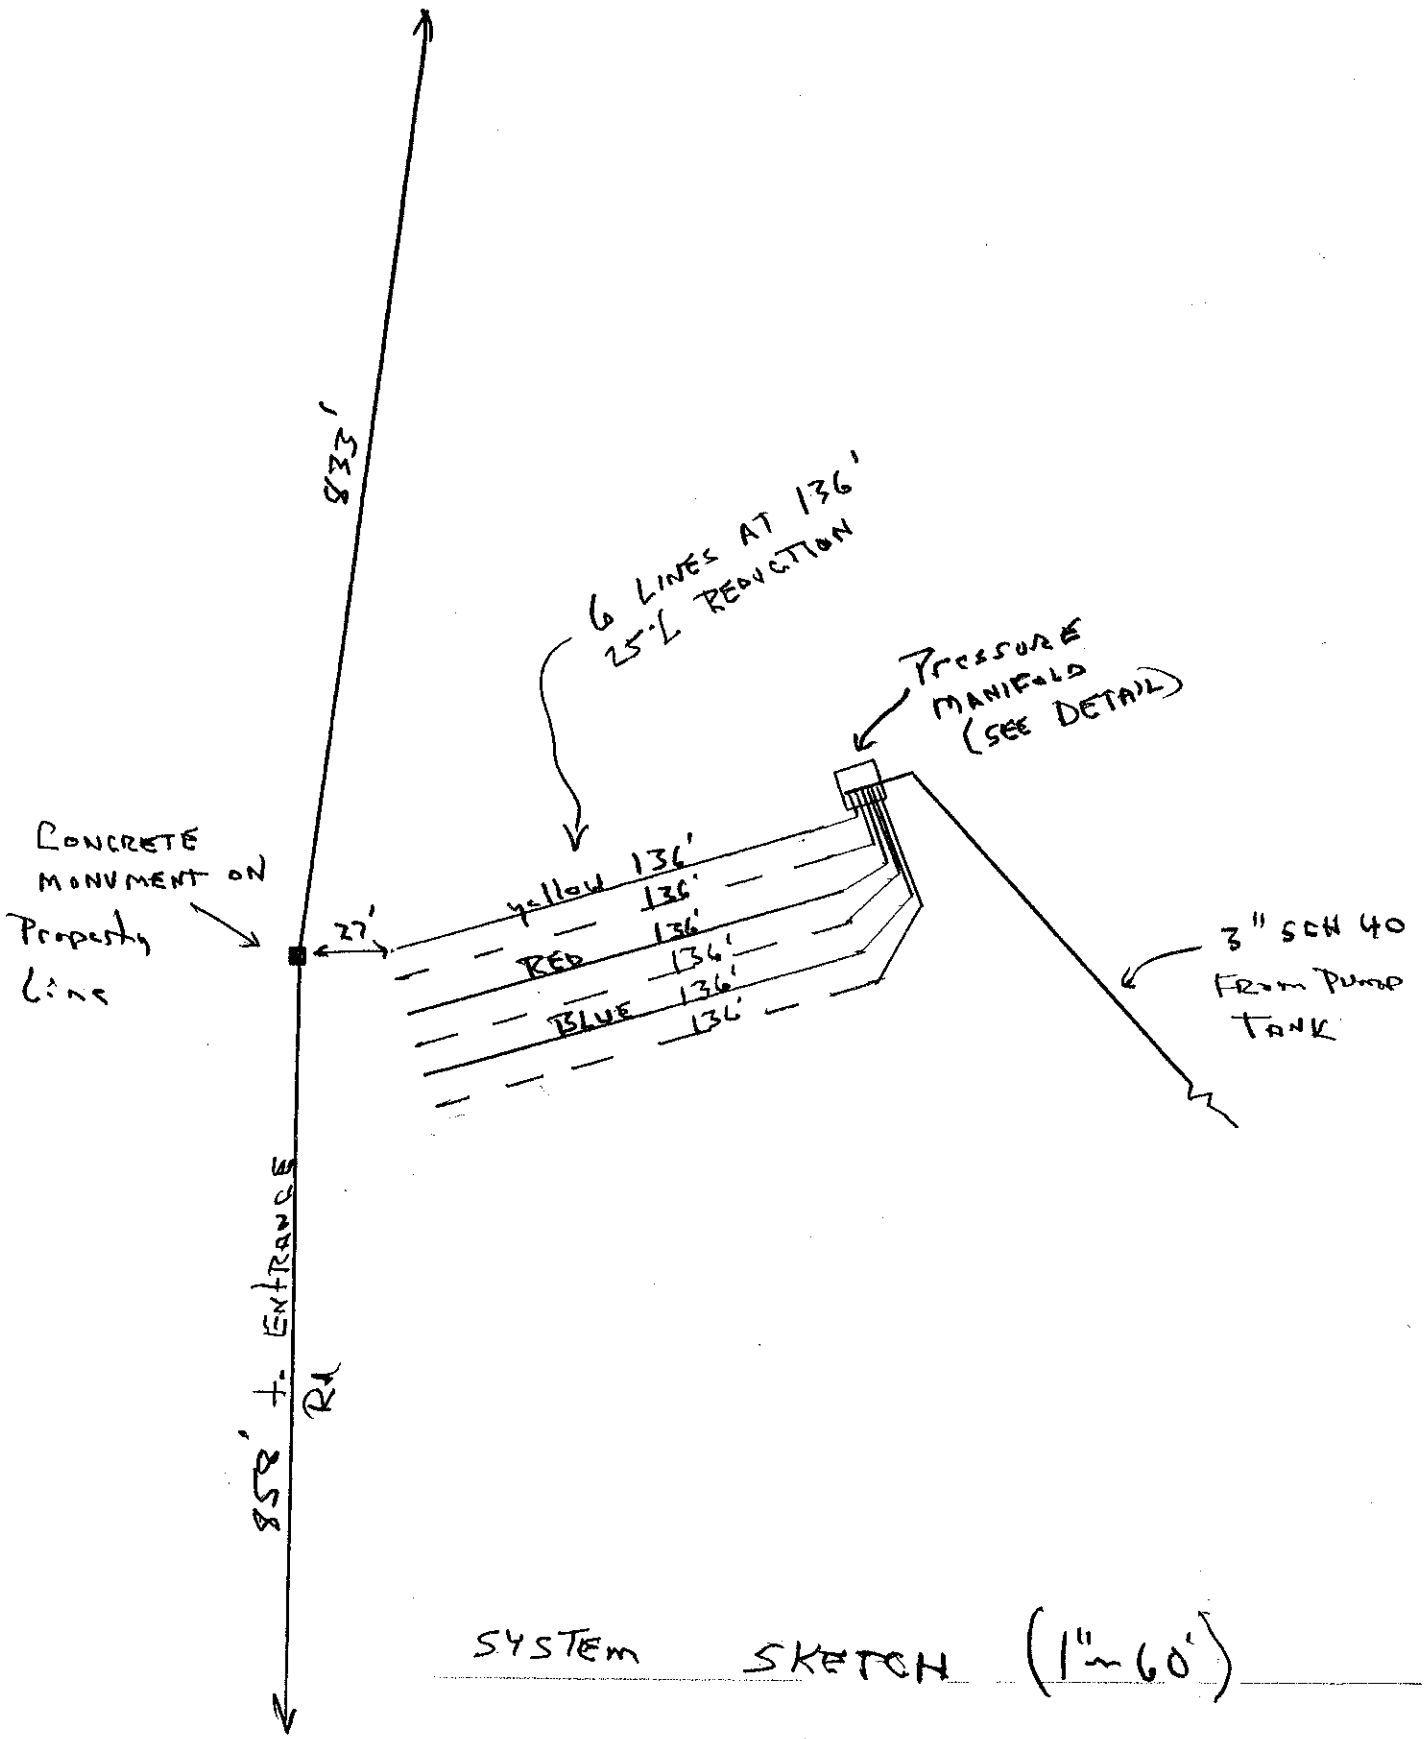


SYSTEM SKETCH (1" = 60')