IREDELL COUNTY HEALTH DEPARTMENT

STATESVILLE 704-878-5305 MOORESVILLE 704-664-5281 CI

IMPROVEMENT PERMIT / AUTHORIZATION TO CONSTRUCT / OPERATION PERMIT / EXISTING SYSTEM INSPECTION

PERMIT# 120005 PIN# 3792-60-1484.110 DATE 5/6/04

OWNER OR CONTRACTOR Statesville Brick Co. PHONE: Business (704) 872-4123 Home

ADDRESS P.O. Box 471 Statesville, N.C. 28687 (110 Red Brick Drive)

LOCATION Hwy 70 West, (L) Brick Yard Road 2nd mailbox on right before plant (L) on Red Brick Drive

SUBDIVISION — BLOCK / SECTION — LOT — LOT AREA 94.94 AC SITE CLASS Ex DESIGN FLOW 360 L.T.A.R. Ex

Septic Tank: Ex Gallons; STB Ex Date Ex
Pump Tank: Gallons; PT Date
Pump Make: Model Serial No.
Nitrification Field: No Fields Square Feet Linear Feet
No Lines Trench Width Max Trench Bottom Depth Gravel Depth

☐ New System ☐ Repair System Type: ☒ I, II, III, IV, V, VI
System Description: Gravity, Conventional
Repair System Description:
Maintenance Agreement Required: ☐ Yes ☐ No

☐ House/Mod. Home No. Bedrooms 3
☒ Mobile Home No. Bathrooms 2
☐ Business No. Employees
☐ Other

☐ Slab ☒ Crawl Space ☐ Basement w/plumbing ☐ Basement wo/plumbing

Water Supply: ☒ Individual ☐ Public ☐ Community


Comments:/Conditions:

Comments:/Conditions: System not in use at time of inspection. Septic System appears to be Okay. Maintain proper Setbacks.

INITIAL SITE SKETCH

(Ref. Permit #23202 3-7-96)

AS BUILT SKETCH

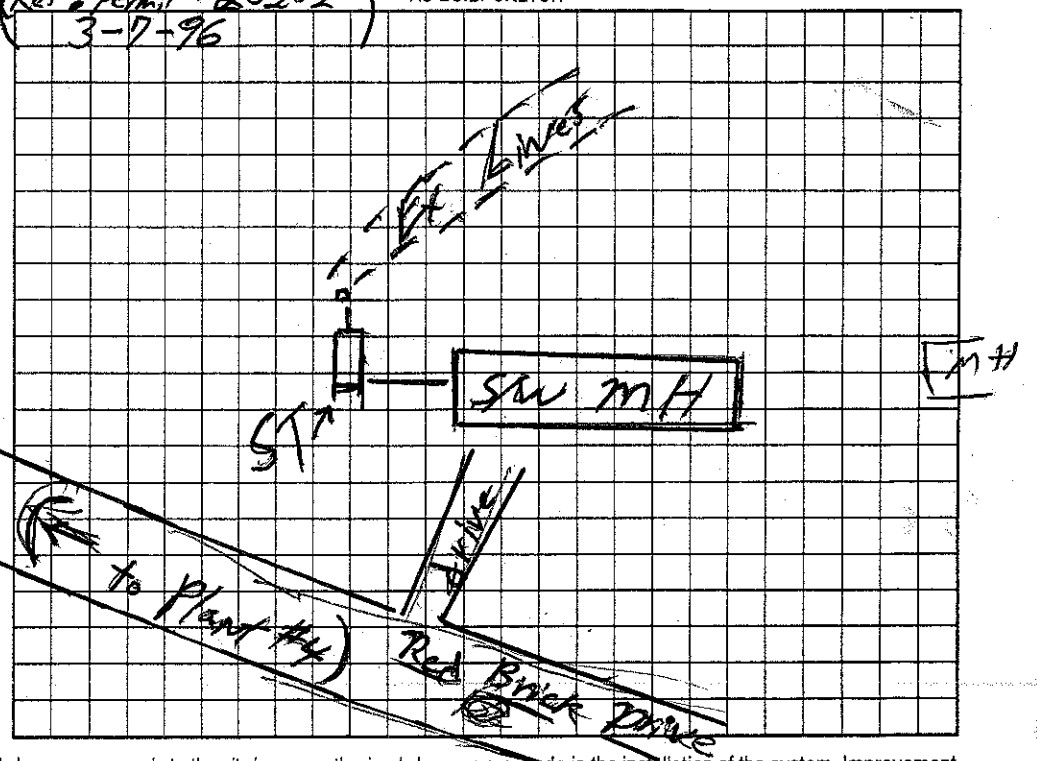

Permit can be suspended or revoked if any false information is supplied toward securing the permit/any unauthorized changes are made to the site/any unauthorized changes are made in the installation of the system. Improvement Permit with plat valid without expiration. Improvement Permit with site plan valid for sixty months. Authorization to Construct is valid for a period equal to that of Improvement Permit – not to exceed sixty months.

Signed: date

Improvement Permit by: date

Authorization to Construct by: date

Installed by:

Operation Permit by: date

Existing System Inspection by: William O. Johnson date 5/6/04

HEALTH DEPT. COPY: WHITE OWNER COPY (FINAL): YELLOW OWNER COPY (INITIAL): PINK