IREDELL COUNTY HEALTH DEPARTMENT

STATESVILLE 704-878-5305 MOORESVILLE 704-664-5281

IMPROVEMENT PERMIT / AUTHORIZATION TO CONSTRUCT / OPERATION PERMIT / EXISTING SYSTEM INSPECTION

PERMIT# 7683Z PIN# 3792637491 8786283 DATE July 26 99

OWNER OR CONTRACTOR RETA Hoover PHONE: Business ~~279-5435~~ Unique Home

ADDRESS 1211 Ascending Lane Statesville, NC

LOCATION Hwy 70 W (R) Brickyard Rd (L) AT Y, Waits Meadow (L) in curve on (R) Between ~~#1~~ 2nd + Third House

SUBDIVISION BLOCK / SECTION LOT LOT AREA 2.3 Ac. SITE CLASS PS DESIGN FLOW 360 L.T.A.R. 13

Septic Tank: 1000 Gallons; STB 825 Date 11-1 99
Pump Tank: Gallons; PT Date
Pump Make: Model Serial No.
Nitrification Field: No Fields 1 Square Feet 1200 Linear Feet 400
No Lines 3 @ 133 Trench Width 36" Max Trench Bottom Depth 36"

☒ New System ☐ Repair System Type: I (II) III, IV, V, VI
System Description: Conv. Gravity
Repair System Description: Same
Maintenance Agreement Required: ☐ Yes ☒ No
Gravel Depth 12" ☐ Slab ☒ Crawl Space ☐ Basement w/plumbing ☐ Basement wo/plumbing


☒ House/Mod. Home No. Bedrooms 3
☐ Mobile Home No. Bathrooms 2
☐ Business No. Employees
☐ Other

Water Supply: ☒ Individual ☐ Public ☐ Community
WELL


Comments/Conditions: Install on Contour. Well 100ft or Max Feasible Distance from System

Comments/Conditions

INITIAL SITE SKETCH

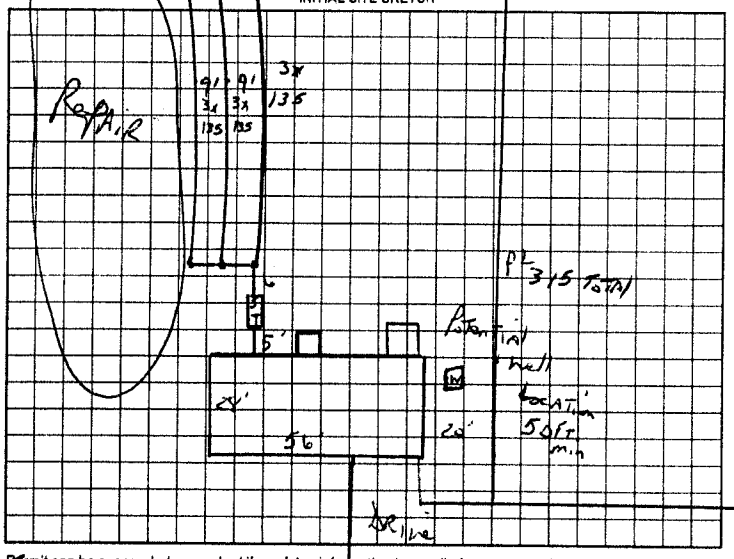

AS BUILT SKETCH

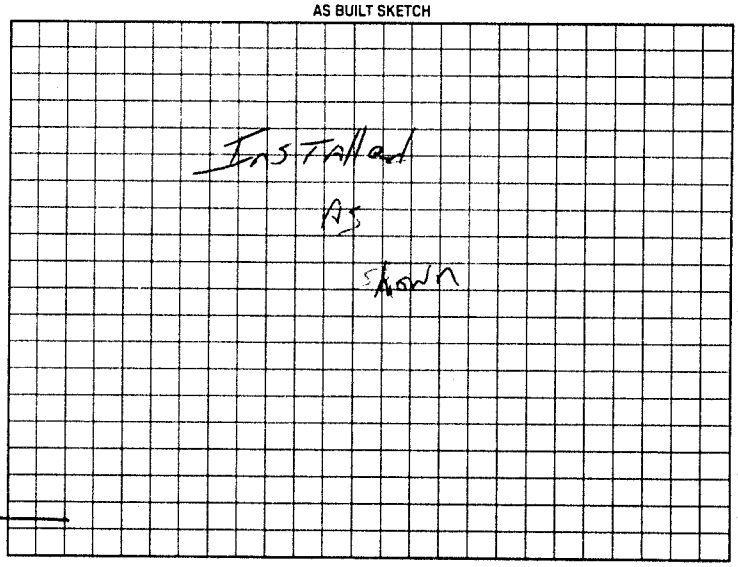

~~Permit can be suspended or revoked~~ if any false information is supplied toward securing the permit/any unauthorized changes are made to the site/any unauthorized changes are made in the installation of the system. Improvement Permit with plat valid without expiration. Improvement Permit with site plan valid for sixty months. Authorization to Construct is ~~valid for a period equal to~~ that of Improvement Permit - not to exceed sixty months.

Signed: [signature] date 7-26-99 Installed by: HE Houston

Improvement Permit by: J.C. Potter date 7.26.99 Operation Permit by: J.C. Potter date 12-23-99

Authorization to Construct by: J.C. Potter date 7.26.99 Existing System Inspection by: date

HEALTH DEPT COPY: WHITE OWNER COPY (FINAL) YELLOW OWNER COPY (INITIAL) PINK