IREDELL COUNTY HEALTH DEPARTMENT

Statesville Office (704) 878-5305 Mooresville Office (704) 660-3625 (BB)

PERMIT # 244584

PIN # 3792647854

SEPTIC IMPROVEMENT PERMIT / AUTHORIZATION TO CONSTRUCT / OPERATION PERMIT / EXISTING SYSTEM

APPLICANT/OWNER: Lou Ann Watts

APPLICANT ADDRESS: 182 Eufola Rd Statesville 28677

SITE ADDRESS: 182 Eufola Rd Statesville NC 28677

PHONE: 704-380-2401

ALT. PHONE

SITE DIRECTIONS: Hwy 70 W L on Eufola Rd 182 on R

SAP CONTROLLED: ☐ YES ☐ NO

SUBDIVISION: -

SECTION: - LOT # - LOT AREA: 0.64 Acre

DESIGN FLOW: 240 gpd L.T.A.R.: Existing

Septic Tank 1000 (gal) STB Infiltrator Date

Pump Tank (gal) PT Plastic Date tank

Pump Make Model Serial #

Nitrification Fields N/A # Lines Linear Ft

Trench Width N/A Trench Bottom Depth(Low side) Gravel Depth

☐ New System ☒ Repair ☐ Expansion System Type: I II III IV V VI

System Description: Tank

Repair System Description:

Maintenance Agreement Required: ☐ YES ☒ NO

☐ GRAVITY ☐ PRESSURE

☒ Residence No. Bedrooms 2

☐ Business No. Persons 4

☐ Other No. Employees

☐ Slab ☒ Crawl Space


☐ Basement w/plumbing ☐ Basement w/o plumbing

Water Supply: ☑ Private ☐ Public ☐ Community

Comments / Conditions: Pump Crush and fill old tank.

ST - 7FT to house

INITIAL SITE SKETCH

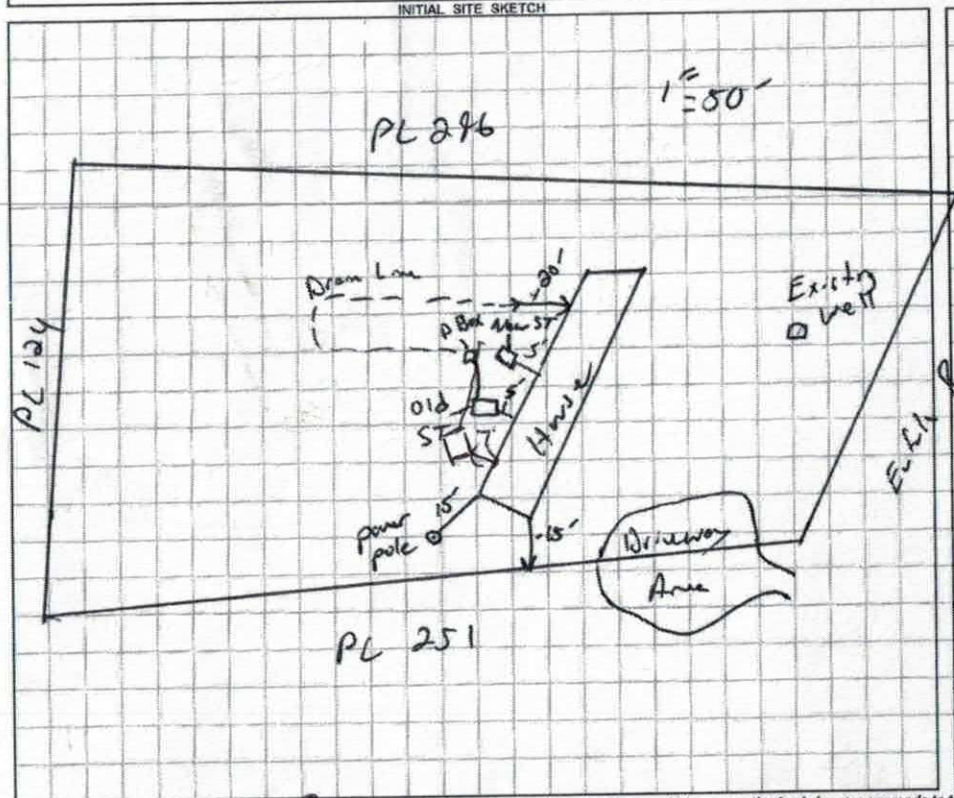

AS BUILT SKETCH

5/28/19 Traced PVC pipe to black Corrugated pipe for drainfield

Permit can be suspended or revoked if any false information is supplied toward securing the permit / any unauthorized changes are made to the site / any unauthorized changes are made in the installation of the system. **CONTACT A LOCATOR SERVICE PRIOR TO ANY EXCAVATION**

☐ **IMPROVEMENT PERMIT** *with plat valid without expiration.* ☐ **IMPROVEMENT PERMIT** *with site plan valid for 60 mos.* ☐ **AUTHORIZATION TO CONSTRUCT** *valid for period equal to IMPROVEMENT PERMIT--not to exceed 60 mo.*

Owner / Applicant Signature: Lou Ann Watts Date: 5-15-19

IMPROVEMENT PERMIT by: Date: 5-14-19

AUTHORIZATION TO CONSTRUCT by: Date: 5-14-19

Installed by: Carolina Septic Pro

OPERATION PERMIT by: Date: 5/28/19

Existing System Inspected by: Date:

FOR SEPTIC FINAL INSPECTION: CALL 704-664-3703 between 8am-9am the day the inspection is needed. Be sure to speak with an inpsector to confirm your inspection time.

RECEIVED MAY 1 3 2019

IREDELL COUNTY DEPARTMENT of ENVIRONMENTAL HEALTH

APPLICATION FORM #244584 Rpr Evaluation-No Chg

Application For: ( ) New Well Permit ( ) Well Repair Permit ( ) Well Abandonment
( ) Septic Improvement Permit ( ) Authorization to Construct ( ) Existing System Inspection (✓) Septic System Repair

THE ABOVE PERMIT DOCUMENTS WILL BECOME INVALID IF INFORMATION PROVIDED ON THIS APPLICATION IS FALSIFIED OR CHANGED, OR IF THE SITE IS ALTERED. THE IMPROVEMENT PERMIT IS VALID FOR EITHER 60 MONTHS OR WITHOUT EXPIRATION DEPENDING UPON DOCUMENTATION SUBMITTED. APPLICATION WITH SITE PLAN 60 MONTHS, APPLICATION WITH COMPLETE, SCALED PLAT WITHOUT EXPIRATION. SEE 15A NCAC 18A .1937(f) FOR DETAILS.

Page 2: *Site Plan Worksheet* form MUST accompany this application

The following optional attachments may also be submitted: ( ) Survey Plat, scaled no more than 1 inch = 60 feet
Place an (X) beside whichever is submitted if applicable ( ) Custom Site Plan, scaled no more than 1 inch = 60 feet

Applicant Information: **(PRINT CLEARLY)**

Applicant Name: LouAnn Watts **Address:** 182 Eufola Rd. Statesville NC **Zip:** 28677
Applicant Email: wattscarla1969@yahoo.com **Phone:** 704-380-2401 **Alt. Phone:** 704-252-3183
Owner Name: _____ **Address:** _____ **Zip:** _____
Owner Email: _____ **Phone:** _____ **Alt. Phone:** _____

Property Information:

Street Address: 182 Eufola Road Statesville, NC 28677
Subdivision Name: _____ **Section/Phase:** _____ **Lot Number:** _____
Driving Directions: _____

Site Development Information: ***(check or complete ALL that apply*** LAW 3/2

CHECK FOUNDATION TYPE

( ) New Single Family Residence — Maximum Number of Bedrooms: _____ — ( ) Crawl Space Foundation
( ) New Multi-Family Residence — Maximum Number of Occupants: _____ — (✓) Concrete Slab Foundation
( ) Accessory Building — ( ) Swimming Pool — ( ) Basement with Plumbing
( ) Bedroom(s) Addition — ( ) Other Addition/Structure: _____ — ( ) Basement without Plumbing
(✓) Repair to failing septic system ___ Tank ✓ Drain lines Describe Problem: Surfacing after pumping tank
Non-Residential Site Development: Type of Business: _____
Square Footage of Building: _____ **Max. Number of Employees:** _____ **Max. Number of Seats/Beds/Other:** _____

Water Supply: ( ) Replacement Well – Reason: _____
( ) Multi-connection Well **Number of Houses:** _____ **Number of Persons:** _____

( ) New Well ( ) Existing Well ( ) Community Well ( ) City Water ( ) Other Public Water

Desired Septic System Type: ***(you may rank in order of preference)*** **Year existing system installed:** _____
( ) No Preference ( ) Alternative ( ) Conventional ( ) Innovative ( ) Modified Conventional ( ) Other: _____

Please answer the following to the best of your ability:
( ) Yes (✓) No **Does the site contain any jurisdictional wetlands?**
( ) Yes (✓) No **Is any non-domestic sewage (i.e. industrial) to be generated?**
( ) Yes (✓) No **Is the site subject to approval by any other public agency?**

I have read this application and certify that the information provided herein is true, complete, and correct. Authorized county and state officials are granted right of entry to conduct necessary inspections to determine compliance with applicable laws and rules. I understand that I am solely responsible for the proper identification and labeling of all property lines and corners and making the site accessible so that a complete site evaluation can be performed.

Signature: LouAnn Watts — 5-13-19
Property owner or owner's legal representative signature (SIGNATURE REQUIRED) **DATE**

DOCUMENTATION TO AUTHORIZE AN OWNER'S LEGAL REPRESENTATIVE

Applications for permits require the "signature of the owner or owner's legal representative" (15A NCAC 18A .1937). If the owner does not sign the application himself or herself, they can submit any one of the following documents to designate their legal representative:

Power of Attorney; Real Estate Contract; Estate executor; Bankruptcy trustee; Court ordered guardianship

In the absence of the above documentation, the property owner may provide the local health department with documentation that designates a legal representative. A property owner may:

Complete this form to document his or her legal representative, or provide his or her own form that contains the information in this form.

If there are multiple property owners, then all property owners must sign the form that designates a legal representative.

By signing a form that designates a legal representative for purposes of 15A NCAC 18A .1937, the property owner authorizes that representative to act on their behalf in matters pertaining to the application and permitting process, including signing or receiving any application, document or permit. The owner retains full responsibility to meet all permit conditions specified by the local health department.

I, Lou Ann Watts, am the legal owner(s) of the property located at 182 Eufola Road Statesville NC 28677, identified as PIN (Parcel Identification Number) _____, located in Iredell County, North Carolina.

I do hereby authorize (**print legal representative/company name**) Carla Watts, _____, to act as an agent on my behalf in applying for/signing/obtaining any of the documents described below.

- Application for Improvement Permit (IP) / Authorization to Construct (AC)
- Improvement Permit (IP) / Authorization to Construct (AC)
- Application for soil-site evaluation (new/repair)
- Application/permit for private drinking water well/well abandonment
- Application for Compliance Inspection

I agree to abide by all decisions and/or conditions between the legal representative acting on my behalf and the Iredell County Department of Public Health, Environmental Health Division.

Lou Ann Watts 5-13-19 Carla Watts 5/13/19

Signature of Owner(s) Date Signature of Witness Date

Please return this signed form to the appropriate office:

Mooresville - Environmental Health
ronda.hart@co.iredell.nc.us
Fax: 704-662-3239
610 E. Center Avenue, Mooresville, NC 28115

Statesville - Environmental Health
adrienne.shea@co.iredell.nc.us
Fax: 704-871-3483
349 N. Center Street, Statesville, NC 28677


IREDELL COUNTY DEPARTMENT of ENVIRONMENTAL HEALTH

SITE PLAN WORKSHEET

SEE THE "SAMPLE SITE PLAN" BELOW. *INCOMPLETE SITE PLANS WILL BE RETURNED TO YOU FOR COMPLETION AND MAY RESULT IN A DELAY IN THE ISSUANCE OF YOUR SEPTIC SYSTEM OR WELL PERMIT!!!*

Place an (X) beside each item as you complete the site plan:

- **( ) Property Line measurements are clearly identified**
- **( ) All proposed structures are indicated**
- **( ) Front and side setbacks from property line**
- **( ) Preferred driveway location**
- **( ) Preferred well location**
- **( ) Preferred septic system location**
- **( ) North arrow, or other sufficient indicator of direction**

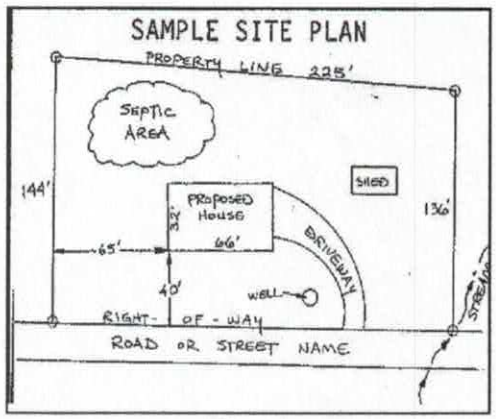


Circle N/A on the following if appropriate:

Location of septic systems and wells within 100' of your property	**N/A**
Location of easements and rights of ways on your property	**N/A**
Location of any designated wetlands on the property	**N/A**

USE THIS SPACE TO DRAW YOUR SITE PLAN

Show: proposed house or business footprint, wells, water lines, patios, pools and decks, and any other item that will occupy space on the site

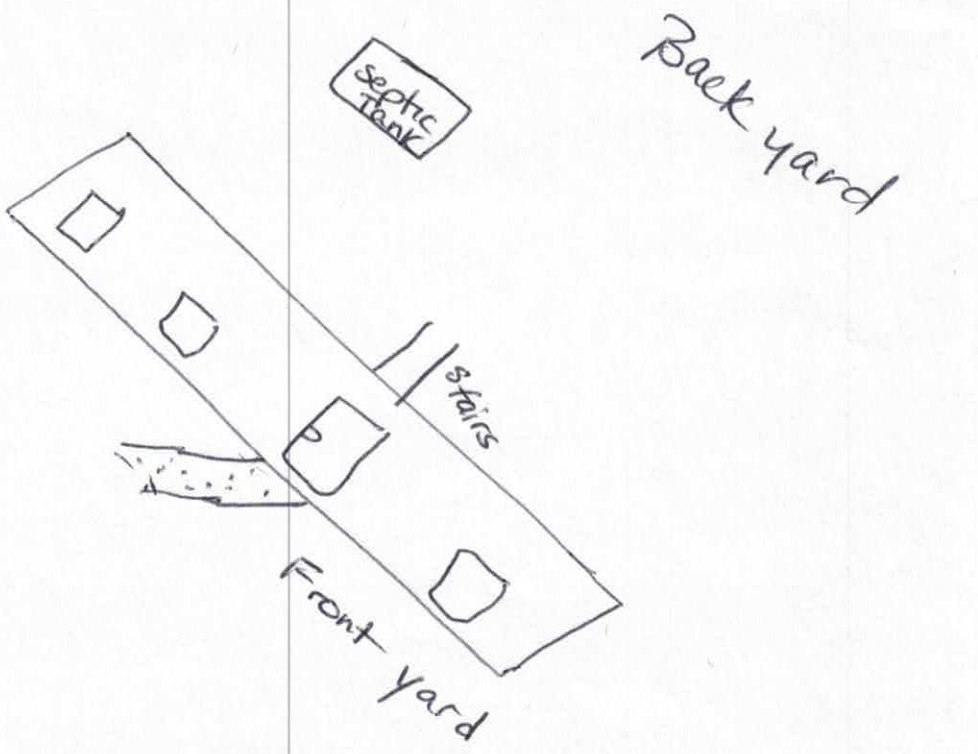

Signature: Lou Ann Watts

Property owner or owner's legal representative signature (SIGNATURE REQUIRED)

5-13-19

DATE

IREDELL COUNTY HEALTH DEPARTMENT

Statesville Office (704) 878-5305 Mooresville Office (704) 660-3625 PERMIT # 231660

SEPTIC IMPROVEMENT PERMIT / AUTHORIZATION TO CONSTRUCT / OPERATION PERMIT / EXISTING SYSTEM

PIN # 3792647854

APPLICANT/OWNER: Oakwood Homes of Newton/Loamy APPLICANT ADDRESS: 1265 U.S. Hwy 70 W Hickory NC 28603.

SITE ADDRESS: 182 Enfola RD - Statesville NC 28677. PHONE: 828 464 2662 ALT. PHONE ~


SITE DIRECTIONS: Sharon School RD TL on Hwy 70 TR on Enfola RD. SAP CONTROLLED: ☐ YES ☒ NO

SUBDIVISION: ~ SECTION: ~ LOT # ~ LOT AREA: 0.64 Acres. DESIGN FLOW: 240 gpd L.T.A.R.: Existing

Septic Tank: Existing (gal)	STB: Ext	Date: Ext	☐ New System ☐ Repair ☐ Expansion	System Type: I (II) III IV V VI	☒ Residence	No. Bedrooms: 2	Water Supply: ☒ Private
Pump Tank: ~ (gal)	PT: ~	Date: ~	System Description: Existing		☐ Business	No. Persons: 4	☐ Public
Pump Make: ~	Model: ~	Serial #: ~	Repair System Description: Existing		☐ Other	No. Employees:	☐ Community
# Nitrification Fields: 1	# Lines: 1	Linear Ft: 100	Maintenance Agreement Required: ☐ YES ☒ NO		☐ Slab	☒ Crawl Space	
Trench Width: Ext	Trench Bottom Depth(Low side): Ext		Gravity Depth: Ext	☒ GRAVITY ☐ PRESSURE	☐ Basement w/plumbing	☐ Basement w/o plumbing	

Comments / Conditions: Existing System for 2 BR House only

INITIAL SITE SKETCH

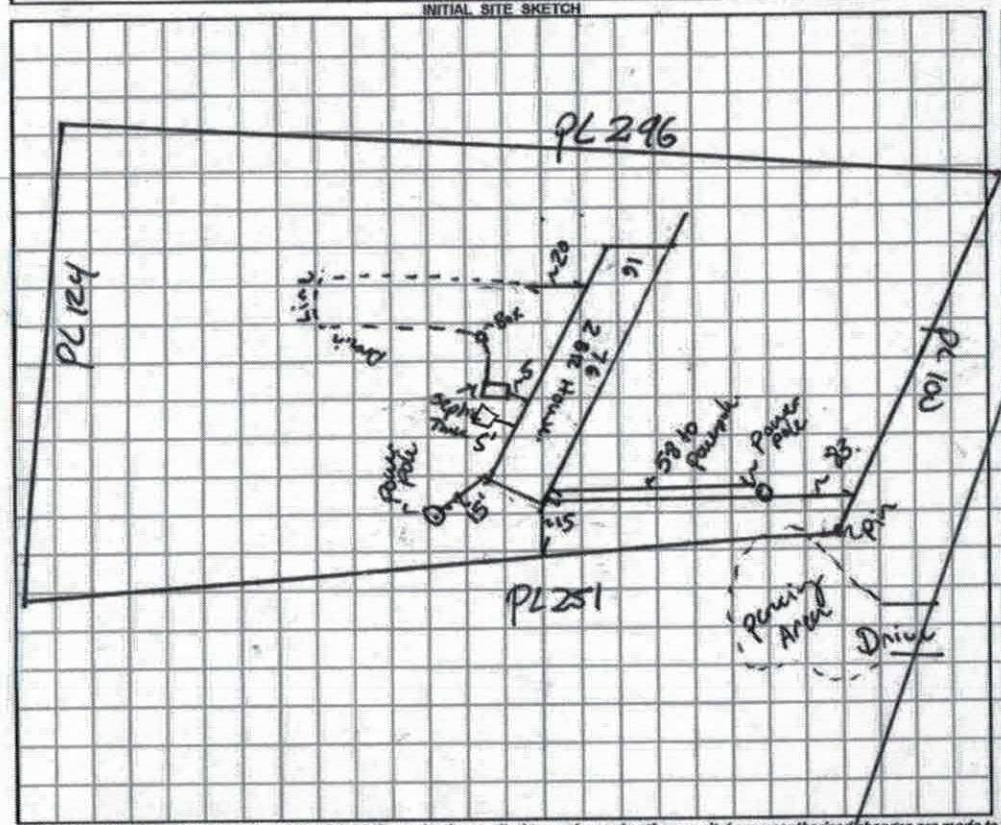

AS BUILT SKETCH

1"=50'

Permit can be suspended or revoked if any false information is supplied toward securing the permit / any unauthorized changes are made to the site / any unauthorized changes are made in the installation of the system. CONTACT A LOCATOR SERVICE PRIOR TO ANY EXCAVATION

☐ IMPROVEMENT PERMIT with plat valid without expiration. ☐ IMPROVEMENT PERMIT with site plan valid for 60 mos. ☐ AUTHORIZATION TO CONSTRUCT valid for period equal to IMPROVEMENT PERMIT--not to exceed 60 mo.

Owner / Applicant Signature: Bobby Jackson Date: 12/6/17 Installed by:

IMPROVEMENT PERMIT by: Date: OPERATION PERMIT by: Date:

AUTHORIZATION TO CONSTRUCT by: Date: Existing System Inspected by: Benjamin A Bolton Date: 12/4/2017