IREDELL COUNTY HEALTH DEPARTMENT

STATESVILLE 704-878-5305 MOORESVILLE 704-664-5281

IMPROVEMENT PERMIT / AUTHORIZATION TO CONSTRUCT / OPERATION PERMIT / EXISTING SYSTEM INSPECTION

PERMIT# Repair PIN# DATE 7-1-98

OWNER OR CONTRACTOR Elizabeth Smith PHONE: Business Home

ADDRESS 135 Eufola Rd Statesville

LOCATION TOW TL Eufola 2nd house on left

SUBDIVISION BLOCK / SECTION LOT LOT AREA SITE CLASS. DESIGN FLOW 360 L.T.A.R.

Septic Tank: 1000Ex Gallons; STB Date

Pump Tank: Gallons; PT Date

Pump Make: Model Serial No

Nitrification Field: No Fields Square Feet Linear Feet

No Lines Trench Width 6ft Max Trench Bottom Depth Gravel Depth 24in

☐ New System ☒ Repair System Type: I, ☒ II, III, IV, V, VI

System Description:

Repair System Description: Gravity Bed

Maintenance Agreement Required: ☐ Yes ☐ No

☒ House/Mod. Home No. Bedrooms 3

☐ Mobile Home No. Bathrooms 2

☐ Business No. Employees

☐ Other

☐ Slab ☐ Crawl Space ☐ Basement w/plumbing ☒ Basement wo/plumbing


Water Supply: ☐ Individual ☒ Public ☐ Community

Comments:/Conditions

Replace 6 x 30ft section of Bed, replace Drain Lines, Remove tree Check sanitary T replace if needed


Comments:/Conditions:

INITIAL SITE SKETCH

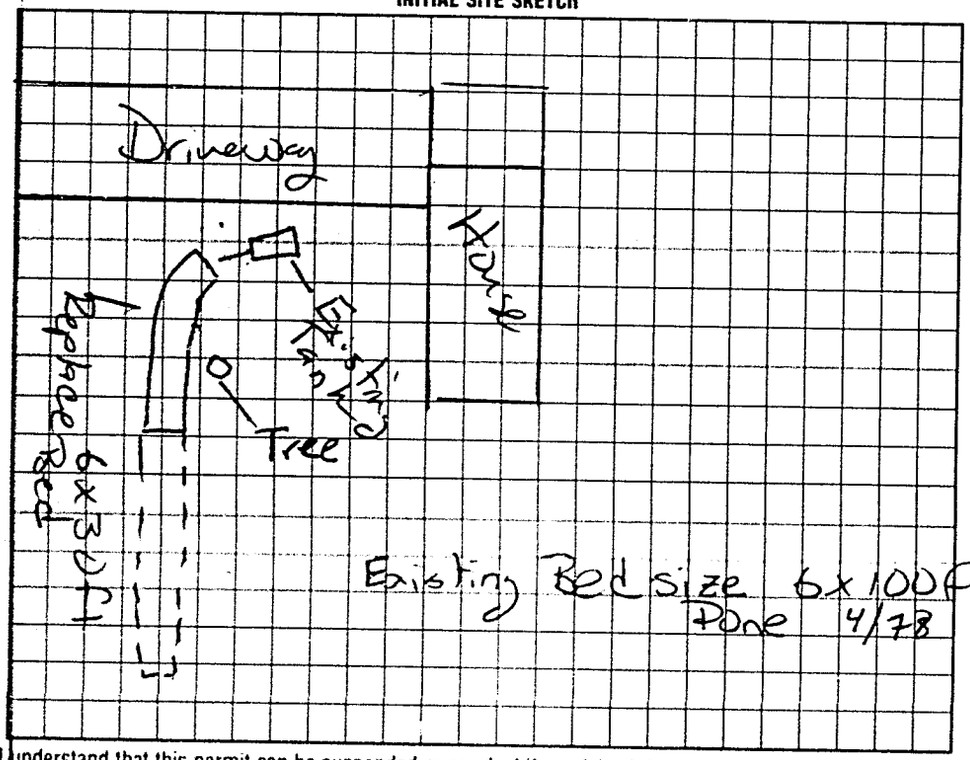

Existing Bed size 6x100ft Done 4/78

AS BUILT SKETCH

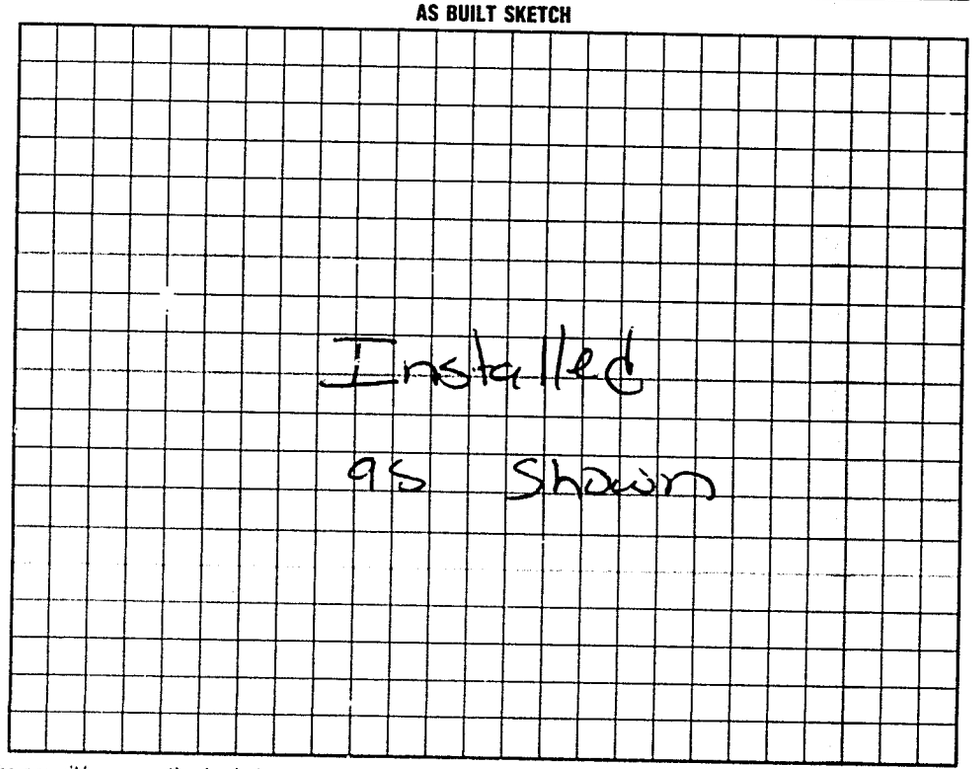

I understand that this permit can be suspended or revoked if any false information is supplied toward securing the permit/any unauthorized changes are made to the site/any unauthorized changes are made in the installation of the system. Improvement Permit with plat valid without expiration. Improvement Permit with site plan valid for sixty months. Authorization to Construct is valid for a period equal to that of Improvement Permit – not to exceed sixty months.

Signed: Elizabeth Smith date

Improvement Permit by: Mark Coffers date 7-1-98

Authorization to Construct by: Mark Coffers date 7-1-98

Installed by: James Hadler

Operation Permit by: Mark Coffers date 7-15-98

Existing System Inspection by date

HEALTH DEPT. COPY: WHITE INSPECTION COPY (FINAL): GREEN OWNER COPY (FINAL): YELLOW INSPECTION COPY (INITIAL): PINK OWNER COPY (INITIAL): GOLD

0 2 0 0