IREDELL COUNTY HEALTH DEPARTMENT

STATESVILLE 704-878-5305 MOORESVILLE 704-664-5281

IMPROVEMENT PERMIT / AUTHORIZATION TO CONSTRUCT / OPERATION PERMIT / EXISTING SYSTEM INSPECTION

PERMIT# EXPANSION PIN# 3792-66-8494 DATE 7-3-03

OWNER OR CONTRACTOR RHONDA BROWN PHONE: Business Home 704-872-9991

ADDRESS STEWARTS GROCERY 3993 HICKORY HIGHWAY, STATESVILLE, NC 28677

LOCATION US 70 WEST, GROCERY ON LEFT JUST BEFORE OLD MILL DRIVE

SUBDIVISION BLOCK / SECTION LOT LOT AREA 4.42 ACRES SITE CLASS. PS DESIGN FLOW 334 L.T.A.R. 0.25 // 0.3 GPD/FT²

GREASE

Septic Tank: 1000 Gallons; STB Date

Pump Tank: Gallons; PT Date

Pump Make: Model Serial No.

Nitrification Field: No Fields 1 Square Feet 900 Linear Feet 300

No Lines TWO Trench Width 36" Max Trench Bottom Depth 36" Gravel Depth 12"

☑ New System ☐ Repair System Type: I, (II), III, IV, V, VI

System Description: CONVENTIONAL GRAVITY

Repair System Description: CONVENTIONAL, PUMP

Maintenance Agreement Required: ☐ Yes ☑ No

☐ House/Mod. Home No. Bedrooms

☐ Mobile Home No. Bathrooms 2

☑ Business No. Employees 3


☐ Other FOOD STAND & CONV. STORE

☑ Slab ☐ Crawl Space ☐ Basement w/plumbing ☐ Basement wo/plumbing

Water Supply: ☐ Individual ☑ Public ☐ Community


Comments/Conditions: ① REROUTE WATER LINE AS SHOWN. ② INSTALL NEW GREASE TRAP AS SHOWN W/ KITCHEN PLUMBING PIPED TO IT. ③ INSTALL NEW SANITARY TEE WITH FILTER IN EXISTING SEPTIC TANK ④ INSTALL NEW DISTRIBUTION BOX AS SHALLOW AS POSSIBLE.

INITIAL SITE SKETCH

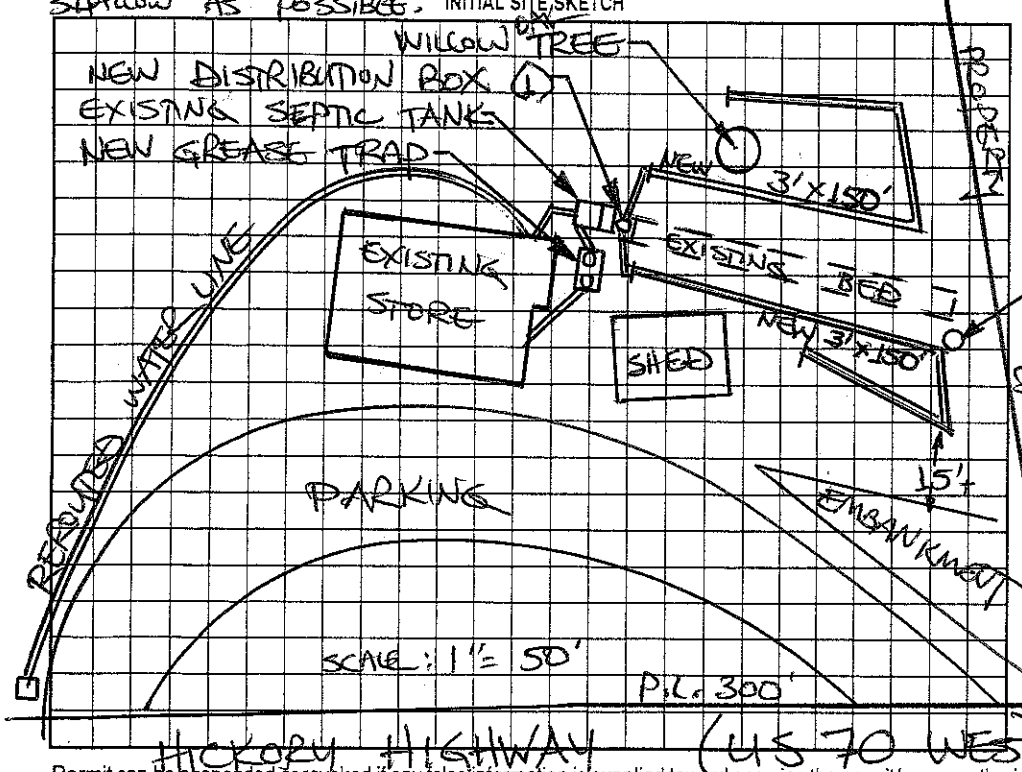

Comments/Conditions: CONVENIENCE STORE @ 943 SF / 120 GPD @ 0.3 GPD/FT² FOOD STAND @ 328 SF / 160 GPD + 50 GPD @ 0.25 GPD/FT² ① WATER LINE & GREASE RELOCATED AS SHOWN W/ PRIOR H.D. APPROVAL DURING PERIOD OF WET SOIL CONDITIONS. ② SYSTEM INSTALLED

AS BUILT SKETCH

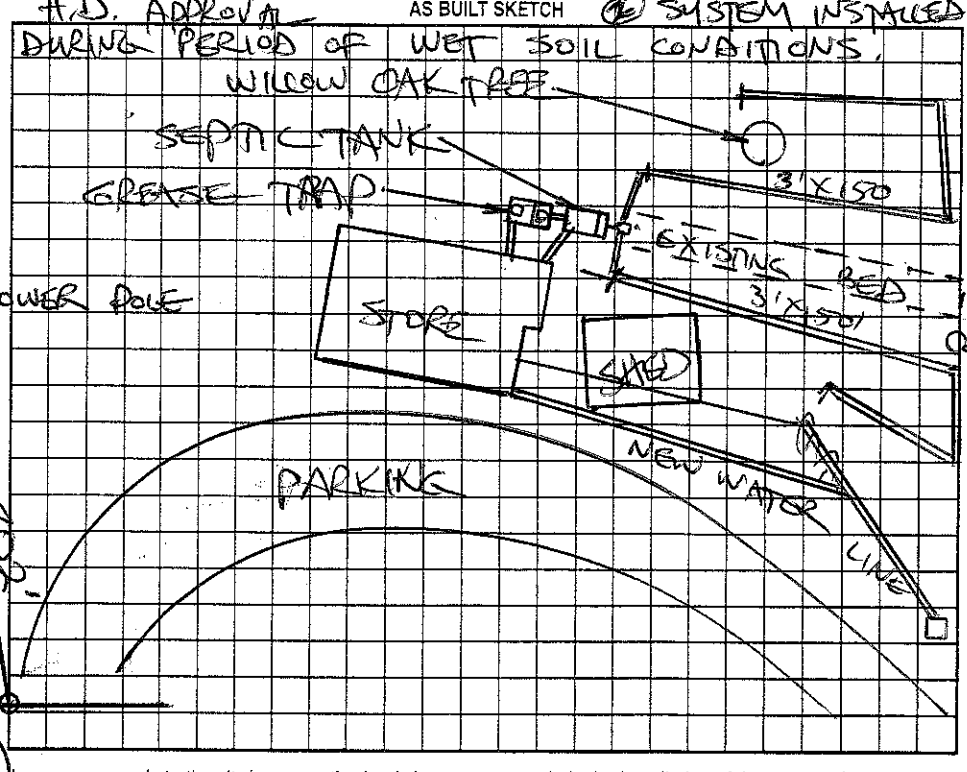

Permit can be suspended or revoked if any false information is supplied toward securing the permit/any unauthorized changes are made to the site/any unauthorized changes are made in the installation of the system. Improvement Permit with plat valid without expiration. Improvement Permit with site plan valid for sixty months. Authorization to Construct is valid for a period equal to that of Improvement Permit – not to exceed sixty months.

Signed: Rhonda W. Brown date 7-16-03 Installed by: JAMES HUBLER

Improvement Permit by: STEVE HEDRICK date 7-3-03 Operation Permit by: STEVE HEDRICK date 8-26-03

Authorization to Construct by: STEVE HEDRICK date 7-3-03 Existing System Inspection by: date

HEALTH DEPT. COPY: WHITE OWNER COPY (FINAL): YELLOW OWNER COPY (INITIAL): PINK