IREDELL COUNTY HEALTH DEPARTMENT

Statesville Phone TR 3-7271 Mooresville Phone No. 664-5287

PERMIT TO INSTALL SEPTIC TANK

Permit No. [illegible] Permit Date 2-7 1973

Owner J.E. Stewart Gro Address Statesville NC.

Installed By Sam Ostwalt Address Troutman NC


Location of Property Out Hickory Hwy "76" Ser Sta on L. Just before you get to New Bethany Church

Tank		Capacity		Length of Lines		Fixtures	
Block	( )	1000	(✓)	225'	(✓)	No. of Baths	(2)
Precast	(✓)	1250	( )	250'	( )	Dishwasher	( )
		1500	( )	Other		Garbage Grdr.	( )
		Other				Other	

NOTIFY HEALTH DEPARTMENT AT LEAST EIGHT HOURS BEFORE TANK IS TO BE INSPECTED.

Final Inspection 2-7 1973 Approved (✓) Disapproved ( )

Remarks Well over 100' from system

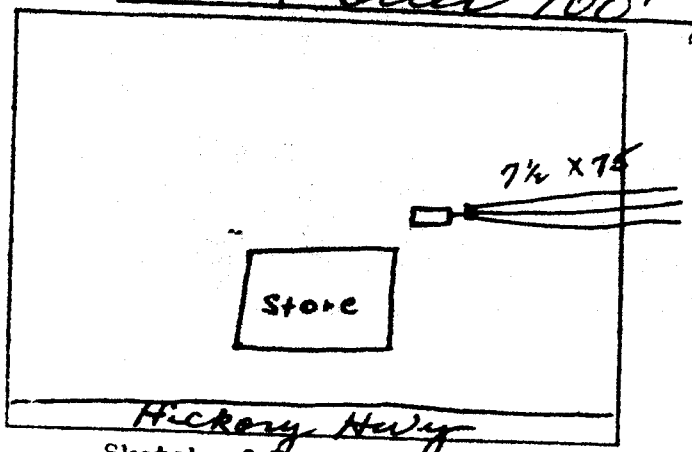

Sketch of Installation

E. A. Stevenson

Sanitarian