IREDELL COUNTY HEALTH DEPARTMENT

STATESVILLE 704-878-5305 MOORESVILLE 704-664-5281

IMPROVEMENT PERMIT / AUTHORIZATION TO CONSTRUCT / OPERATION PERMIT / EXISTING SYSTEM INSPECTION

PERMIT# EXISTING PIN# 3792-66-8494 DATE 4-29-04

OWNER OR CONTRACTOR ANGIE STEWART PHONE: Business 704-873-1178 Home

ADDRESS STEWART'S GROCERY 3993 HICKORY HWY, STATESVILLE, NC 28677

LOCATION US 70 WEST, GROCERY ON LEFT JUST BEFORE OLD MILL DRIVE

SUBDIVISION BLOCK / SECTION LOT 12 LOT AREA 4.42 ACRES SITE CLASS. PS DESIGN FLOW 334 L.T.A.R. 0.25 // 0.3 GPD/FT²

Septic Tank: 1000 Gallons; STB Date

GREASE Tank: 1000 Gallons; PT Date

Pump Make: Model Serial No.

Nitrification Field: No Fields 1 Square Feet 1254 Linear Feet = 418

No Lines THREE Trench Width Max Trench Bottom Depth Gravel Depth 12"

☐ New System ☐ Repair System Type: I, II, III, IV, V, VI

System Description: CONVENTIONAL GRAVITY

Repair System Description: CONVENTIONAL, PUMP

Maintenance Agreement Required: ☐ Yes ☒ No

☐ House/Mod. Home No. Bedrooms

☐ Mobile Home No. Bathrooms

☒ Business No. Employees

☐ Other CONV. STORE 700 SF RESTAURANT 6 SEATS

☐ Slab ☐ Crawl Space ☐ Basement w/plumbing ☐ Basement wo/plumbing


Water Supply: ☐ Individual ☒ Public ☐ Community

Comments:/Conditions:

Comments:/Conditions: CHANGE OF USE TO CONVENIENCE STORE WITH 700 SF AND RESTAURANT W/ 6 SEATS (FROM CONV. STORE W/ 943 SF & FOODSAVER W/ 328 SF)

INITIAL SITE SKETCH

AS BUILT SKETCH

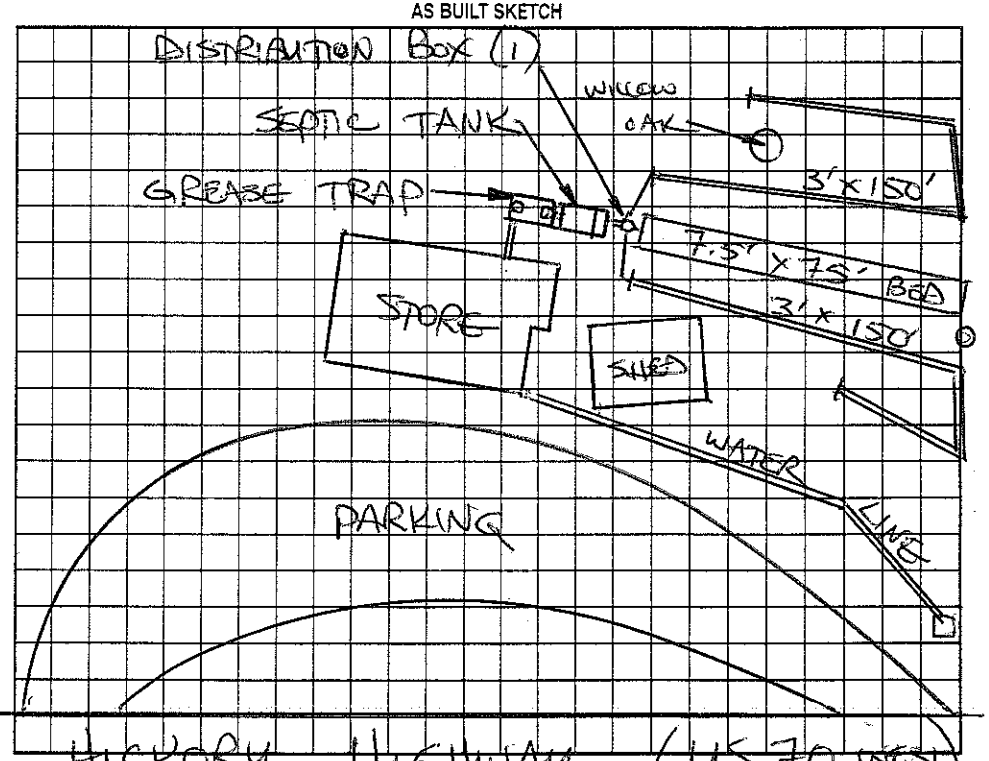

Permit can be suspended or revoked if any false information is supplied toward securing the permit/any unauthorized changes are made to the site/any unauthorized changes are made in the installation of the system. Improvement Permit with plat valid without expiration. Improvement Permit with site plan valid for sixty months. Authorization to Construct is valid for a period equal to that of Improvement Permit, not to exceed sixty months.

Signed: date Installed by:

Improvement Permit by: date Operation Permit by: date

Authorization to Construct by: date Existing System Inspection by: STEVE HEDRICK date 4-29-04

HEALTH DEPT. COPY: WHITE OWNER COPY (FINAL): YELLOW OWNER COPY (INITIAL): PINK