IREDELL COUNTY HEALTH DEPARTMENT

Statesville Office (704) 878-5305 Mooresville Office (704) 660-3625 PERMIT # 18162B BF

IMPROVEMENT PERMIT / AUTHORIZATION TO CONSTRUCT / OPERATION PERMIT / EXISTING SYSTEM

PIN # 3792746509

APPLICANT: Abee's Clearing + Grading APPLICANT ADDRESS: 2381 US Hwy 64 West

SITE ADDRESS: 221 Eufola Rd. PHONE: 704-239-3193 ALT. PHONE: N/A

SITE DIRECTIONS: I-40 W to Old Mountain Rd. TL Old Mountain Rd TR Hickory Hwy TL Eufola Rd.

SUBDIVISION: N/A SECTION: N/A LOT # N/A LOT AREA: 2.69 acres DESIGN FLOW: 360 gpd L.T.A.R.: Existing

Septic Tank Existing (gal) STB Date

Pump Tank (gal) PT Date

Pump Make Model Serial #

Nitrification Fields 1 # Lines Ex Linear Ft: Ex

Trench Width Ex Max. Trench Bottom Depth Ex Gravel Depth Ex

☐ New System ☐ Repair ☐ Expansion System Type: I ☒ III IV V VI

System Description: conventional

Repair System Description:

Maintenance Agreement Required: ☐ YES ☒ NO

☐ GRAVITY ☐ PRESSURE

☒ Residence No. Bedrooms 3

☐ Business No. Persons

☐ Other No. Employees

☐ Slab ☒ Crawl Space

☐ Basement w/plumbing ☐ Basement w/o plumbing

Water Supply

☒ Private

☐ Public


☐ Community

Comments / Conditions:

- Maintain a minimum of 5' between home foundation + all components of septic tank system.

INITIAL SITE SKETCH

AS BUILT SKETCH

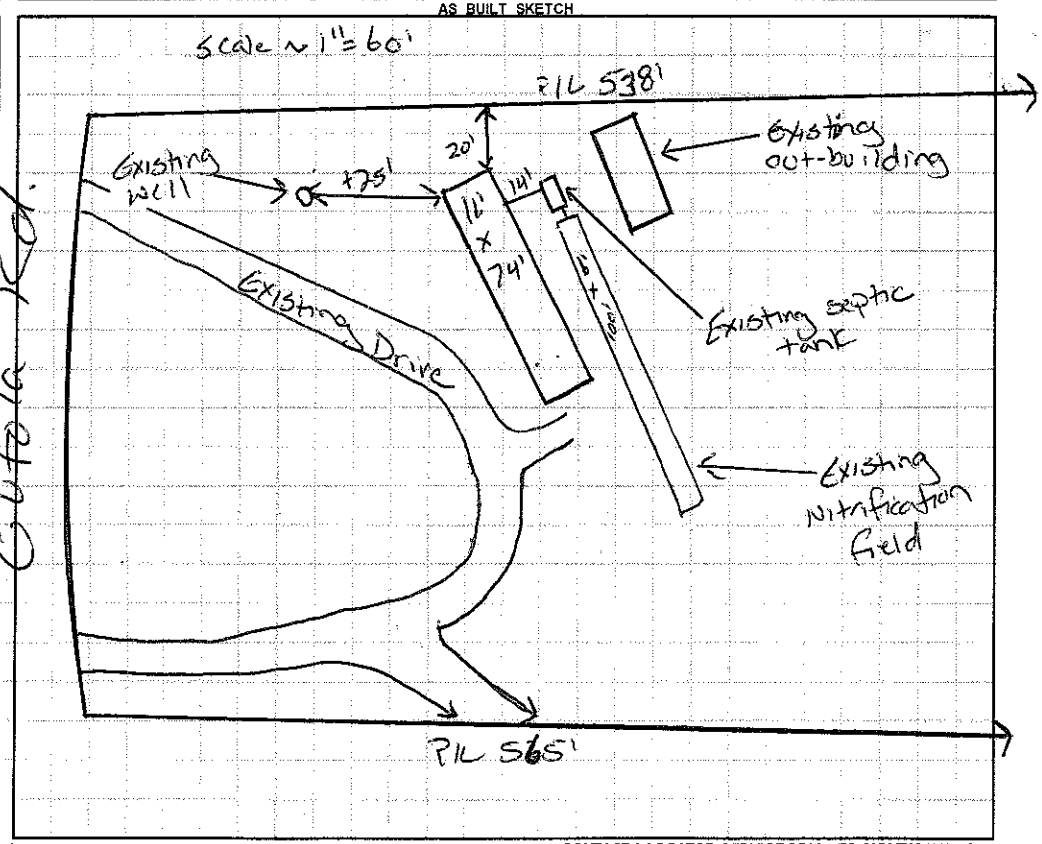

Permit can be suspended or revoked if any false information is supplied toward securing the permit / any unauthorized changes are made to the site / any unauthorized changes are made in the installation of the system. **CONTACT A LOCATOR SERVICE PRIOR TO ANY EXCAVATION**

☐ **IMPROVEMENT PERMIT *with plat*** *valid without expiration.* ☐ **IMPROVEMENT PERMIT *with site plan*** *valid for 60 mos.* ☐ **AUTHORIZATION TO CONSTRUCT** *valid for period equal to IMPROVEMENT PERMIT--not to exceed 60 mo.*

Owner / Applicant Signature: Deena Abee Date: 11/5/13 Installed by:

IMPROVEMENT PERMIT by: Date: OPERATION PERMIT by: Date:

AUTHORIZATION TO CONSTRUCT by: Date: Existing System Inspected by: Justin Anderson Date: 11-4-13

Health Dept. Copy - WHITE Applicant (Final Approval) - YELLOW Applicant (Conditional Approval) - PINK