3792769965

IREDELL COUNTY HEALTH DEPARTMENT

STATESVILLE 704-878-5305 MOORESVILLE 704-664-5281

IMPROVEMENT PERMIT / AUTHORIZATION TO CONSTRUCT / OPERATION PERMIT / EXISTING SYSTEM INSPECTION

PERMIT # 158786 PIN # 3797-27-6965.122 DATE

OWNER or APPLICANT Larry - Barbara Taylor PHONE: Business Home: 704-872-3330

OWNER or APPLICANT ADDRESS 1220 Pooh Drive Statesville NC 28677

LOCATION / DIRECTIONS Hwy 70 West (T) Pooh Cove around curve

SUBDIVISION BLOCK / SECTION LOT # LOT AREA 15.54 DESIGN FLOW 240 L.T.A.R. 5 (1248)

Septic Tank 1250 Gallons: STB 1012 Date 3896 West ~~New System~~ Repair Expansion System Type I II III IV V VI

Pump Tank Gallons: P T Date

Pump Make Model Serial #

Nitrification Field No Fields 1 No Lines 2 Linear Feet 160

Trench Width 36" Max. Trench Bottom Depth 36" Gravel Depth 12" GRAVITY PRESSURE

System Description Oriental Geyser

Repair System Description: Conventional Gravity

Maintenance Agreement Required YES NO


Residence No. Bedrooms 2 Business No. Persons Other No. Employees Slab Crawl Space Basement w/plumbing Basement w/o plumbing

Water Supply: Private ~~Public~~ Community


Comments / Conditions

Comments / Conditions

INITIAL SITE SKETCH

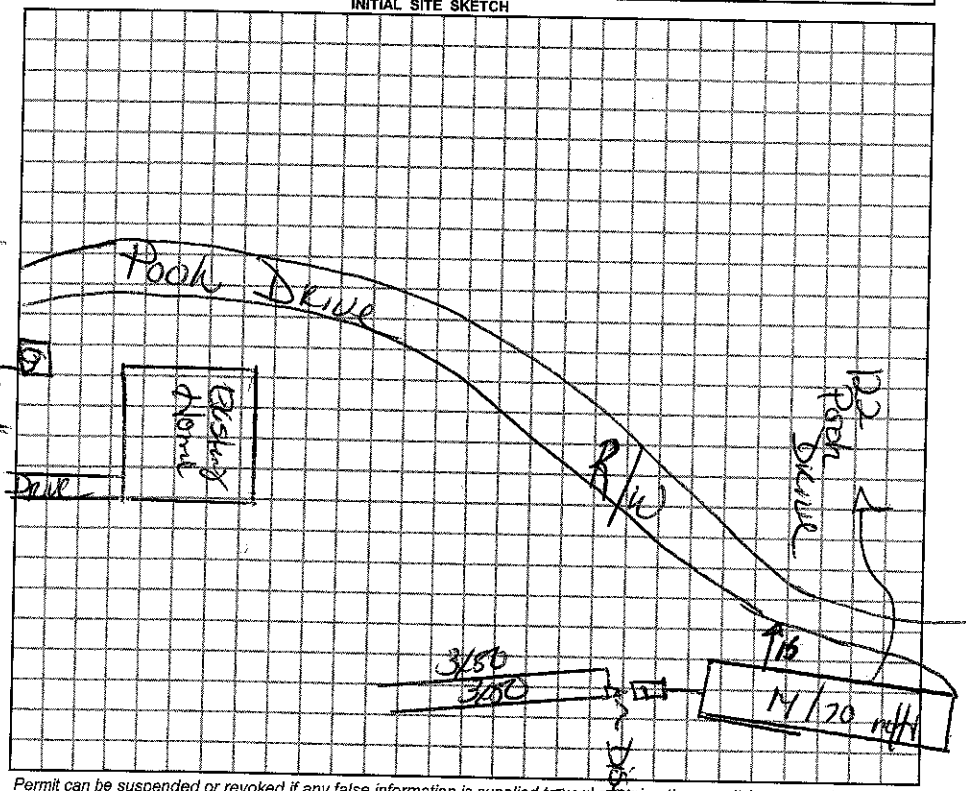

AS BUILT SKETCH

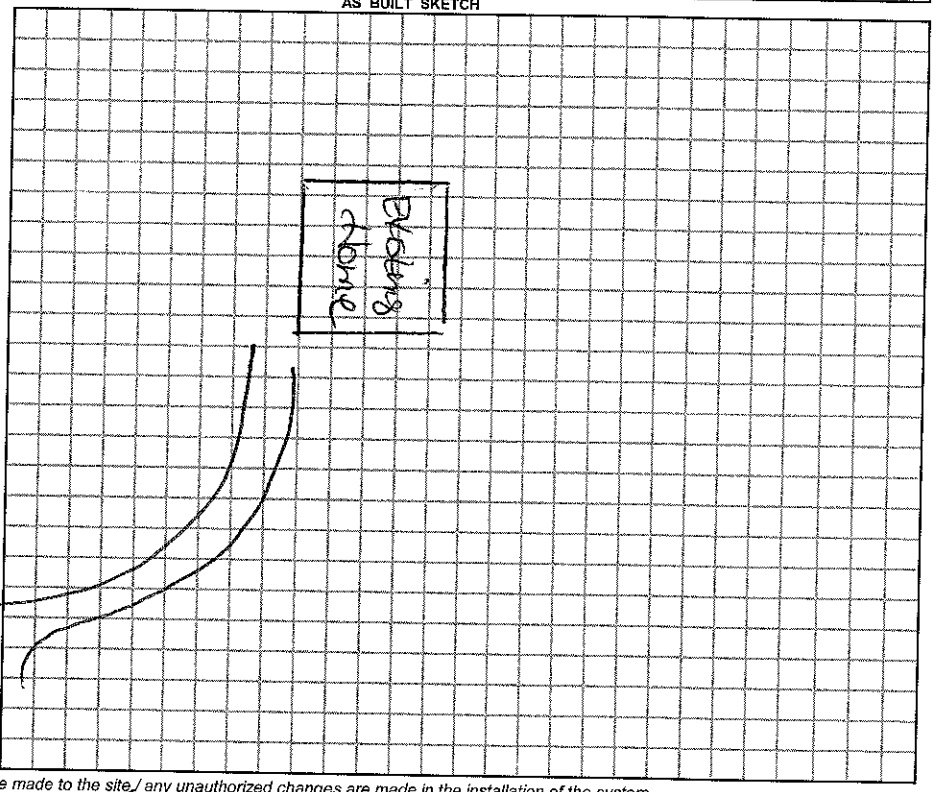

Permit can be suspended or revoked if any false information is supplied toward securing the permit / any unauthorized changes are made to the site / any unauthorized changes are made in the installation of the system.

☐ *IMPROVEMENT PERMIT w / plat valid without expiration.* ☐ *IMPROVEMENT PERMIT w / site plan valid for 60 mos.* ☐ *AUTHORIZATION TO CONSTRUCT valid for period equal to IMPROVEMENT PERMIT-not to exceed 60 mo.*

Owner / Applicant Signature: X Larry W Taylor Date 11-17-09

Improvement Permit by: Date

Authorization to Construct by: Date

YOU SHOULD CONTACT A LOCATOR SERVICE PRIOR TO ANY EXCAVATION.

Installed by: AAA Enterprise 5-9-96

Operation Permit by: Date:

Existing System Inspected by: Date: 11-17-09

WHITE COPY Environmental Health YELLOW COPY (Final) Owner / Applicant PINK COPY (Initial) Owner / Applicant