Computer (8YH-A-46)

IREDELL COUNTY HEALTH DEPARTMENT

STATESVILLE 704-878-5305 MOORESVILLE 704-664-5281

IMPROVEMENT PERMIT / CERTIFICATE OF COMPLETION / OPERATION PERMIT / EXISTING SYSTEM INSPECTION

PROPERTY DESCRIPTION NO. 22856 DATE 12-22-95 TAX MAP NO. 8H-A-46 Watershed: ☑ Yes ☐ No

OWNER OR CONTRACTOR LARRY W. TAYLOR PHONE: Business _____ Home 872-3730

ADDRESS 3939 HICKORY HWY, STE, NC 28677

LOCATION US 70 WEST, 2ND DWELLING ON LEFT PAST BUFFALO CREEK

SUBDIVISION _____ BLOCK / SECTION _____ LOT _____ LOT AREA AMPLE SITE CLASS. PS DESIGN FLOW 240 L.T.A.R. 0.5 GPD/FT²

Septic Tank: 1000 Gallons; STB 1012 Date 3-8-96

Pump Tank: _____ Gallons; PT _____ Date _____

Pump Make: _____ Model _____ Serial No. _____

Nitrification Field: No Fields 1 Square Feet 480 Linear Feet 160

No Lines 2 Trench Width 36" Max Trench Bottom Depth 36" Gravel Depth 12"

☑ New System ☐ Repair System Type: I, II, III, IV, V, VI

System Description: CONV. GRAVITY

Repair System Description: MAX. FEASIBLE CONV GRAVITY

Maintenance Agreement Required: ☐ Yes ☑ No

☐ Slab ☑ Crawl Space ☐ Basement w/plumbing ☐ Basement wo/plumbing

☐ House/Mod. Home No. Bedrooms 2

☑ Mobile Home No. Bathrooms 1

☐ Business No. Employees _____


☐ Other _____

Water Supply: ☐ Individual ☐ Community ☑ Public

Comments:

Comments:

INITIAL SITE SKETCH

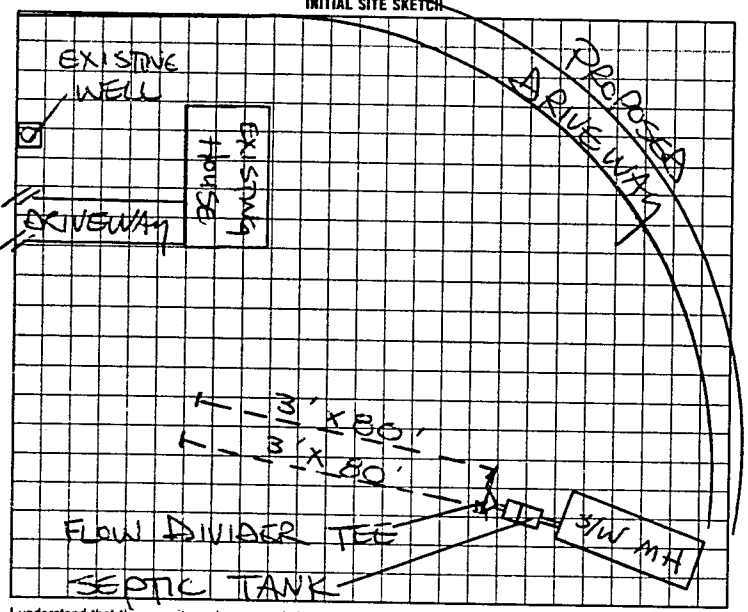

AS BUILT SKETCH

SYSTEM INSTALLED ACCORDING TO INITIAL SITE SKETCH

I understand that this permit can be suspended or revoked if any false information is supplied toward securing the permit/any unauthorized changes are made to the site/any unauthorized changes are made in the installation of the system.

AUTHORIZATION TO CONSTRUCT IS VALID FIVE (5) YEARS FROM DATE OF ISSUANCE. IMPROVEMENT PERMIT HAS NO EXPIRATION DATE.

Signed: _____

Improvement Permit by: STEVE HEDRICK date 12-22-95

AUTHORIZATION TO CONSTRUCT Inspection by: STEVE HEDRICK date 12-22-95

Installed by: AAA ENTERPRISES

~~Certificate of Completion by:~~ _____ date _____

Operation Permit by: STEVE HEDRICK date 5-9-96

HEALTH DEPT COPY WHITE | INSPECTION COPY (FINAL) GREEN | OWNER COPY (FINAL) YELLOW | INSPECTION COPY (INITIAL) PINK | OWNER COPY (INITIAL) GOLD

S E S I 2 0 0