IREDELL COUNTY HEALTH DEPARTMENT

STATESVILLE 704-878-5305 MOORESVILLE 704-664-5281

IMPROVEMENT PERMIT / CERTIFICATE OF COMPLETION / OPERATION PERMIT / EXISTING SYSTEM INSPECTION

PROPERTY DESCRIPTION NO. 25893/67292 DATE 1-24-97 TAX MAP NO. 3792768939 Watershed: ☐ Yes ☐ No

OWNER OR CONTRACTOR Wendy Taylor PHONE: Business _____ Home 872-3730 WS IV PA

ADDRESS 3939 Hickory Hwy Statesville NC

LOCATION 70 West Box 3939 (Drive prior to this)

SUBDIVISION _____ BLOCK / SECTION _____ LOT _____ LOT AREA _____ SITE CLASS P/S DESIGN FLOW 240 L.T.A.R. 0.32

Septic Tank: 1000 Gallons; STB 312 Date 2-2-96
Pump Tank: _____ Gallons; PT _____ Date _____
Pump Make: _____ Model _____ Serial No. _____
Nitrification Field: No Fields 1 Square Feet 750 Linear Feet 250
No Lines 2 Trench Width 36in Max Trench Bottom Depth 24in Gravel Depth 12

☒ New System ☐ Repair System Type: I II III IV V VI
System Description: Grnd Conventional
Repair System Description: Grnd Conventional
Maintenance Agreement Required: ☐ Yes ☒ No
☐ Slab ☐ Crawl Space ☒ Basement w/plumbing ☐ Basement wo/plumbing


☒ House/Mod. Home No. Bedrooms 2
☐ Mobile Home No. Bathrooms ____
☐ Business No. Employees ____
☐ Other _____

Water Supply:
☒ Individual
☐ Community
☐ Public


Comments: keep lines on contour 9ft on center
keep well 100 ft from system

Comments:
Back fill needed to cover Ester Drop Box
And end of 2nd Line.

INITIAL SITE SKETCH

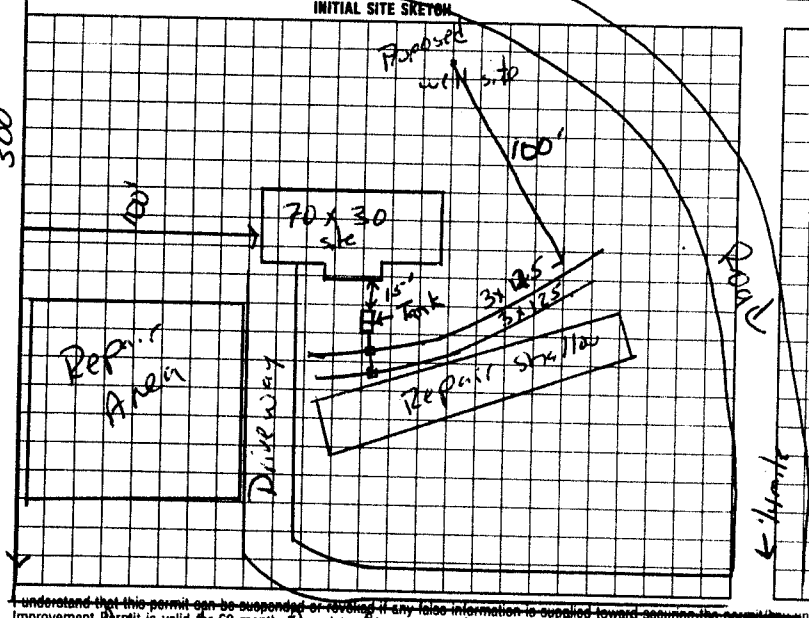

AS BUILT SKETCH

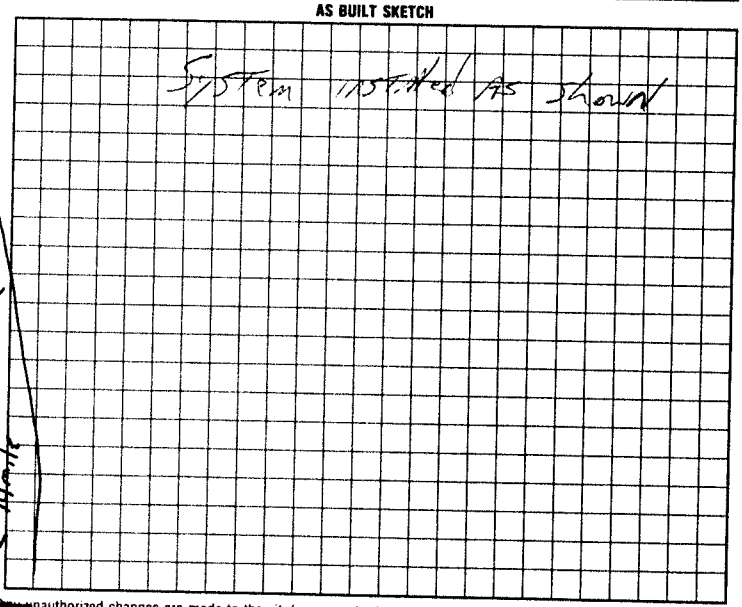

I understand that this permit can be suspended or revoked if any false information is supplied toward securing the permit, any unauthorized changes are made to the site/any unauthorized changes are made in the installation of the system.

Improvement Permit is valid for 60 months from date of issuance. Authorization to const. 300' exp. 5 yrs from issue date

Signed: Wendy Taylor

Improvement Permit by: Mary Cox HS date 1-24-97

Existing System Inspection by: Mary Cox RS date 1-24-97

Installed by: Mike Vickers

Certificate of Completion by: L Potter date May 15 2000

Operation Permit by: _____ date _____

HEALTH DEPT. COPY: WHITE | INSPECTION COPY (FINAL): GREEN | OWNER COPY (FINAL): YELLOW | INSPECTION COPY (INITIAL): PINK | OWNER COPY (INITIAL): GOLD