# IREDELL COUNTY HEALTH DEPARTMENT

STATESVILLE 704-878-5305 MOORESVILLE 704-664-5281

## IMPROVEMENT PERMIT / AUTHORIZATION TO CONSTRUCT / OPERATION PERMIT / EXISTING SYSTEM INSPECTION

PERMIT# 100826 PIN# 3792-84-3792.6 DATE 6/21/01

OWNER OR CONTRACTOR Edward Gunter PHONE: Business — Home (704) 878-6365

ADDRESS 236 Enfola Rd MHP Statesville N.C. 28677

LOCATION Hidden Valley MHP #13 (116 16) Lot #6

SUBDIVISION _____ BLOCK / SECTION _____ LOT 6 LOT AREA MHP 13.03 SITE CLASS _____ DESIGN FLOW _____ L.T.A.R. Existing

Septic Tank: Existing 1,000 Gallons; STB _____ Date _____

Pump Tank: _____ Gallons; PT _____ Date _____

Pump Make: _____ Model _____ Serial No. Existing

Nitrification Field: No Fields ____ Square Feet _____ Linear Feet 225

No Lines _____ Trench Width _____ Max Trench Bottom Depth _____ Gravel Depth _____

New System / Repair System Type: I. II. III. IV. V. VI

System Description: Existing Gravel Conv.

Repair System Description: _____

Maintenance Agreement Required: Yes No

House/Mod. Home No. Bedrooms 3

Mobile Home No. Bathrooms 2

Business No. Employees _____

Other _____

Slab Crawl Space Basement w/plumbing Basement wo/plumbing


Water Supply: Individual Public Community

Comments/Conditions:

Comments/Conditions: MHP - All System are Okay (Central Water Supply)

INITIAL SITE SKETCH

AS BUILT SKETCH

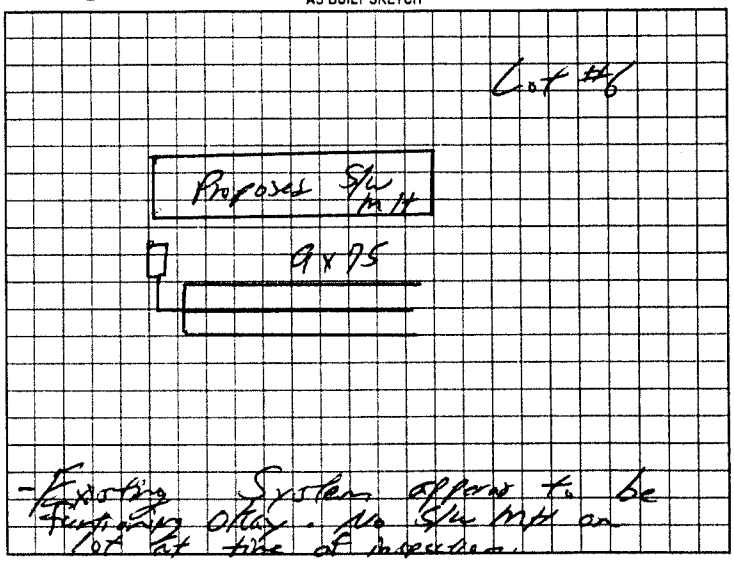


Permit can be suspended or revoked if any false information is supplied toward securing the permit/any unauthorized changes are made to the site/any unauthorized changes are made in the installation of the system. Improvement Permit with plat valid without expiration. Improvement Permit with site plan valid for sixty months. Authorization to Construct is valid for a period equal to that of Improvement Permit – not to exceed sixty months.

Signed _____ date 6-22-01 Installed by: _____

Improvement Permit by: _____ date _____ Operation Permit by: _____ date _____

Authorization to Construct by: _____ date _____ Existing System Inspection by: William G. Johnson date 6/22/01

HEALTH DEPT. COPY WHITE OWNER COPY (FINAL) YELLOW OWNER COPY (INITIAL) PINK