IREDELL COUNTY HEALTH DEPARTMENT

STATESVILLE 704-878-5305 MOORESVILLE 704-664-5281

IMPROVEMENT PERMIT / AUTHORIZATION TO CONSTRUCT / OPERATION PERMIT / EXISTING SYSTEM INSPECTION

DATE 6/19/00

PERMIT# 89849 PIN# 3792844374 PT PHONE: Business 878-6262 Home

OWNER OR CONTRACTOR EDWARD GUNTER

ADDRESS 331 EUFOLA RD STATESVILLE NC 28677

LOCATION TOW- TL EUFOLA - TL HIDDEN VALLEY - 1ST ON LT PAST VISIBLE DC

SUBDIVISION HIDDEN VALLEY MHP BLOCK / SECTION LOT 13 LOT AREA 1.3 AC SITE CLASS PS DESIGN FLOW 360 GPD L.T.A.R. EXISTING

Septic Tank: EXISTING Gallons: STB Date

Pump Tank: Gallons: PT Date

Pump Make: Model Serial No.

Nitrification Field: No Fields Square Feet EXISTING Linear Feet

No Lines Trench Width Max Trench Bottom Depth Gravel Depth

☑ New System ☐ Repair System Type: I II III IV V VI

System Description: GRAVITY DEEP CONVENT

Repair System Description:

Maintenance Agreement Required: ☐ Yes ☐ No

☐ Slab ☐ Crawl Space ☐ Basement w/plumbing ☐ Basement wo/plumbing

☐ House/Mod. Home No. Bedrooms 3

☐ Mobile Home No. Bathrooms 2

☐ Business No. Employees

☐ Other


Water Supply:
☐ Individual
☐ Public
☑ Community

Comments/Conditions:

Comments/Conditions: SYSTEM FUNCTIONING PROPERLY AT TIME OF INSPECTION

INITIAL SITE SKETCH

AS BUILT SKETCH

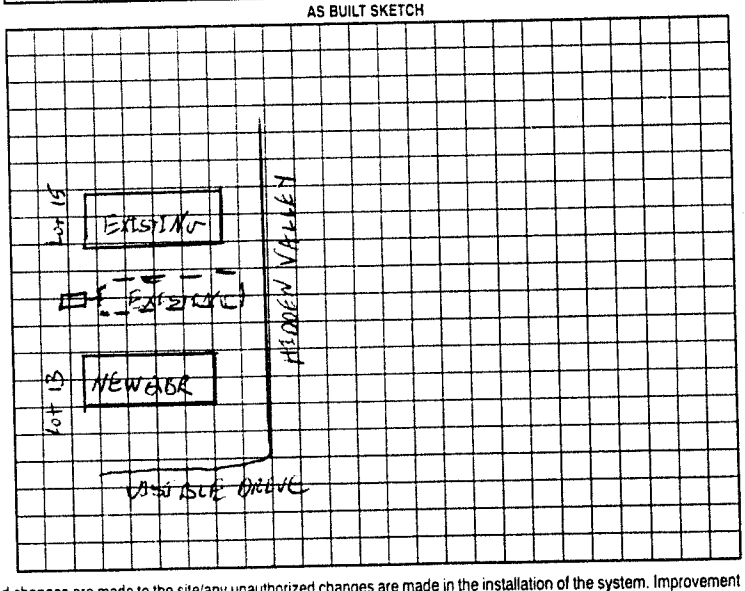

Permit can be suspended or revoked if any false information is supplied toward securing the permit/any unauthorized changes are made to the site/any unauthorized changes are made in the installation of the system. Improvement Permit with plat valid without expiration. Improvement Permit with site plan valid for sixty months. Authorization to Construct is valid for a period equal to that of Improvement Permit – not to exceed sixty months.

Signed: [signature] date 6/19/00

Improvement Permit by: date

Authorization to Construct by: date

Installed by:

Operation Permit by: date

Existing System Inspection by: [signature] KS date 6/19/00

HEALTH DEPT. COPY: WHITE OWNER COPY (FINAL): YELLOW OWNER COPY (INITIAL): PINK