IREDELL COUNTY HEALTH DEPARTMENT

STATESVILLE 704-878-5305 MOORESVILLE 704-664-5281

IMPROVEMENT PERMIT / AUTHORIZATION TO CONSTRUCT / OPERATION PERMIT / EXISTING SYSTEM INSPECTION

PERMIT# 89851 PIN# 379 284 3747 PT DATE 6/19/00

OWNER OR CONTRACTOR EDWARD GUNTER PHONE Business 878 6262 Home

ADDRESS 231 EUFOLA RD STATESVILLE NC 28677

LOCATION TOW - TL EUFOLA - TL HIDDEN VALLEY - ON LT NEAR END

SUBDIVISION HIDDEN VALLEY MHP BLOCK / SECTION LOT 17 LOT AREA ~1.3 AC SITE CLASS PS DESIGN FLOW 240 GPD L.T.A.R. EXISTING

Septic Tank: EXISTING Gallons. STB Date

Pump Tank: Gallons. PT Date

Pump Make: Model Serial No

Nitrification Field: No Fields Square Feet EXISTING Linear Feet

No Lines Trench Width Max Trench Bottom Depth

☐ New System ☐ Repair System Type I II III IV V VI

System Description GRAVITY DEEP CONVENTIONAL

Repair System Description

Maintenance Agreement Required ☐ Yes ☐ No

Gravel Depth

☐ Slab ☐ Crawl Space ☐ Basement w/plumbing ☐ Basement wo/plumbing

☐ House/Mod. Home No. Bedrooms 2/3

☑ Mobile Home No. Bathrooms

☐ Business No. Employees

☐ Other


Water Supply: ☐ Individual ☐ Public ☑ Community

Comments/Conditions

Comments/Conditions SYSTEM FUNCTIONING PROPERLY AT TIME OF INSPECTION.

INITIAL SITE SKETCH

AS BUILT SKETCH

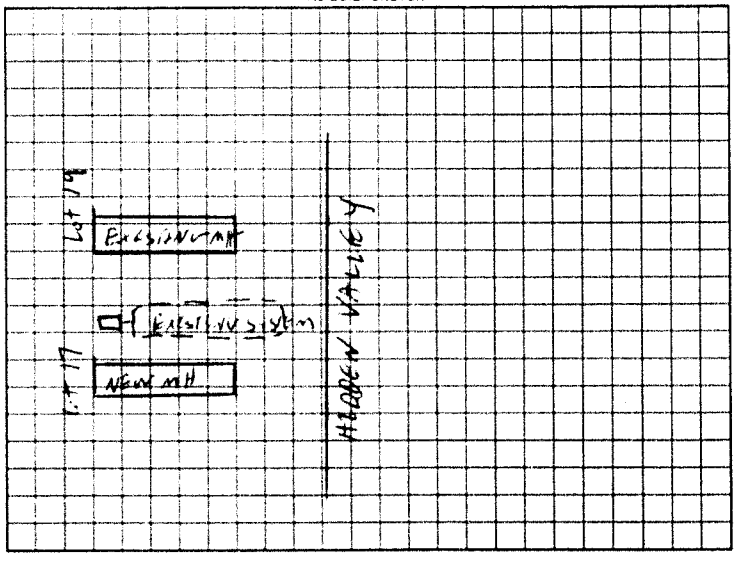

Permit can be suspended or revoked if any false information is supplied toward securing the permit, any unauthorized changes are made to the site, any unauthorized changes are made in the installation of the system. Improvement Permit with plat valid without expiration. Improvement Permit with site plan valid for sixty months. Authorization to Construct is valid for a period equal to that of Improvement Permit - not to exceed sixty months.

Signed: [signature] date 6/19/00

Improvement Permit by: date

Authorization to Construct by: date

Installed by

Operation Permit by date

Existing System Inspection by [signature] PS date 6/19/00

HEALTH DEPT COPY WHITE OWNER COPY (FINAL) YELLOW OWNER COPY (INITIAL) PINK