IREDELL COUNTY HEALTH DEPARTMENT

STATESVILLE 704-878-5305 MOORESVILLE 704-664-5281

IMPROVEMENT PERMIT / AUTHORIZATION TO CONSTRUCT / OPERATION PERMIT / EXISTING SYSTEM INSPECTION

PERMIT# 72089 PIN# 3792 85 3522 DATE 3-4-98

OWNER OR CONTRACTOR Robert G. Hackenberry PHONE: Business Home 546-7684

ADDRESS 136 Hay Stack Lane, Olin, N.C.

LOCATION 70 W to Eufola Rd 1/4 mi. Twin Lynns Lane (New street) 1/2 mi to Curtis Rd off Duke Power

SUBDIVISION Guntersps. BLOCK / SECTION LOT 3 LOT AREA 19.5 acres SITE CLASS. PS DESIGN FLOW 360 L.T.A.R. 3

Septic Tank: 1000 Gallons; STB 32 Date 5-6-02

Pump Tank: Gallons; PT Date

Pump Make: Model Serial No.

Nitrification Field: No Fields 1 Square Feet 1200 Linear Feet 400

No Lines 4 Trench Width 36" Max Trench Bottom Depth 36" Gravel Depth 12"

☐ New System ☐ Repair System Type: I, II, III, IV, V, VI

System Description: Conv. Gravity

Repair System Description: " "

Maintenance Agreement Required: ☐ Yes ☒ No

☐ House/Mod. Home ☒ Mobile Home ☐ Business ☐ Other

No. Bedrooms 3 No. Bathrooms 2 No. Employees


☐ Slab ☒ Crawl Space ☐ Basement w/plumbing ☐ Basement wo/plumbing

Water Supply: ☒ Individual ☐ Public ☐ Community P/W


Comments:/Conditions: P/W 1000'+

Comments:/Conditions: -ST Risers & Marker Installed.
-Poly lok ~~filters~~ filter Installed

INITIAL SITE SKETCH

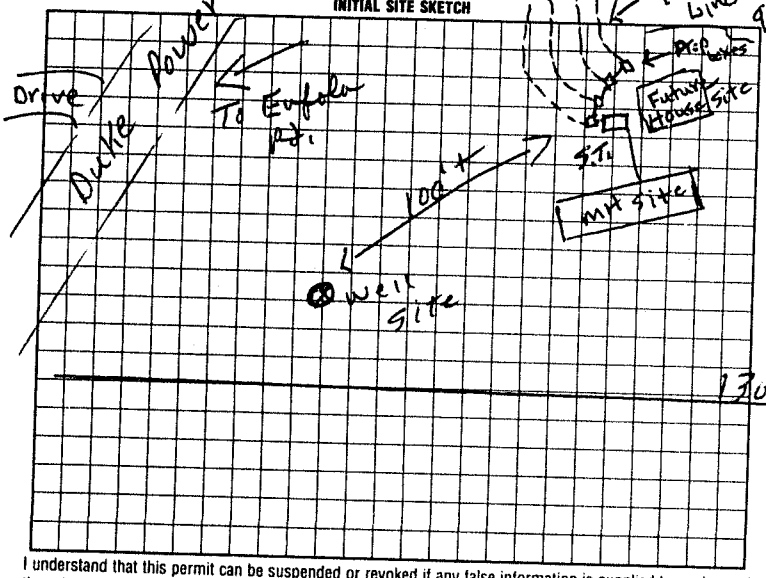

AS BUILT SKETCH

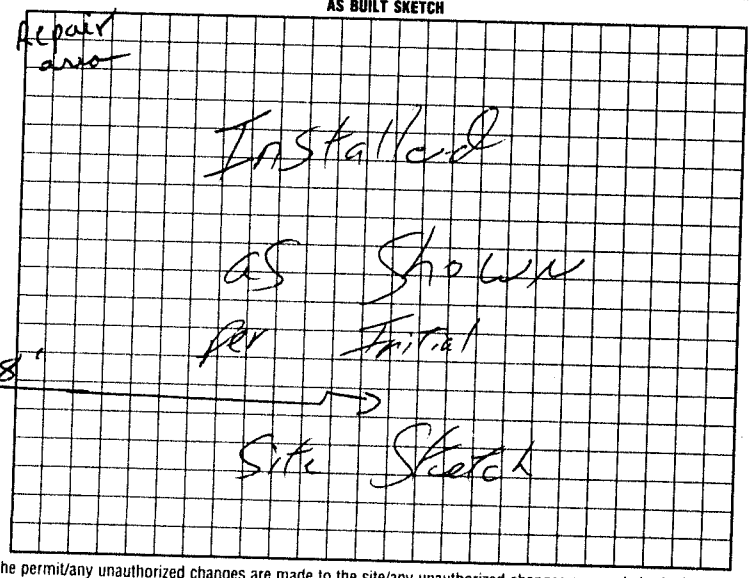

I understand that this permit can be suspended or revoked if any false information is supplied toward securing the permit/any unauthorized changes are made to the site/any unauthorized changes are made in the installation of the system. Improvement Permit with plat valid without expiration. Improvement Permit with site plan valid for sixty months. Authorization to Construct is valid for a period equal to that of Improvement Permit – not to exceed sixty months.

Signed: Robert H. Hackenberry date

Improvement Permit by: P.C. Moore date 3-4-98

Authorization to Construct by: P.C. Moore date 3-4-98

Installed by: Mitchell Grading

Operation Permit by: William C. Johnson date 6/12/02

Existing System Inspection by: date

HEALTH DEPT. COPY: WHITE INSPECTION COPY (FINAL): GREEN OWNER COPY (FINAL): YELLOW INSPECTION COPY (INITIAL): PINK OWNER COPY (INITIAL): GOLD