IREDELL COUNTY HEALTH DEPARTMENT

STATESVILLE 704-878-5305 MOORESVILLE 704-664-5281

IMPROVEMENT PERMIT / AUTHORIZATION TO CONSTRUCT / OPERATION PERMIT / EXISTING SYSTEM INSPECTION

PERMIT# 134650 PIN# 3792805078 DATE 4-6-06

OWNER OR APPLICANT Adam & Monica Drake PHONE: Business _____ Home 704-528-2057

ADDRESS 175 Lynns Ln Statesville NC 28677

LOCATION NW on Euphoria 1/2 mile just before bridge Lynns Lane to top of Hill

SUBDIVISION Gunter Subd BLOCK / SECTION _____ LOT 3 LOT AREA 1.75 SITE CLASS. B DESIGN FLOW 360 L.T.A.R. 1.3

Septic Tank: 1000 Gallons; STB 372 Date 5-6-02

Pump Tank: _____ Gallons; PT _____ Date _____

Pump Make: _____ Model _____ Serial No. _____

Nitrification Field; No Fields 1 Square Feet 1200 Linear Feet _____

No Lines 4 Trench Width 36" Max Trench Bottom Depth 36" Gravel Depth 12" ☒ Gravity ☐ Pressure

☐ New System ☐ Repair ☐ Expansion System Type: I II III IV V VI

System Description: EXIST

Repair System Description: _____

Maintenance Agreement Required: ☐ Yes ☒ No

☒ House/Mod. Home No. Bedrooms 3

☐ Mobile Home No. Persons _____

☐ Business No. Employees _____

☐ Other _____

Water Supply: ☐ Individual ☐ Public ☐ Community

☐ Slab ☐ Crawl Space ☐ Basement w/plumbing ☐ Basement wo/plumbing


Comments:/Conditions:

* Mobile Home will Abandon System


Comments:/Conditions:

Not to scale

INITIAL SITE SKETCH

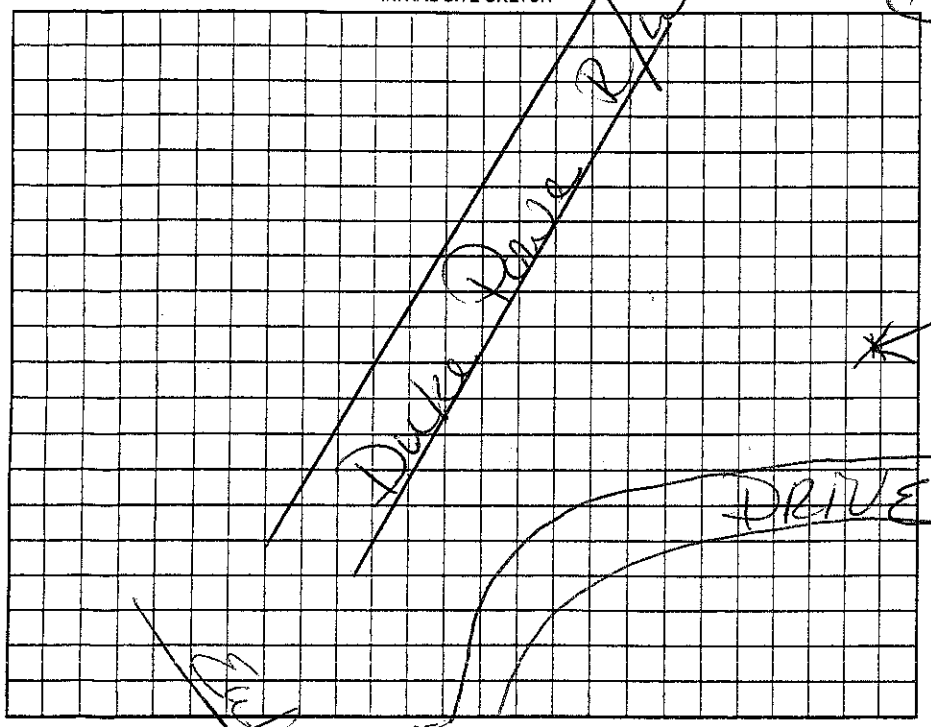

AS BUILT SKETCH

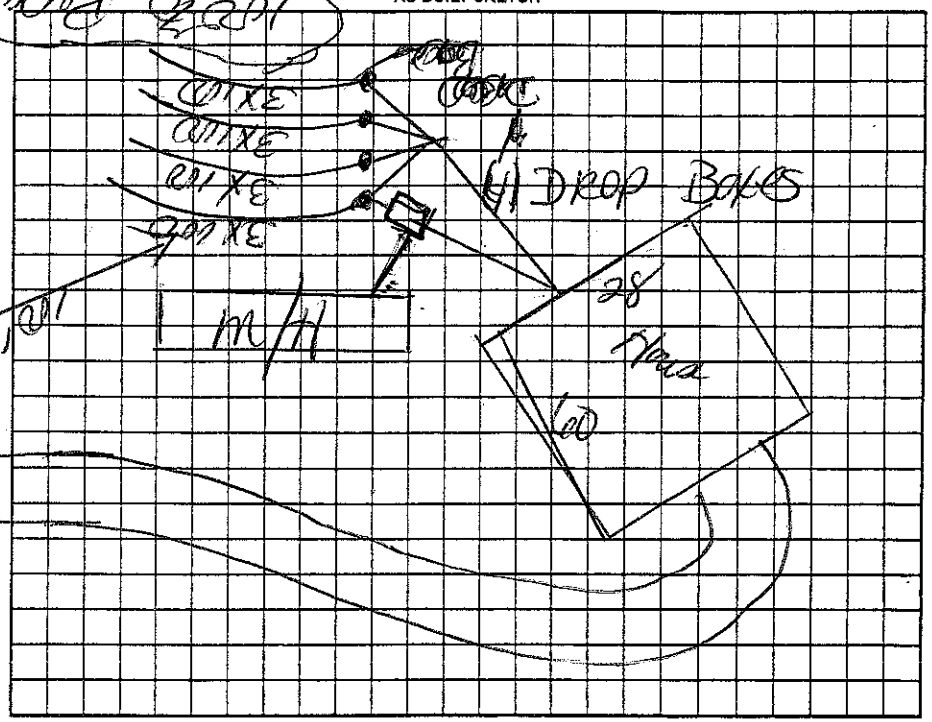

Permit can be suspended or revoked if any false information is supplied toward securing the permit/any unauthorized changes are made to the site/any unauthorized changes are made in the installation of the system. Improvement Permit with plat valid without expiration. ☐ Improvement Permit with site plan valid for sixty months ☐ Authorization to Construct is valid for a period equal to that of Improvement Permit – not to exceed sixty months.

Signed: _____ date _____ Installed by: _____

Improvement Permit by: _____ date _____ Operation Permit by: _____ date _____

Authorization to Construct by: _____ date _____ Existing System Inspection by: Kelly Cook date 4-6-06

HEALTH DEPT. COPY: WHITE OWNER COPY (FINAL): YELLOW OWNER COPY (INITIAL): PINK