IREDELL COUNTY HEALTH DEPARTMENT

STATESVILLE 704-878-5305 CI Wof MOORESVILLE 704-664-5281

CI IMPROVEMENT PERMIT / AUTHORIZATION TO CONSTRUCT / OPERATION PERMIT / EXISTING SYSTEM INSPECTION

PERMIT# 115833 PIN# ~~3792-98-4900.001~~ 3792-88-9751 DATE 10/3/03

OWNER OR CONTRACTOR Roger D. Stikeleather PHONE: Business — Home (704) 585-2658

ADDRESS P.O. Box 28 Stony Point, N.C. 28678 NEW PAVED ROAD

LOCATION I-40 W, (L) Old Mtn Rd, (R) Hwy 70 (L) Windforest (R) Woodbrook (R) Deer Creek Trail @ end on right

SUBDIVISION ~~Windforest~~ BLOCK / SECTION B LOT 7 LOT AREA 2.0 Acres SITE CLASS. PS DESIGN FLOW 600 L.T.A.R. .35 gpd/ft²

Septic Tank: 1,500 Gallons; STB 268 Date 9-19-03

Pump Tank: ______ Gallons; PT ______ Date ______

Pump Make: ______ Model ______ Serial No. ______

Nitrification Field: No Fields 1 Square Feet 1725 Linear Feet 575

No Lines 6 @ 96' Trench Width 36" Max Trench Bottom Depth 30" Gravel Depth 12"

☒ New System ☐ Repair System Type: I (II) III, IV, V, VI

System Description: Gravity Conventional

Repair System Description: Gravity, 25% Reduction

Maintenance Agreement Required: ☐ Yes ☒ No

☐ Slab ☒ Crawl Space ☐ Basement w/plumbing ☐ Basement wo/plumbing

☐ House/Mod. Home ☒ Mobile Home ☐ Business ☐ Other ______


No. Bedrooms 5 No. Bathrooms 2 No. Employees ______

Water Supply: ☒ Individual ☐ Public ☐ Community


Comments:/Conditions: (1) Install lines on contour with one (1) flow divider and five (5) drop boxes (2) Keep well 100 ft from septic system

Comments:/Conditions:
- 3rd + 4th lines end of ditch dug out + packed back with red clay + front end loader. — 123, 122, 120
- TUF Tite Filter + S.T. marker installed. — 365

INITIAL SITE SKETCH

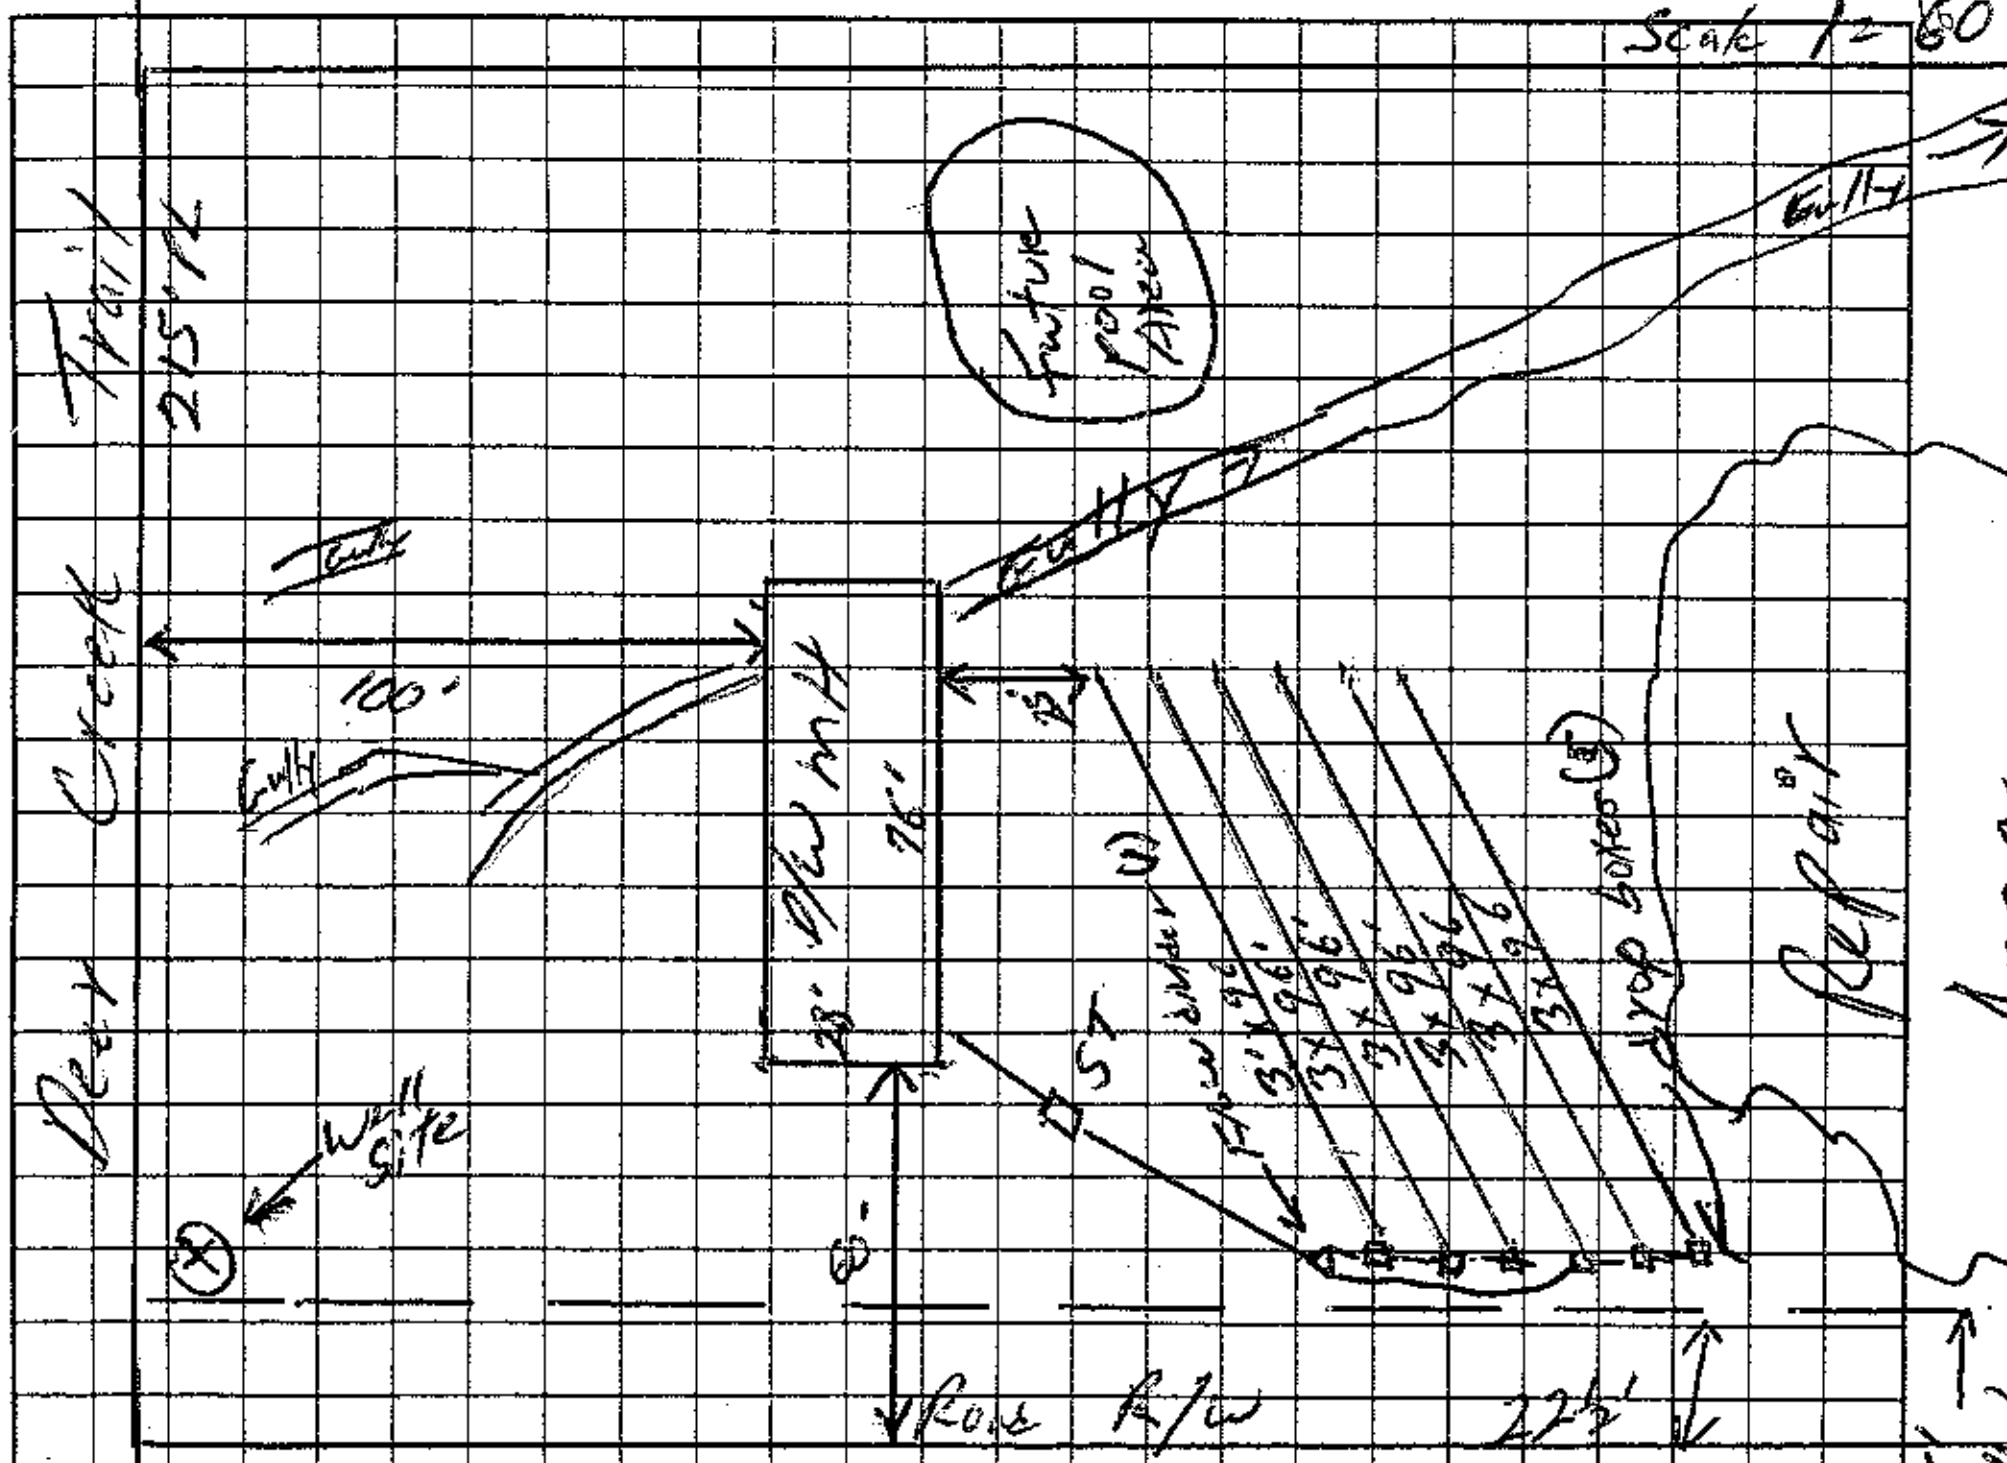

AS BUILT SKETCH

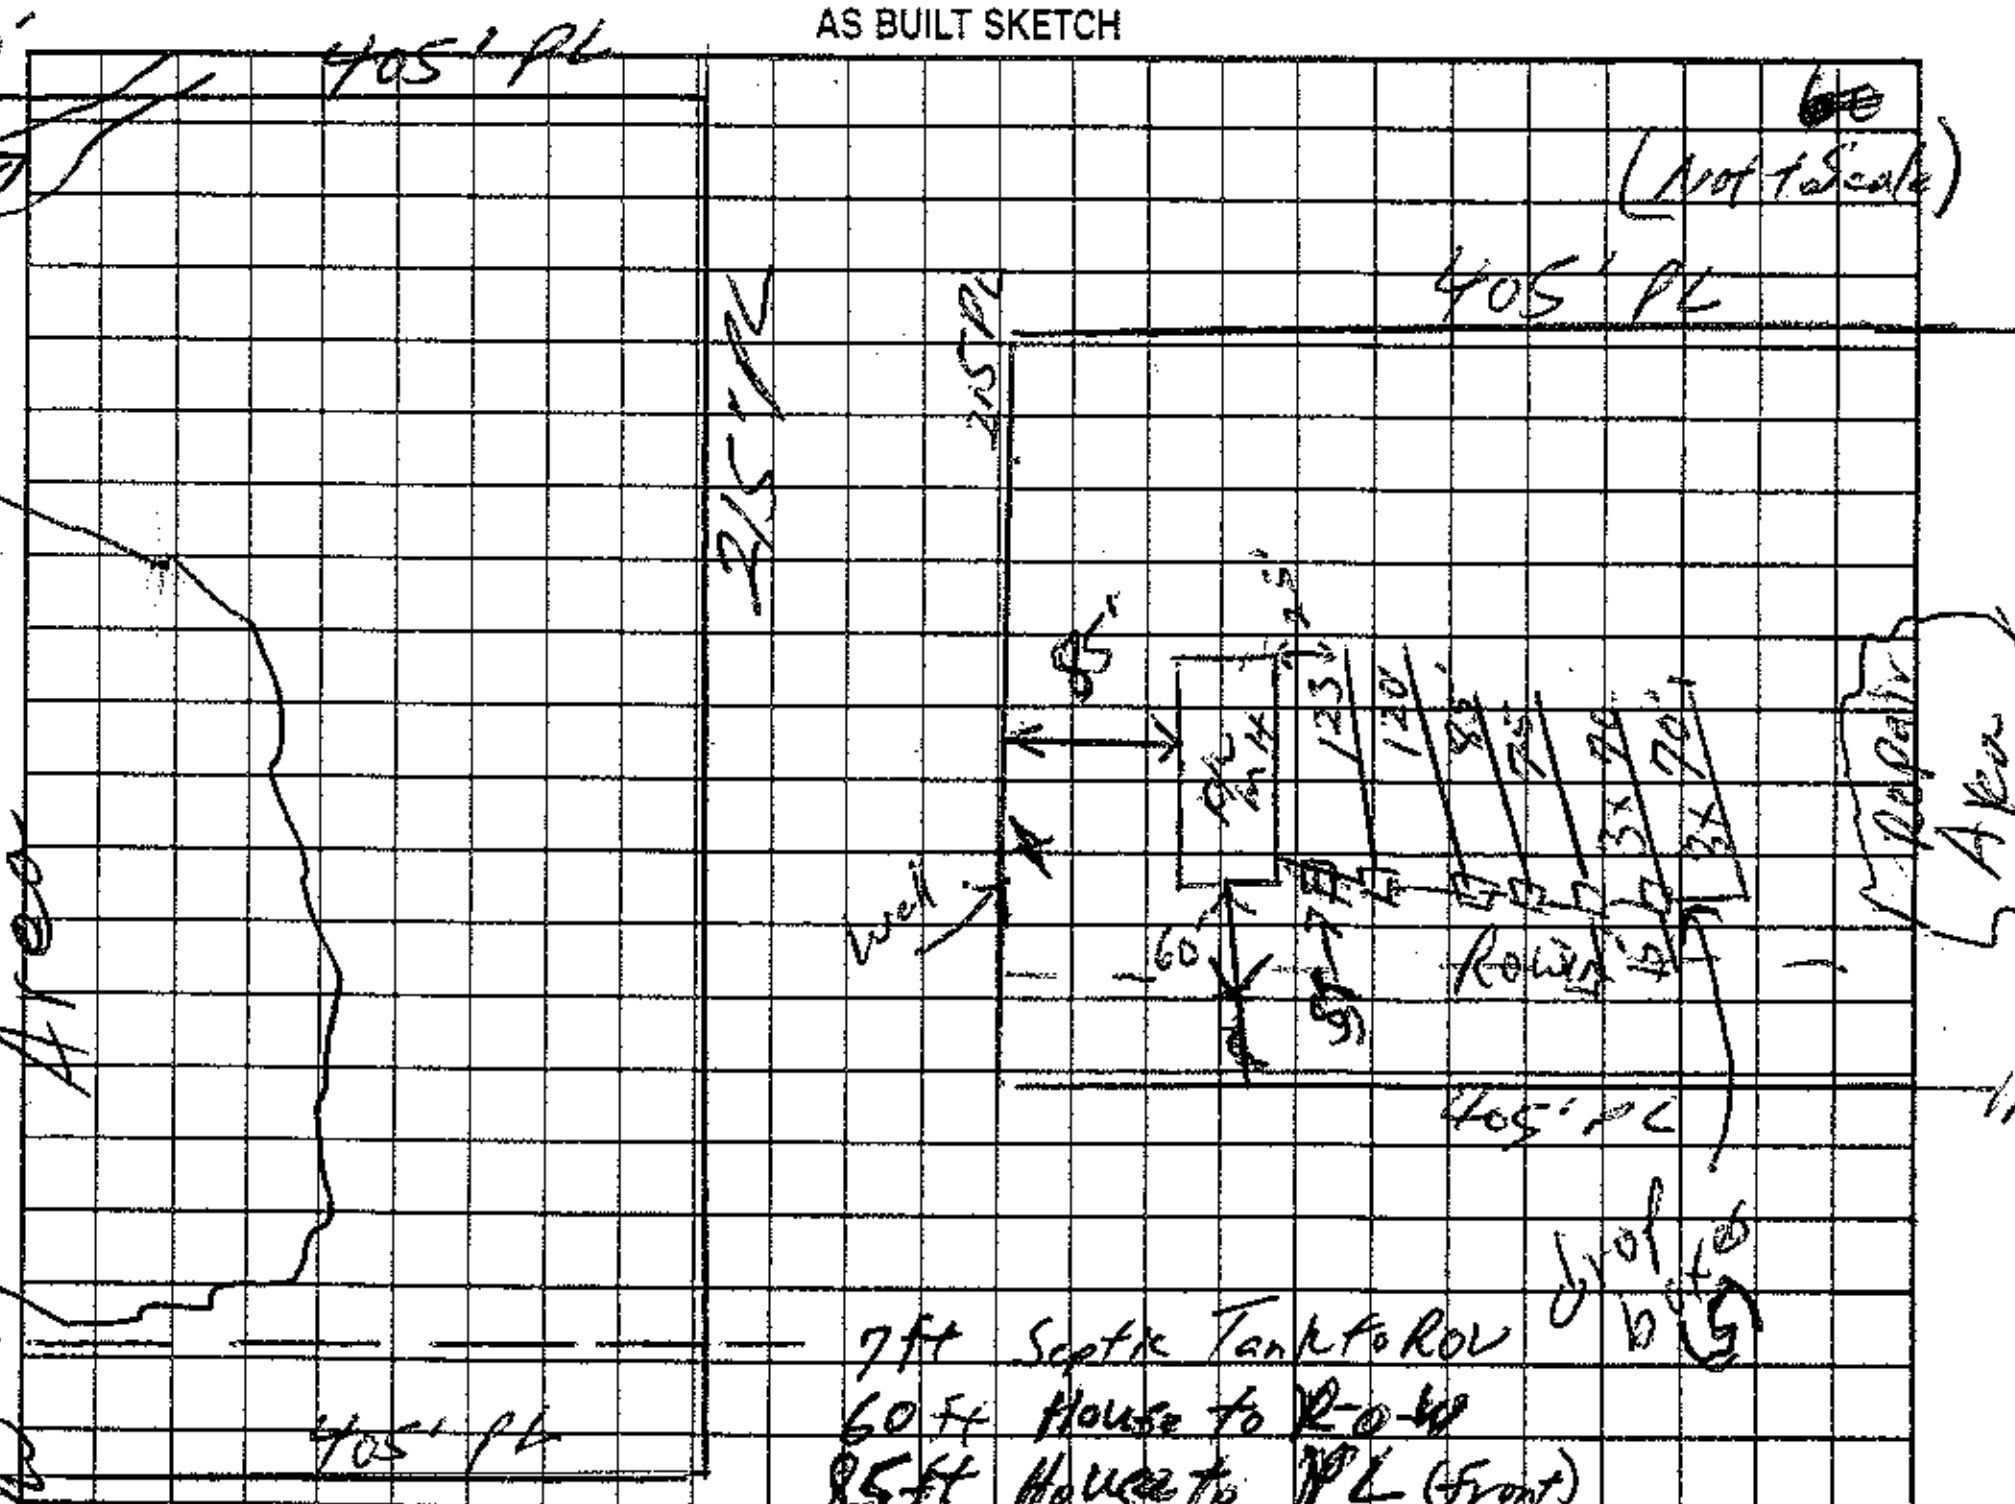

Permit can be suspended or revoked if any false information is supplied toward securing the permit/any unauthorized changes are made to the site/any unauthorized changes are made in the installation of the system. Improvement Permit with plat valid without expiration. Improvement Permit with site plan valid for sixty months. Authorization to Construct is valid for a period equal to that of Improvement Permit – not to exceed sixty months.

Signed: Jody Holland date 10/3/03 Installed by: BARNES BACKHOE & GRADING

Improvement Permit by: William O. Johnson date 10/3/03 Operation Permit by: William O. Johnson date 12-8-03

Authorization to Construct by: William O. Johnson date 10/3/03 Existing System Inspection by: ______ date ______

HEALTH DEPT. COPY: WHITE OWNER COPY (FINAL): YELLOW OWNER COPY (INITIAL): PINK