IREDELL COUNTY HEALTH DEPARTMENT

Statesville Phone TR 3-7271 Mooresville Phone NO 3-1271

PERMIT TO INSTALL SEPTIC TANK

Permit Date Nov 19 - 1964

Permit NO. _____

Owner Issie B. Rimmer Address Enfloa - N.C.

Installed By C. Hoke Address R 7 -


Location of Property out 64 W. left at Bethany Ch. Cross creek on left.

Tank		Capacity		Length of Lines		Fixtures	
Block	( )	800	( )	150'	( )	No. of Baths	(1)
Precast	(✓)	900	( )	175'	( )	Dishwasher	( )
		1000	(✓)	200'	( )	Garbage Grdr.	( )
		1100	( )	225'	(✓)	Auto-Washer	( )
		1200	( )	250'	( )	Other _____	
		Other _____		Other _____			

NOTIFY HEALTH DEPARTMENT AT LEAST EIGHT HOURS BEFORE TANK IS TO BE INSPECTED.

Final Inspection 1-19 1964 Approved (✓) Disapproved ( )

Remarks well 50' hard slope -

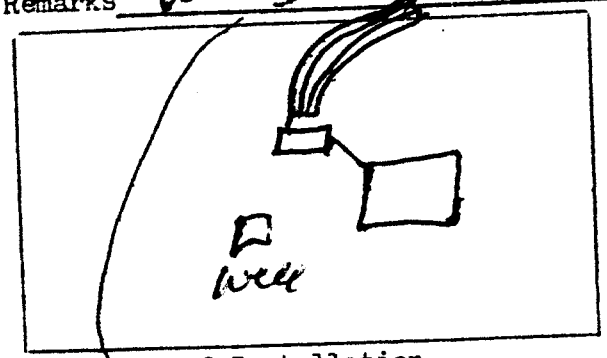

Sketch of Installation

Sanitarian