IREDELL COUNTY HEALTH DEPARTMENT

Statesville Phone TR 3-7271 — Mooresville Phone NO 3-1271

PERMIT TO INSTALL SEPTIC TANK

Permit NO. _____ Permit Date Nov 19 - 1964

Owner Glen B. Rimmer Address Enfield - N.C.

Installed By C. Hoke Address R 7 -


Location of Property out 64 W. left at Bethany Ch. Cross creek on left.

Tank		Capacity		Length of Lines		Fixtures	
Block	( )	800	( )	150'	( )	No. of Baths	(1)
Precast	(✓)	900	( )	175'	( )	Dishwasher	( )
		1000	(✓)	200'	( )	Garbage Grdr.	( )
		1100	( )	225'	(✓)	Auto-Washer	( )
		1200	( )	250'	( )	Other	
		Other		Other			

NOTIFY HEALTH DEPARTMENT AT LEAST EIGHT HOURS BEFORE TANK IS TO BE INSPECTED.

Final Inspection 1-19 1964 Approved (✓) Disapproved ( )

Remarks well 50' hard slope -

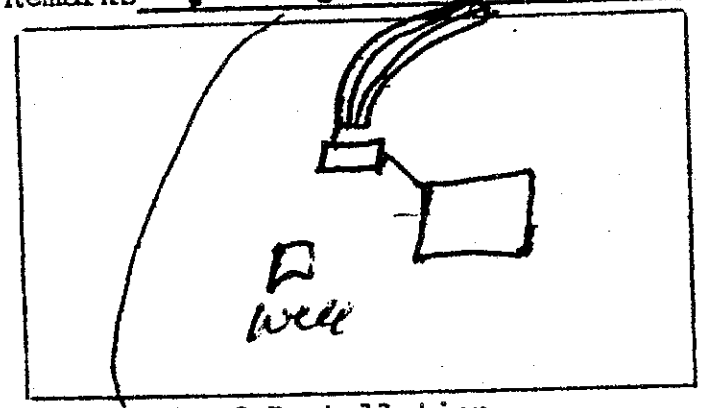

Sketch of Installation

Location of the proposed ADDITION addition does not appear to impact the existing on-site septic system.**NOTE: KEEP MIN. 25' FROM WELL

R. STEVE HENRICK REHS

Date: 5-2-2012

ICHD-Environmental Health Division

Sanitarian