IREDELL COUNTY HEALTH DEPARTMENT

STATESVILLE 704-878-5305 (J) MOORESVILLE 704-664-5281

IMPROVEMENT PERMIT / AUTHORIZATION TO CONSTRUCT / OPERATION PERMIT / EXISTING SYSTEM INSPECTION

PERMIT# 116861 PIN# 3792-68-29-044 98-3820 DATE 1/5/04

OWNER OR CONTRACTOR Roger Dale Stikeleather PHONE: Business (704) 880-8869 Home (704) 585-2658

ADDRESS P.O. Box 28 Stony Point, N.C. 28678

LOCATION Hwy 70W, Left on Wind Forest, Right on Woodbrook, Right on Deer Creek Trail, lot on left before Cul-de-Sac

SUBDIVISION "Dale's Deer Creek" BLOCK / SECTION ____ LOT 8 LOT AREA 1.03 Acres SITE CLASS. PS DESIGN FLOW 360 L.T.A.R. .025 gpd/sqft

Septic Tank: 4000 Gallons; STB 1007 Date 11-13-03
Pump Tank: ____ Gallons; PT ____ Date ____
Pump Make: ____ Model ____ Serial No. ____
Nitrification Field: No Fields 1 Square Feet 1440 Linear Feet 480
No Lines 6 Trench Width 36" Max Trench Bottom Depth 32" Gravel Depth 12"

☒ New System ☐ Repair System Type: I, ☐ II, III, IV, V, VI
System Description: Gravity Conventional
Repair System Description: Gravity, 25% Reduction
Maintenance Agreement Required: ☐ Yes ☒ No


☐ House/Mod. Home No. Bedrooms 3
☒ Mobile Home No. Bathrooms 2
☐ Business No. Employees ____
☐ Other ____
☐ Slab ☒ Crawl Space ☐ Basement w/plumbing ☐ Basement wo/plumbing

Water Supply: ☒ Individual ☐ Public ☐ Community


Comments:/Conditions: ① Keep Septic System 100ft from well ② Install Lines on Contour ③ Do not install when wet ④ Maintain Proper Setbacks

Comments:/Conditions:
1st Five lines checked okay wgd 1/14/04
Tuff-Tite filter + ST marker Installed.

INITIAL SITE SKETCH (Not to Scale)

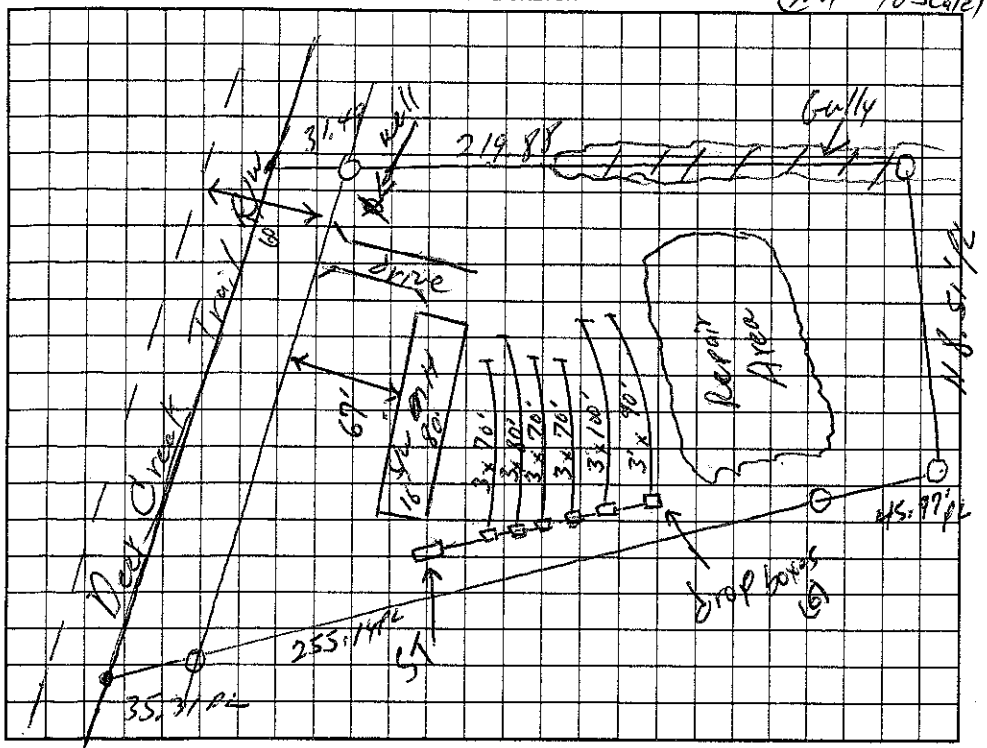

AS BUILT SKETCH

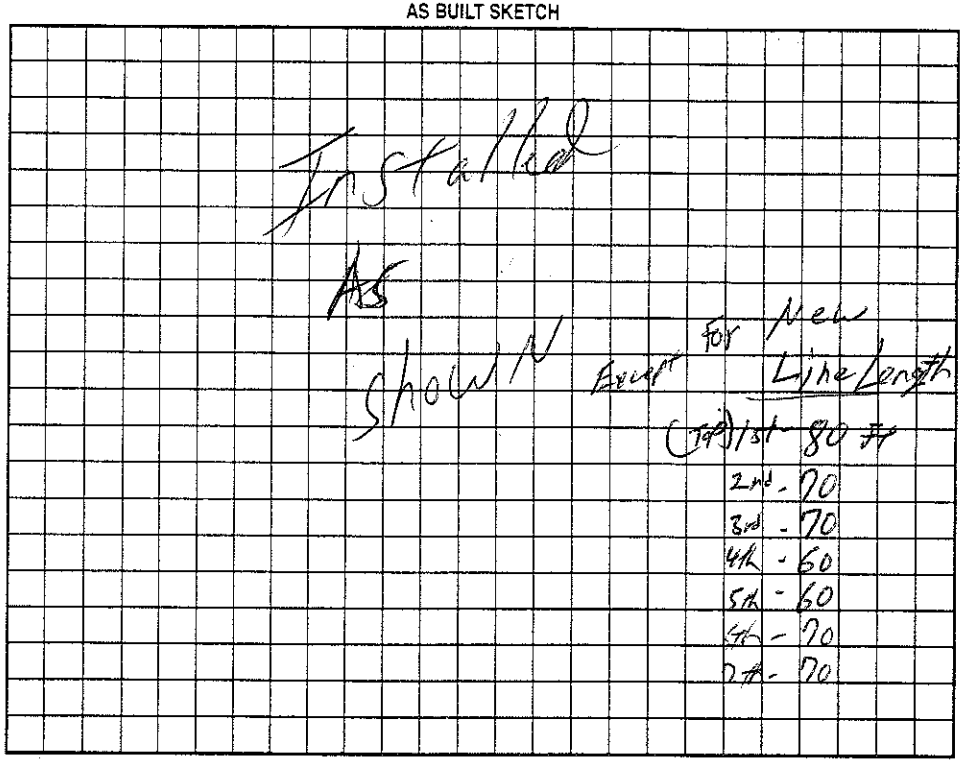

Permit can be suspended or revoked if any false information is supplied toward securing the permit/any unauthorized changes are made to the site/any unauthorized changes are made in the installation of the system. Improvement Permit with plat valid without expiration. Improvement Permit with site plan valid for sixty months. Authorization to Construct is valid for a period equal to that of Improvement Permit – not to exceed sixty months.

Signed: Roger Dale Stikeleather date ____ Installed by: Derek Barnes

Improvement Permit by: William O. Johnson date 1/5/04 Operation Permit by: William O. Johnson date 1/15/04

Authorization to Construct by: William O. Johnson date 1/5/04 Existing System Inspection by: ____ date ____

HEALTH DEPT. COPY: WHITE OWNER COPY (FINAL): YELLOW OWNER COPY (INITIAL): PINK