IREDELL COUNTY HEALTH DEPARTMENT

STATESVILLE 704-878-5305 MOORESVILLE 704-664-5281

IMPROVEMENT PERMIT / AUTHORIZATION TO CONSTRUCT / OPERATION PERMIT / EXISTING SYSTEM INSPECTION

PERMIT# 127781 PIN# 3792-99-4356 8643 DATE 7-29-05

OWNER OR CONTRACTOR PAUL ULLMER PHONE: Business 704-881-1930 Home

ADDRESS PO BOX 1276 TROUTMAN, N.C. 28166

LOCATION 70 WEST (E) WIND FORREST (R) WOOD BRIDGE (L) DEER CREEK TRL (R) MTBOX # 170

SUBDIVISION DALES DEER CREEK BLOCK / SECTION IV LOT # 13 LOT AREA 6.831 AC SITE CLASS. PS DESIGN FLOW 360 L.T.A.R. .35

Septic Tank: 1000 Gallons; STB 1012 Date 1-27-05

Pump Tank: Gallons; PT Date

Pump Make: Model Serial No.

Nitrification Field: No Fields 1 Square Feet EQ=1026 Linear Feet 257'

No Lines 3'x 86' Trench Width 36" Max Trench Bottom Depth 36" Gravel Depth N/A

☒ New System ☐ Repair System Type: I, (II), III, IV, V, VI

System Description: 60 BELOW 25% REDUCT

Repair System Description: LP/60 BELOW 25% REDUCT

Maintenance Agreement Required: ☐ Yes ☒ No

☒ House/Mod. Home No. Bedrooms 3

☐ Mobile Home No. Bathrooms 2

☐ Business No. Employees

☐ Other


☐ Slab ☐ Crawl Space ☐ Basement w/plumbing ☒ Basement wo/plumbing

Water Supply: ☒ Individual ☐ Public ☐ Community


Comments:/Conditions: (1) INSTALL LEVEL ON CONTOURS (2) MAINTAIN SETBACKS (3) ROAD DITCHES SURFACE RUNOFF

Comments:/Conditions: TUFF TITE FLOAT / MARK WELL NOT INSTALLED AT TIME OF CHECK STAY 100' WHEN DRILLED

"NOT TO SCALE" INITIAL SITE SKETCH

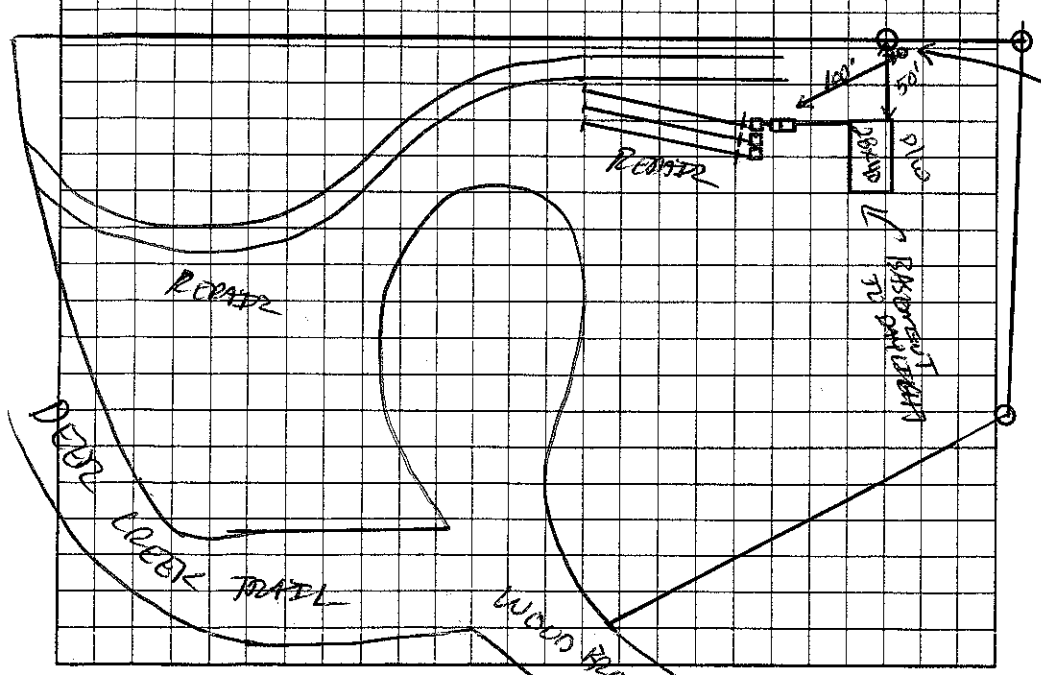

AS BUILT SKETCH

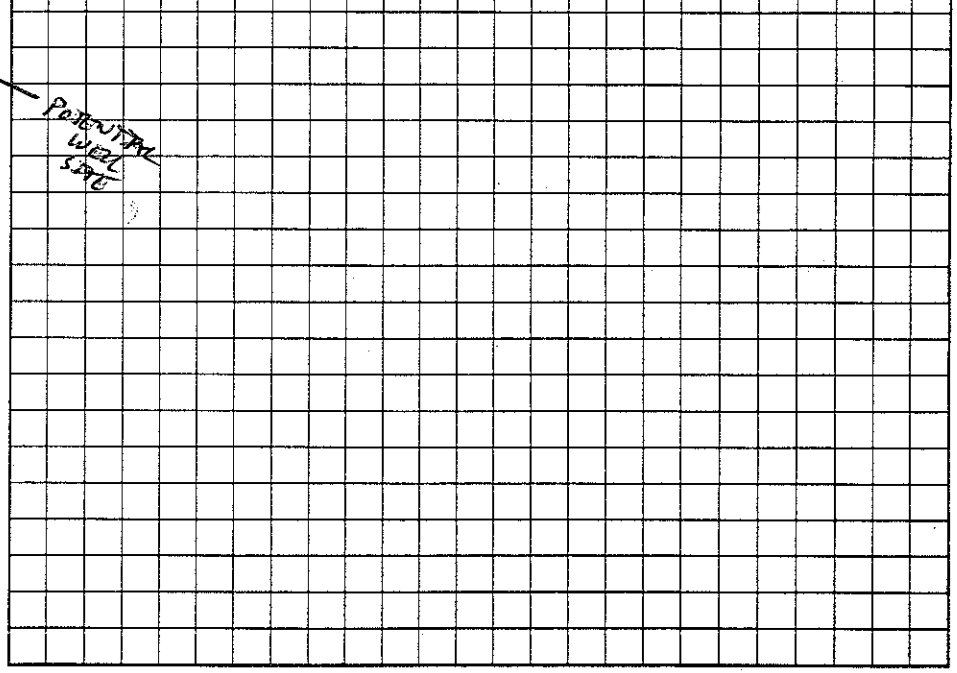

Permit can be suspended or revoked if any false information is supplied toward securing the permit/any unauthorized changes are made to the site/any unauthorized changes are made in the installation of the system. Improvement Permit with plat valid without expiration. Improvement Permit with site plan valid for sixty months. Authorization to Construct is valid for a period equal to that of Improvement Permit – not to exceed sixty months.

Signed: Dennis Gallihen date 7-29-05 Installed by: A-1 BACKHOE

Improvement Permit by: date 7/29/05 Operation Permit by: date 7-29-05

Authorization to Construct by: date 7/29/05 Existing System Inspection by: date

HEALTH DEPT. COPY: WHITE OWNER COPY (FINAL): YELLOW OWNER COPY (INITIAL): PINK