IREDELL COUNTY HEALTH DEPARTMENT

STATESVILLE 704-878-5305 MOORESVILLE 704-664-5281

IMPROVEMENT PERMIT / AUTHORIZATION TO CONSTRUCT / OPERATION PERMIT / EXISTING SYSTEM INSPECTION

PERMIT# 84442 PIN# 3793005835 DATE Nov 1 99

OWNER OR CONTRACTOR Kathryn Campbell PHONE: Business Home 873 8447

ADDRESS 323 Sharon School Rd

LOCATION Sharon School Rd Wilkes Rd Access from Sharon Ridge Lane Property on Left

SUBDIVISION Setzer BLOCK / SECTION LOT 29 LOT AREA 1.33 SITE CLASS. IB DESIGN FLOW 360 L.T.A.R. .3

Septic Tank: 1000 Gallons; STB 1012 Date 3 3 00
Pump Tank: Gallons; PT Date
Pump Make: Model Serial No.
Nitrification Field: No Fields 1 Square Feet 1200 Linear Feet 400
No Lines 4@100 Trench Width 36" Max Trench Bottom Depth 36" Gravel Depth 12"

☒ New System ☐ Repair System Type: ☒ III, IV, V, VI
System Description: Conv. GRAVITY
Repair System Description: SAME Reduction
Maintenance Agreement Required: ☐ Yes ☒ No 55.60

☒ House/Mod. Home No. Bedrooms 3
☐ Mobile Home No. Bathrooms 2
☐ Business No. Employees
☐ Other


☐ Slab ☒ Crawl Space ☐ Basement w/plumbing ☐ Basement wo/plumbing

Water Supply: ☒ Individual ☐ Public ☐ Community WELL


Comments/Conditions: Locate Well 100 Ft OR MAX FEASIBLE DISTANCE (50 Ft min) FROM SEPTIC SYSTEM 4 Drop Boxes or 3 Flow Dividers Tees PL

Comments/Conditions: Lines installed deeper than 36" due to plumbing from home.

INITIAL SITE SKETCH

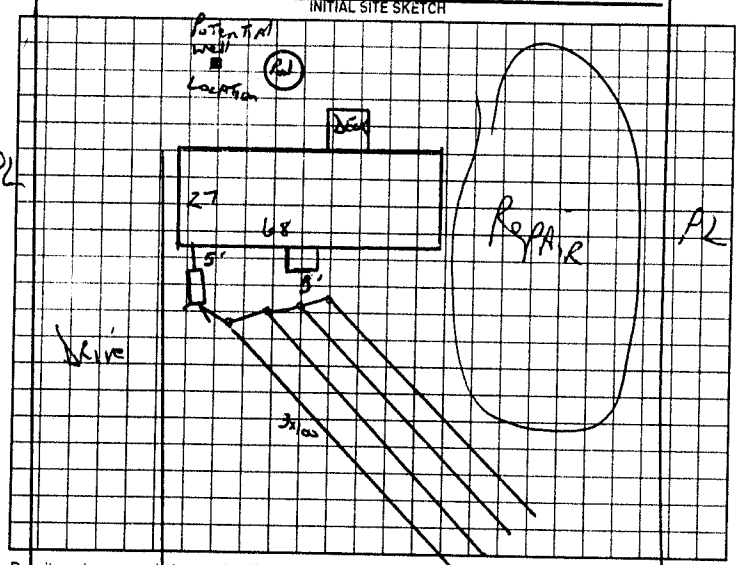

AS BUILT SKETCH

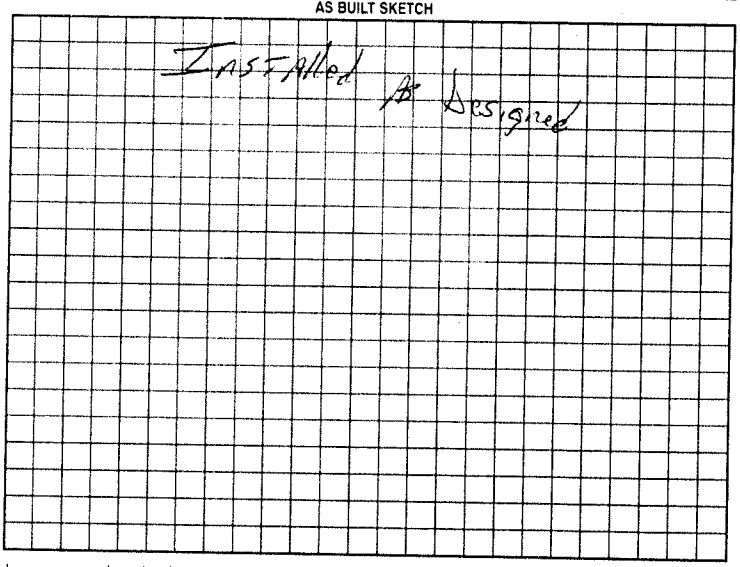

Permit can be suspended or revoked if any false information is supplied toward securing the permit/any unauthorized changes are made to the site/any unauthorized changes are made in the installation of the system. Improvement Permit with plat valid without expiration. Improvement Permit with site plan valid for sixty months. Authorization to Construct is valid for a period equal to that of Improvement Permit – not to exceed sixty months.

Signed: Kathy Campbell date 11-1-99

Improvement Permit by: R C Potter date Nov 1 99

Authorization to Construct by: R C Potter date Nov 1 99

Installed by: Yount & Son

Operation Permit by: R C Potter date May 5 2000

Existing System Inspection by: date

HEALTH DEPT COPY WHITE OWNER COPY (FINAL) YELLOW OWNER COPY (INITIAL) PINK