IREDELL COUNTY HEALTH DEPARTMENT

Statesville Office (704) 878-5305 Mooresville Office (704) 660-3625 PERMIT # 217572

IMPROVEMENT PERMIT / AUTHORIZATION TO CONSTRUCT / OPERATION PERMIT / EXISTING SYSTEM

PIN # 3793039032

APPLICANT: Jimmy Gentry APPLICANT ADDRESS: 156 Kingswood Rd.

SITE ADDRESS: 450 Sharon School Rd. PHONE: 704-902-1535 ALT. PHONE: N/A

SITE DIRECTIONS: I-40W to Sharon School Exit TL Sharon School Rd Property on left just passed MacMillan Rd.


SUBDIVISION: N/A SECTION: N/A LOT # N/A LOT AREA: 3.10 acres DESIGN FLOW: 480gpd L.T.A.R.: 0.3

Septic Tank	1000 (gal)	STB	760	Date	2-24-16	☐ New System	☑ Repair	☐ Expansion	System Type: I II III IV V VI	☑ Residence	No. Bedrooms 4
Pump Tank	N/A (gal)	PT	N/A	Date	N/A	System Description:				☐ Business	No. Persons 8
Pump Make	N/A	Model	Polylok	Serial #	PL-64	Repair System Description:	25% Reduction			☐ Other	No. Employees
# Nitrification Fields	1	# Lines	4	Linear Ft:	400	Maintenance Agreement Required:	☐ YES	☑ NO		☐ Slab	☑ Crawl Space
Trench Width	36"	Max. Trench Bottom Depth	36"	Gravel Depth	N/A		☐ GRAVITY	☐ PRESSURE		☐ Basement w/plumbing	☐ Basement w/o plumbing


Water Supply: ☑ Private ☐ Public ☐ Community

Comments / Conditions: Pump & crush existing tank. Set new tank @ location shown below. Install a 25% Reduction system on contour with serial distribution.

INITIAL SITE SKETCH

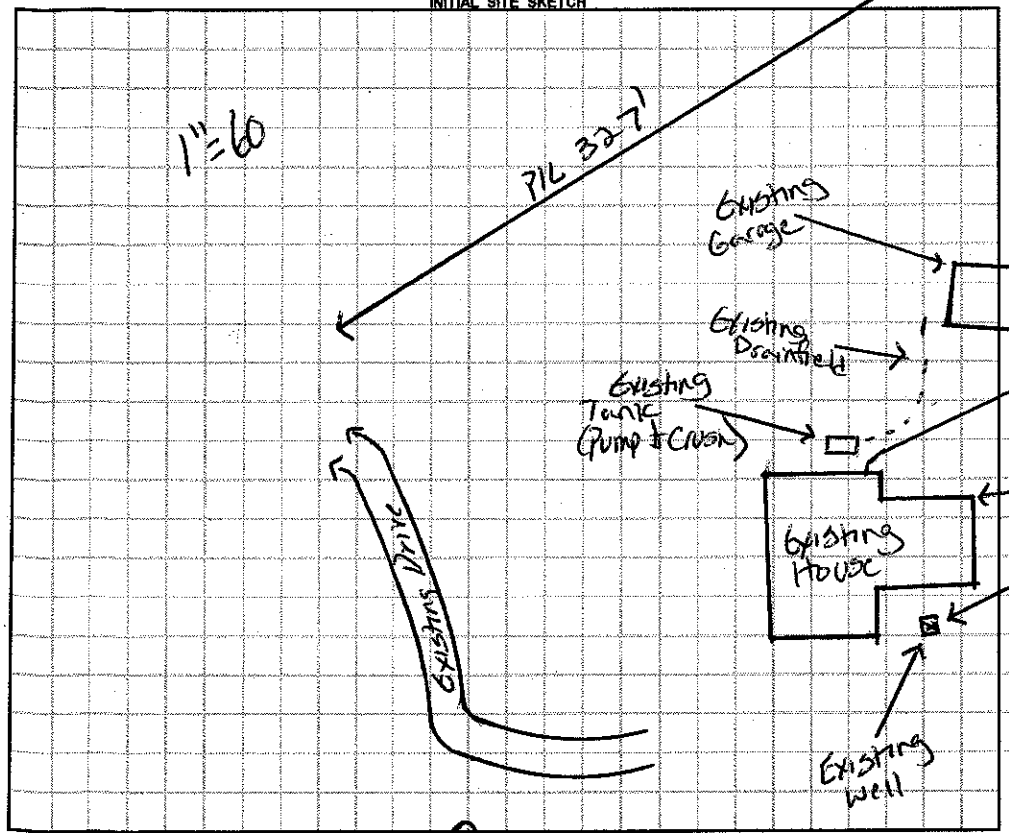

AS BUILT SKETCH

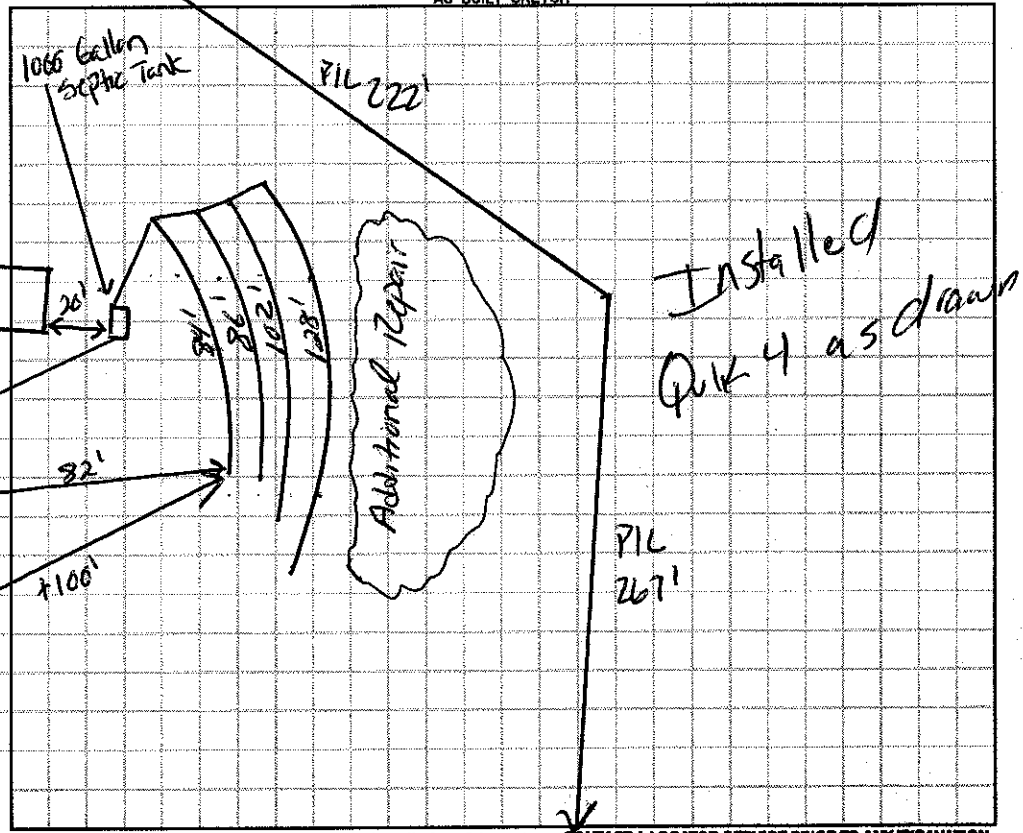

Permit can be suspended or revoked if any false information is supplied toward securing the permit / any unauthorized changes are made to the site / any unauthorized changes are made in the installation of the system. **CONTACT A LOCATOR SERVICE PRIOR TO ANY EXCAVATION**

☐ **IMPROVEMENT PERMIT** *with plat valid without expiration.* ☑ **IMPROVEMENT PERMIT** *with site plan valid for 60 mos.* ☑ **AUTHORIZATION TO CONSTRUCT** *valid for period equal to IMPROVEMENT PERMIT--not to exceed 60 mo.*

Owner / Applicant Signature: Date: 4-5-16 Installed by: Gunter Grading

IMPROVEMENT PERMIT by: Date: 4-5-16 OPERATION PERMIT by: Date: 05/18/16

AUTHORIZATION TO CONSTRUCT by: Date: 4-5-16 Existing System Inspected by: Date:

Health Dept. Copy - WHITE Applicant (Final Approval) - YELLOW Applicant (Conditional Approval) - PINK