IREDELL COUNTY HEALTH DEPARTMENT

STATESVILLE 704-878-5305 CI MOORESVILLE 704-664-5281

IMPROVEMENT PERMIT / AUTHORIZATION TO CONSTRUCT / OPERATION PERMIT / EXISTING SYSTEM INSPECTION

PERMIT# 111982 PIN# 3793-10-~~4423~~-5671 DATE 4/21/03

OWNER OR CONTRACTOR Tim Perry PHONE: Business (704) 871-8353 Home —

ADDRESS 316 Sharon School Rd Statesville, NC 28677

LOCATION I-40 W, (L) Sharon School Rd, on Left beside of Auction House

SUBDIVISION — BLOCK / SECTION — LOT — LOT AREA 10.98 Ac. SITE CLASS PS DESIGN FLOW 360 L.T.A.R. .33 gpd/ft²

Ex

Septic Tank: 1,000 Gallons; STB 312 Date 11-6-98

Pump Tank: — Gallons; PT — Date —

Pump Make: — Model Envirotech Serial No. —

Nitrification Field: No Fields 1 Square Feet 405 Linear Feet 90'

No Lines 3 Trench Width 36" Max Trench Bottom Depth 36" Gravel Depth 18"

☒ New System ☐ Repair System Type: I, (II), III, IV, V, VI

System Description: Gravity Conventional

Repair System Description: Gravity Conventional

Maintenance Agreement Required: ☐ Yes ☐ No

☐ House/Mod. Home ☒ Mobile Home ☐ Business ☐ Other

No. Bedrooms 3 No. Bathrooms 2 No. Employees —


☐ Slab ☒ Crawl Space ☐ Basement w/plumbing ☐ Basement wo/plumbing

Water Supply: ☐ Individual ☒ Public ☐ Community


Comments:/Conditions: ① Add 3 Lines 45, 23, 22 ft lengths with 18" of gravel ② Install surface drainage ditch to divert water off of system. (Not to Scale)

Comments:/Conditions:

INITIAL SITE SKETCH

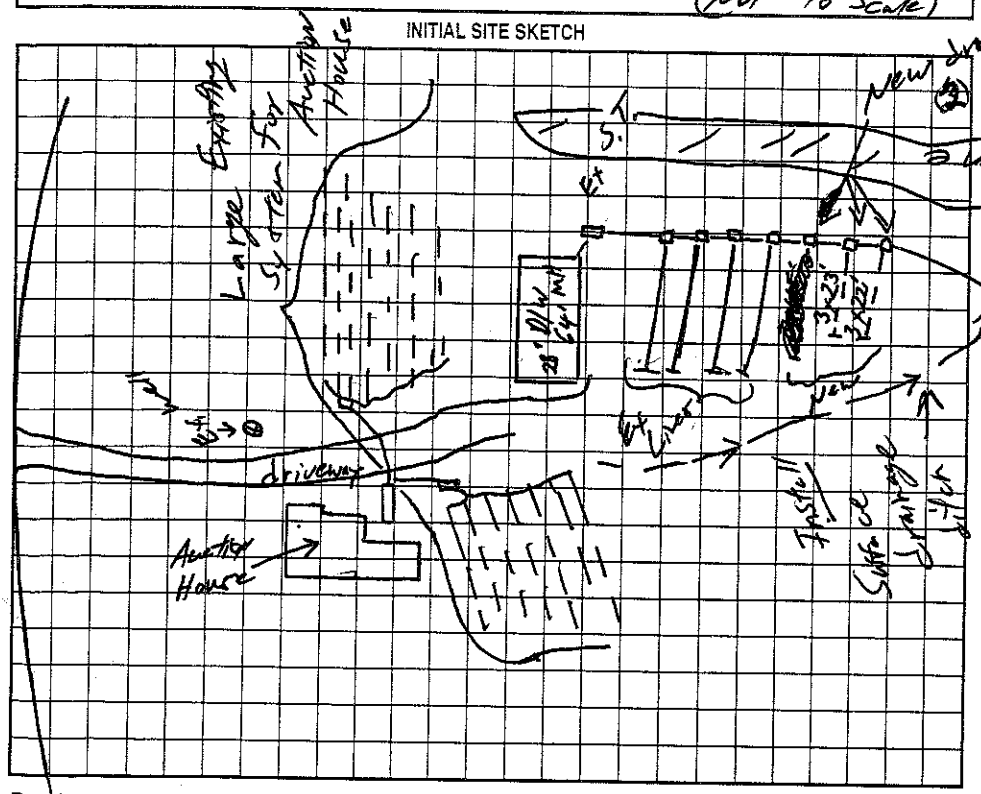

AS BUILT SKETCH

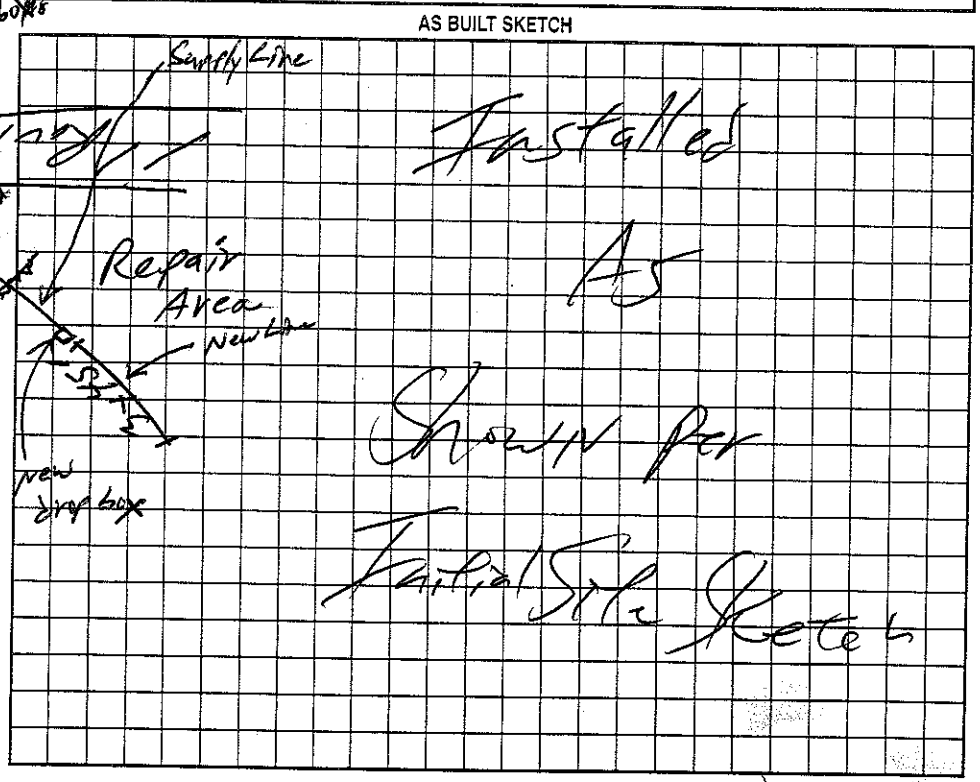

Permit can be suspended or revoked if any false information is supplied toward securing the permit/any unauthorized changes are made to the site/any unauthorized changes are made in the installation of the system. Improvement Permit with plat valid without expiration. Improvement Permit with site plan valid for sixty months. Authorization to Construct is valid for a period equal to that of Improvement Permit – not to exceed sixty months.

Signed: Tim Perry date 4-22-03

Improvement Permit by: William O. Johnson date 4/22/03

Authorization to Construct by: William O. Johnson date 4/22/03

Installed by: Mark Wingler

Operation Permit by: William O. Johnson date 5/19/03

Existing System Inspection by: — date —

HEALTH DEPT. COPY: WHITE OWNER COPY (FINAL): YELLOW OWNER COPY (INITIAL): PINK