IREDELL COUNTY HEALTH DEPARTMENT

STATESVILLE 704-878-5305 MOORESVILLE 704-664-5281

IMPROVEMENT PERMIT / AUTHORIZATION TO CONSTRUCT / OPERATION PERMIT / EXISTING SYSTEM INSPECTION

PERMIT# 093887 PIN# 3793 11 1184 DATE 01-26-01

OWNER OR CONTRACTOR LEADER HOMES / SANDIE GAITHER PHONE: Business 662-8436 Home

ADDRESS 354 SHARON SCHOOL RD Statesville, NC 28677

LOCATION 40 W, L on Sharon School RD, On corner of Sharon School & Sharon Ridge

SUBDIVISION SHARON RIDGE BLOCK / SECTION LOT 1 LOT AREA 1.0 ACRES SITE CLASS DESIGN FLOW 360 L.T.A.R.

Septic Tank: EXISTING Gallons; STB Date

Pump Tank: Gallons, PT Date

Pump Make: Model Serial No

Nitrification Field: No Fields Square Feet Linear Feet

No Lines Trench Width Max Trench Bottom Depth Gravel Depth

☐ New System ☐ Repair System Type: I. II. III. IV. V. VI

System Description: EXISTING

Repair System Description:

Maintenance Agreement Required: ☐ Yes ☐ No

☐ House/Mod. Home No. Bedrooms 3

☒ Mobile Home DW No. Bathrooms 2

☐ Business No. Employees

☐ Other


☐ Slab ☐ Crawl Space ☐ Basement w/plumbing ☐ Basement wo/plumbing

Water Supply: ☐ Individual ☒ Public ☐ Community


Comments:/Conditions: ① SYSTEM TO DEEP TO PROBE + OLD PERMIT WAS NOT FOUND ② 3 BEDROOM TO 3 BEDROOM ③ At time of check the system was not failing. ④ Everything looks OK!

Comments:/Conditions:

INITIAL SITE SKETCH

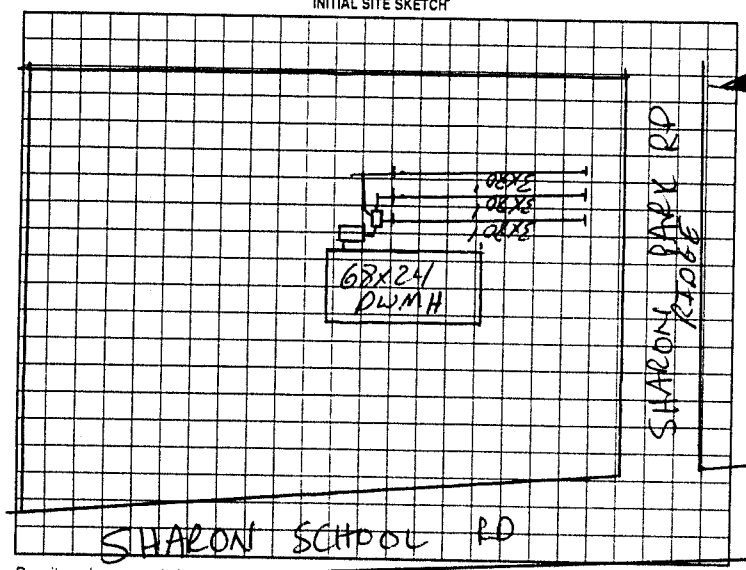

AS BUILT SKETCH

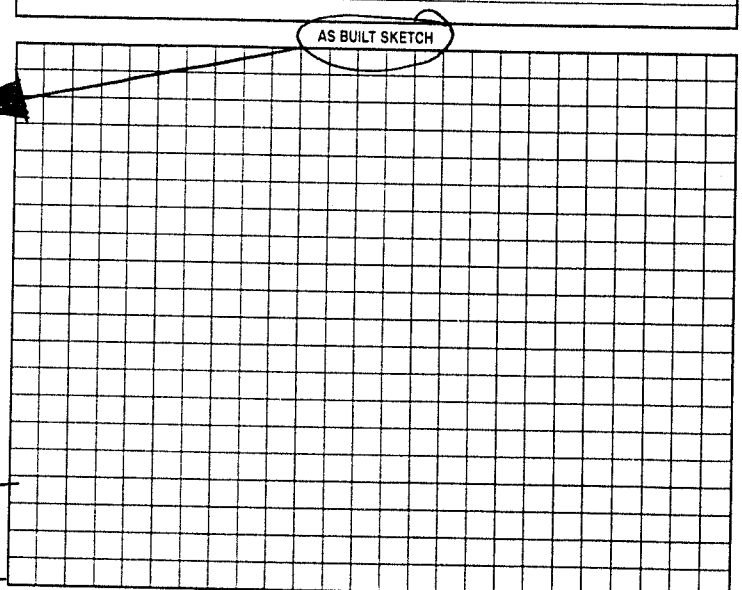

Permit can be suspended or revoked if any false information is supplied toward securing the permit/any unauthorized changes are made to the site/any unauthorized changes are made in the installation of the system. Improvement Permit with plat valid without expiration. Improvement Permit with site plan valid for sixty months. Authorization to Construct is valid for a period equal to that of Improvement Permit – not to exceed sixty months.

Signed: date Installed by:

Improvement Permit by: date Operation Permit by: date

Authorization to Construct by: date Existing System Inspection by: Tom Cook REHS date 01-26-01

HEALTH DEPT. COPY: WHITE OWNER COPY (FINAL): YELLOW OWNER COPY (INITIAL): PINK