IREDELL COUNTY HEALTH DEPARTMENT

IMPROVEMENT PERMIT / AUTHORIZATION TO CONSTRUCT / OPERATION PERMIT / EXISTING SYSTEM INSPECTION

STATESVILLE 704-878-5305 MOORESVILLE 704-664-5281

Addition

PERMIT# 89882 PIN# 379311 3104

OWNER OR CONTRACTOR Carl Johnson

ADDRESS 111 Sharon Ridge Ln Statesville, NC PHONE: Business ______ DATE June 14 2000

Home 872 0723

LOCATION I40 W Sharon School Exit (L) (L) Sharon Ridge Ln 2nd Rd Left 2nd Mobile home on Left # 111

SUBDIVISION Sharon Ridge BLOCK / SECTION ______ LOT 2 LOT AREA 1 Ac SITE CLASS PS DESIGN FLOW 480 L.T.A.R. .5 per 5 Brown 1985

Septic Tank: 1000 Existing Gallons; STB ______ Date ______

Pump Tank: ______ Gallons; PT ______ Date ______

Pump Make: ______ Model ______ Serial No. ______

Nitrification Field: No Fields 2 Square Feet 799 eq ft Linear Feet 200 LnFt

No Lines 3 Trench Width 36" Max Trench Bottom Depth 36" Gravel Depth ______

☒ New System ☐ Repair System Type I, II, (III), IV, V, VI

System Description: 25% Reduction Gravity

Repair System Description: ______

Maintenance Agreement Required: ☐ Yes ☒ No

☐ Slab ☒ Crawl Space ☐ Basement w/plumbing ☐ Basement wo/plumbing

☐ House/Mod Home ☒ Mobile Home Addition ☐ Business ☐ Other

No. Bedrooms 4 No. Bathrooms ______ No. Employees ______

Water Supply: ☐ Individual ☒ Public ☐ Community


Comments:/Conditions: Level old Tank or Replace. Replace existing D-Box w/ Distribution box w/ speed levels

20 HDS Sections or 32 Chambers

Comments /Conditions: 2nd (Lower) old Line cut off at Dist Box due to compaction and continued failure at end of line

Call 928-2030 if questions

INITIAL SITE SKETCH

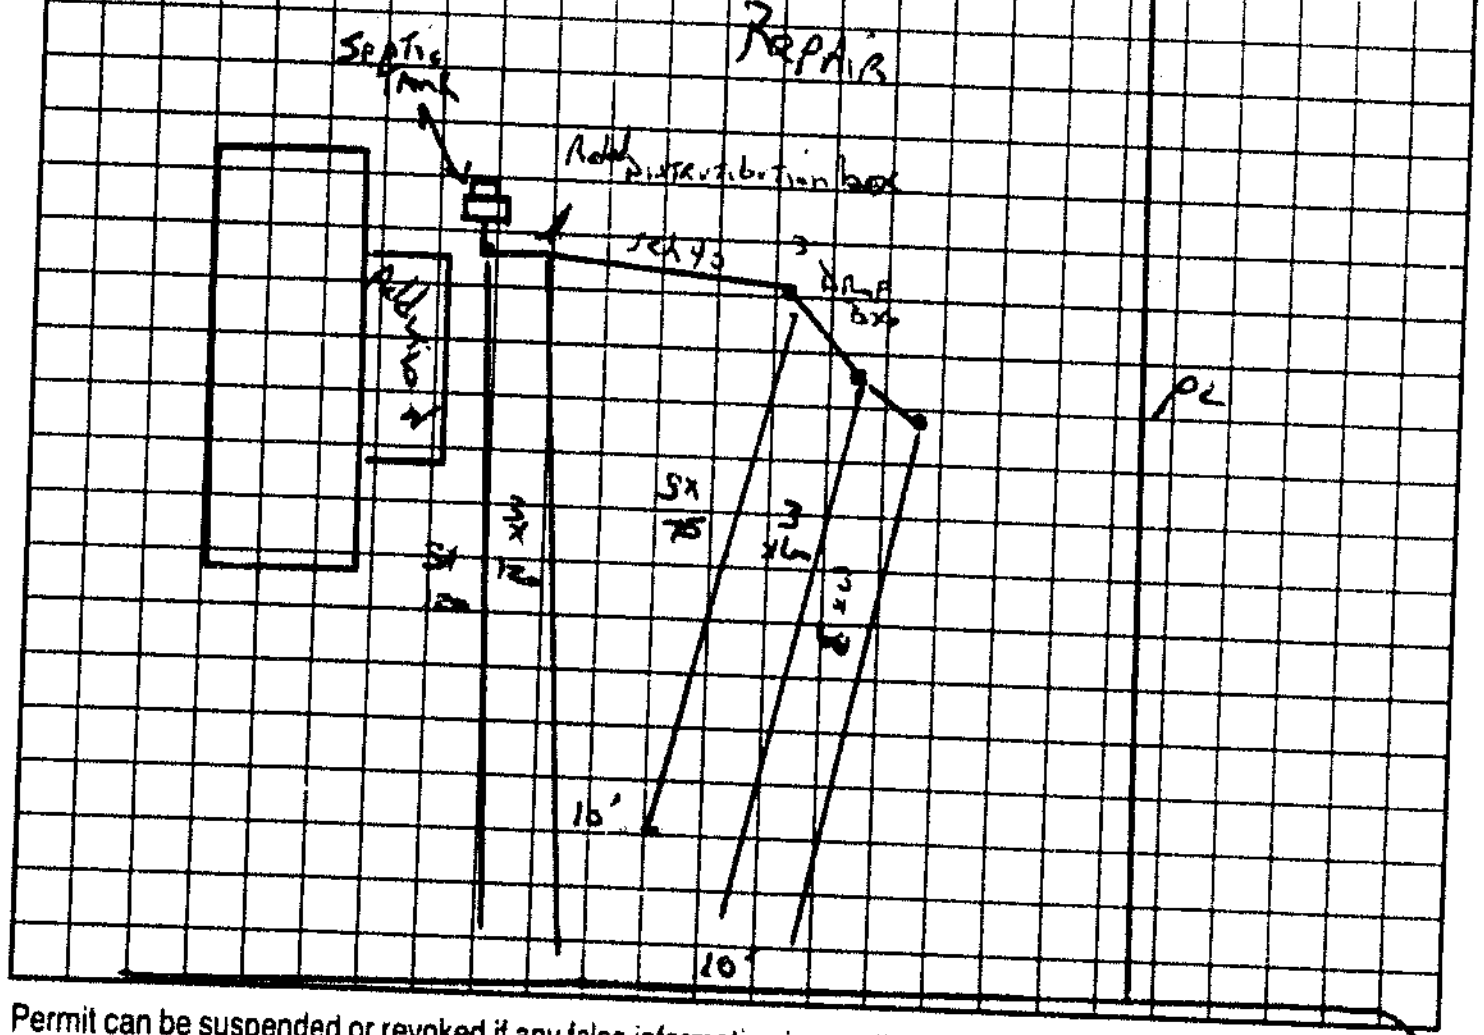

AS BUILT SKETCH

Total (old + New) equal to 380 LnFt Installed

New System Installed As Shown

Permit can be suspended or revoked if any false information is supplied toward securing the permit/any unauthorized changes are made to the site/any unauthorized changes are made in the installation of the system. Improvement Permit with plat valid without expiration. Improvement Permit with site plan valid for sixty months. Authorization to Construct is valid for a period equal to that of Improvement Permit – not to exceed sixty months.

Signed: Carl Johnson date June 14 2000

Improvement Permit by: J C Potter date June 14 2000

Authorization to Construct by: J C Potter date June 14 2000

Installed by: C + W

Operation Permit by: J C Potter date June 30 2000

Existing System Inspection by: ______ date ______

HEALTH DEPT. COPY: WHITE OWNER COPY (FINAL): YELLOW OWNER COPY (INITIAL): PINK