IREDELL COUNTY HEALTH DEPARTMENT

4:00

Statesville Office (704) 878-5305 Mooresville Office (704) 660-3625

SEPTIC IMPROVEMENT PERMIT / AUTHORIZATION TO CONSTRUCT / OPERATION PERMIT / EXISTING SYSTEM

PERMIT # 240660

PIN # 3793137898.000

APPLICANT/OWNER: Jimmy Gentry

APPLICANT ADDRESS: 156 Kingswood Rd Statesville NC

SITE ADDRESS: 117 Broken Arrow Drive Statesville NC 28677

PHONE: 704 902 1535 ALT. PHONE –

SITE DIRECTIONS: I 40 to Sharon School/ Left. Thn Left on Mock Mill Rd RT on Broken Arrow

SAP CONTROLLED: ☐ YES ☒ NO

SUBDIVISION: Buffalo Shoals National Golf Club Estates SECTION: A LOT # 1 LOT AREA: 0.87 Acres

DESIGN FLOW: 360 L.T.A.R.: .3

Septic Tank	1000 (gal)	STB	760	Date	5-12-19
Pump Tank	(gal)	PT		Date	
Pump Make		Model		Serial #	
# Nitrification Fields	1	# Lines	7	Linear Ft	300
Trench Width	36	Trench Bottom Depth(Low side)	24	Gravel Depth	–

☑ New System ☐ Repair ☐ Expansion System Type: I II (III) IV V VI

System Description: Gravity 25% Reduction

Repair System Description: LP Panel Block 50% Reduction

Maintenance Agreement Required: ☐ YES ☑ NO

☑ GRAVITY ☐ PRESSURE

☑ Residence ☐ Business ☐ Other ☐ Slab ☐ Basement w/plumbing

No. Bedrooms 3 No. Persons 6 No. Employees ☑ Crawl Space


Water Supply: ☐ Private ☑ Public ☐ Community

☐ Basement w/o plumbing

Comments / Conditions: No Foundation Drains on Front of House if Drains are used there must be a 15ft offset. Install Septic drainlines on the contour of the land and utilize Serial distribution.

Do not Drive, park, pave, or grade or bury utilities in drainfield area.

INITIAL SITE SKETCH

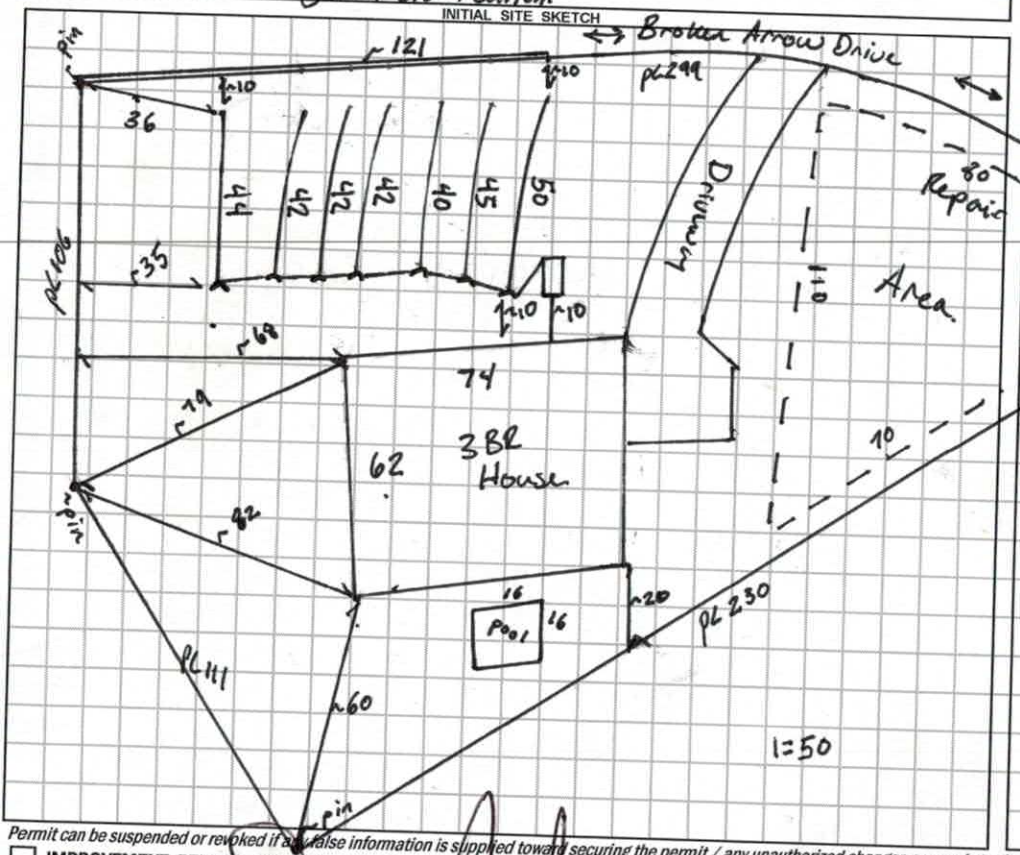

AS BUILT SKETCH

Installed As Drawn

Permit can be suspended or revoked if any false information is supplied toward securing the permit / any unauthorized changes are made to the site / any unauthorized changes are made in the installation of the system. **CONTACT A LOCATOR SERVICE PRIOR TO ANY EXCAVATION**

☐ **IMPROVEMENT PERMIT** *with plat valid without expiration.* ☐ **IMPROVEMENT PERMIT** *with site plan valid for 60 mos.* ☒ **AUTHORIZATION TO CONSTRUCT** *valid for period equal to IMPROVEMENT PERMIT--not to exceed 60 mo.*

Owner / Applicant Signature: Date:

IMPROVEMENT PERMIT by: Benjamin A. Bullard Date: 12/21/2018

AUTHORIZATION TO CONSTRUCT by: Carla C. Cave Date: 2/28/19

Installed by: Craig Thompson Grading

OPERATION PERMIT by: Date: 8-12-19

Existing System Inspected by: Date:

FOR SEPTIC FINAL INSPECTION: CALL 704-664-3703 between 8am-9am the day the inspection is needed. Be sure to speak with an inpsector to confirm your inspection time.

DEPARTMENT OF HEALTH AND HUMAN SERVICES
DIVISION OF PUBLIC HEALTH, ENVIRONMENTAL HEALTH SECTION
ON-SITE WATER PROTECTION BRANCH

Sheet 1 of 1
PROPERTY ID #: 3795157

SOIL/SITE EVALUATION
for ON-SITE WASTEWATER SYSTEM
(Complete all fields in full)

OWNER: Jimmy Gentry
ADDRESS: 156 Wigwam Drive.
PROPOSED FACILITY: 3BR Home
PROPOSED DESIGN FLOW (.1949): 360
WATER SUPPLY: ☐ Private ☑ Public ☐ Well ☐ Spring ☐ Other
EVALUATION METHOD: ☐ Auger Boring ☑ Pit ☐ Cut
TYPE OF WASTEWATER: ☑ Sewage ☐ Industrial Process ☐ Mixed

APPLICATION DATE 11/27/18
DATE EVALUATED: 12/17/18
PROPERTY SIZE: .87 Ac
PROPERTY RECORDED: yes

PROFILE #	.1940 LANDSCAPE POSITION/ SLOPE %	HORIZON DEPTH (IN.)	SOIL MORPHOLOGY (.1941) .1941 STRUCTURE/ TEXTURE	SOIL MORPHOLOGY (.1941) .1941 CONSISTENCE/ MINERALOGY	OTHER PROFILE FACTORS .1942 SOIL WETNESS/ COLOR	.1943 SOIL DEPTH	.1956 SAPRO CLASS	.1944 RESTR HORIZ	PROFILE CLASS & LTAR
1	Side 0-10%	0-18	C SBK	SS SP FR SEP		46		Clay Loam Sap c/46.	PS .30.
		18-40	CL WSBK	SS SP FR					
		40-46	LSap M	NS NP V FR					
		46-60	CL Sap M	W.S.					
2	Side 0-10%	0-31	C SBK	SS SP FR SEP		54			PS .30.
		31-54	CL WSBK	SS SP FR					
		54-60.	LSap. M	NS NP V FR					
3	Side 0-10%	0-33	C SBK	SS SP FR SEP		60			PS .30.
		33-60	CL WSBK	SS SP FR					
		60-65	LSap M	NS NP V FR					
4	Side 0-10%	0-40	C SBK	SS SP FR SEP		57			PS .30.
		40-57	CL WSBK	SS SP FR					
		57-69	LSap. M	NS NP V FR					

DESCRIPTION	INITIAL SYSTEM	REPAIR SYSTEM
Available Space (.1945)	300	200
System Type(s)	II 25%	IV 50%
Site LTAR	.30	.30

OTHER FACTORS (.1946): Foundation Drain
SITE CLASSIFICATION (.1948): PS
EVALUATED BY: Bobbie
OTHER(S) PRESENT: Boggs.

COMMENTS:

LEGEND

use the following standard abbreviations

LANDSCAPE POSITION

CC (Concave Slope)
CV (Convex Slope)
D (Drainage Way)
DS (Debris Slump)
FP (Flood Plain)
FS (Foot Slope)
H (Head Slope)
L (Linear Slope)
N (Nose Slope)
R (Ridge)
S (Shoulder Slope)
T (Terrace)

GROUP	SOIL TEXTURE	CONVENTIONAL .1955 LTAR*	LPP .1957 LTAR*
I	S (Sand) LS (Loamy Sand)	1.2 - 0.8	0.6 - 0.4
II	SL (Sandy Loam) L (Loam)	0.8 - 0.6	0.4 - 0.3
III	Si (Silt) SiCL (Silty Clay Loam) CL (Clay Loam) SCL (Sandy Clay Loam) SiL (Silt Loam)	0.6 - 0.3	0.3 - 0.15
IV	SC (Sandy Clay) SiC (Silty Clay) C (Clay) O (Organic)	0.4 - 0.1 None	0.2 - 0.05 None

MINERALOGY/ CONSISTENCE

SEXP (Slightly Expansive)
EXP (Expansive)

MOIST

VFR (Very Friable)
FR (Friable)
FI (Firm)
VFI (Very Firm v. Very Sticky)
EFI (Extremely Firm)

STRUCTURE

G (Single Grain)
M (Massive)
CR (Crumb)
GR (Granular)
SBK (Subangular Blocky)
ABK (Angular Blocky)
PL (Platy)
PR (Prismatic)

WET

NS (Non-sticky)
SS (Slightly Sticky)
S (Sticky)
VS (Very Sticky)
NP (Non-plastic)
SP (Slightly Plastic)
P (Plastic)
VP (Very Plastic)


*Adjust LTAR due to depth, consistence, structure, soil wetness, landscape, position, wastewater flow and quality.

NOTES

HORIZON DEPTH	In inches below natural soil surface
DEPTH OF FILL	In inches from land surface
RESTRICTIVE HORIZON	Thickness and depth from land surface
SAPROLITE	S(suitable) or U(unsuitable)
SOIL WETNESS	Inches from land surface to free water or inches from land surface to soil colors with chroma 2 or less - record Munsell color chip designation
CLASSIFICATION	S (Suitable), PS (Provisionally Suitable), or U (Unsuitable)

Evaluation of saprolite shall be by pits.
Long-term Acceptance Rate (LTAR): gal/day/ft²

Show profile locations and other site features (dimensions, reference or benchmark, and North).

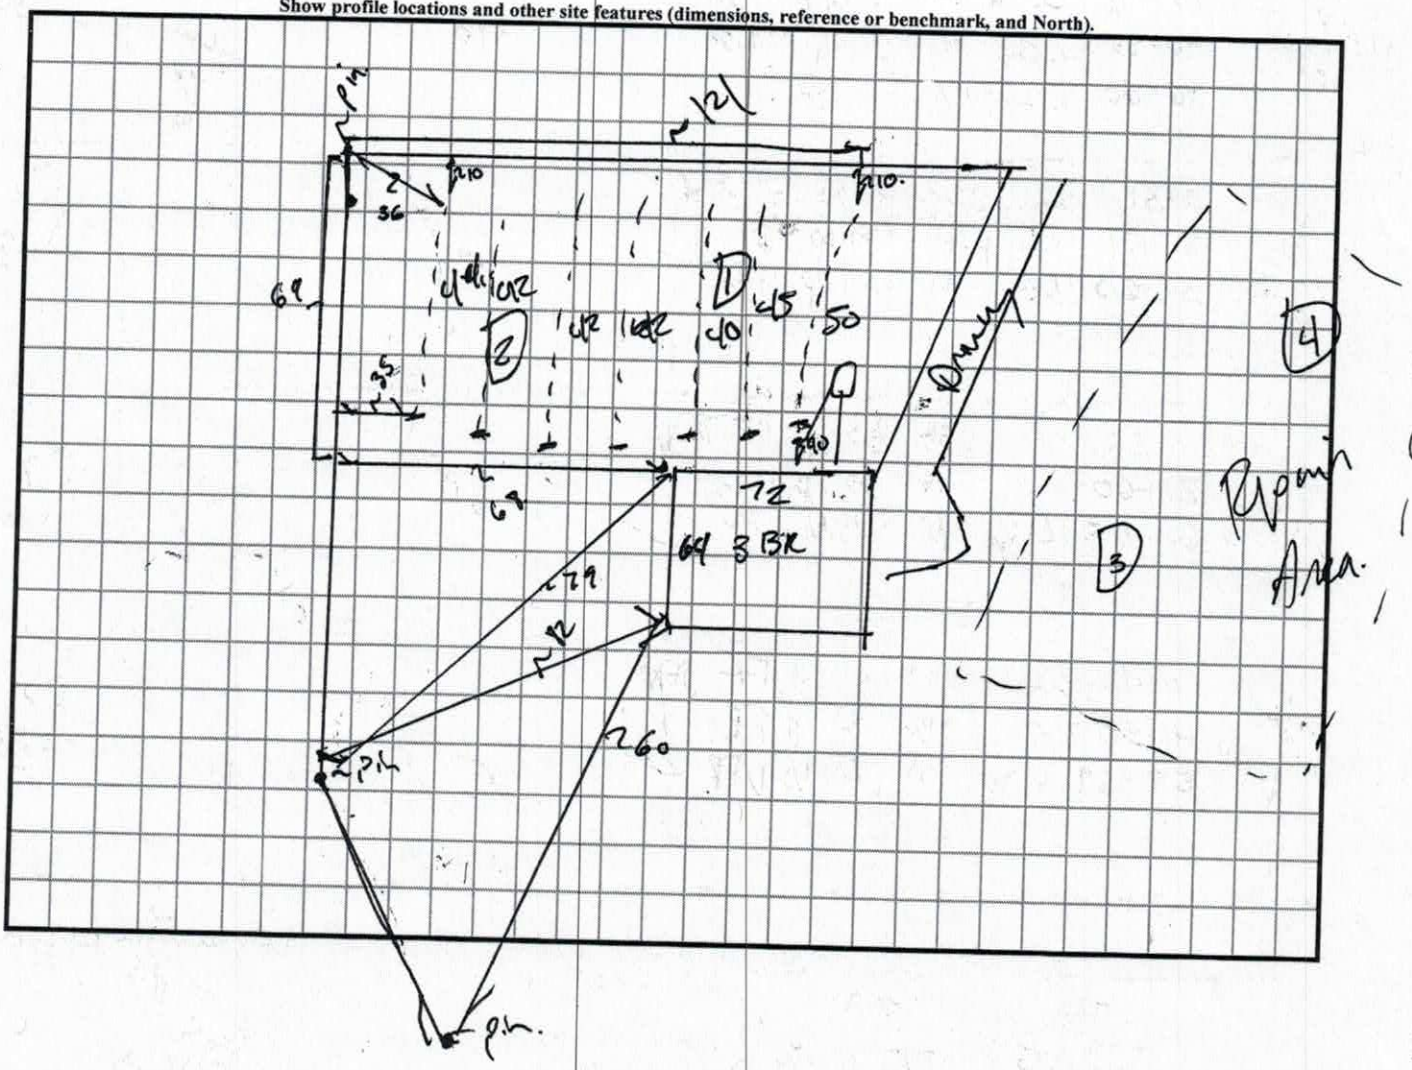

#240660
pd: $500.00

IREDELL COUNTY DEPARTMENT of ENVIRONMENTAL HEALTH

APPLICATION FORM

Application For: ( ) New Well Permit ( ) Well Repair Permit ( ) Well Abandonment
(X) Septic Improvement Permit (✓) Authorization to Construct ( ) Existing System Inspection ( ) Septic System Repair

THE ABOVE PERMIT DOCUMENTS WILL BECOME INVALID IF INFORMATION PROVIDED ON THIS APPLICATION IS FALSIFIED OR CHANGED, OR IF THE SITE IS ALTERED. THE IMPROVEMENT PERMIT IS VALID FOR EITHER 60 MONTHS OR WITHOUT EXPIRATION DEPENDING UPON DOCUMENTATION SUBMITTED. APPLICATION WITH SITE PLAN 60 MONTHS, APPLICATION WITH COMPLETE, SCALED PLAT WITHOUT EXPIRATION. SEE 15A NCAC 18A .1937(f) FOR DETAILS.

Page 2: *Site Plan Worksheet* form MUST accompany this application

The following optional attachments may also be submitted: ( ) Survey Plat, scaled no more than 1 inch = 60 feet
Place an (X) beside whichever is submitted if applicable ( ) Custom Site Plan, scaled no more than 1 inch = 60 feet

Applicant Information: (PRINT CLEARLY)

Applicant Name: JIMMY GENTRY Address: 156 KINGSWOOD RD Zip: 28625
Applicant Email: JIMMYGENTRY1953@HOTMAIL.COM Phone: 7049021535 Alt. Phone: _____
Owner Name: _____ Address: _____ Zip: _____
Owner Email: _____ Phone: _____ Alt. Phone: _____

Property Information:

Street Address: 117 BROKEN ARROW DR
Subdivision Name: FAIRWAYS @ RIVER OAKS LLC Section/Phase: _____ Lot Number: 1
Driving Directions: 40 W SHARON SCHOOL RD LEFT THEN LEFT ON ROCK MILL ROAD RT ON BROKEN ARROW

Site Development Information: *(check or complete ALL that apply*

(X) New Single Family Residence
( ) New Multi-Family Residence
( ) Accessory Building
( ) Bedroom(s) Addition
( ) Repair to failing septic system ___ Tank ___ Drain lines Describe Problem: _____

Maximum Number of Bedrooms: 3
Maximum Number of Occupants: 6
( ) Swimming Pool
( ) Other Addition/Structure: _____

CHECK FOUNDATION TYPE
(✓) Crawl Space Foundation
( ) Concrete Slab Foundation
( ) Basement with Plumbing
( ) Basement without Plumbing

Non-Residential Site Development: Type of Business: _____
Square Footage of Building: _____ Max. Number of Employees: _____ Max. Number of Seats/Beds/Other: _____

Water Supply: ( ) Replacement Well – Reason: _____
( ) Multi-connection Well Number of Houses: _____ Number of Persons: _____
( ) New Well ( ) Existing Well ( ) Community Well ( ) City Water (✓) Other Public Water

Desired Septic System Type: *(you may rank in order of preference)* Year existing system installed: _____
( ) No Preference ( ) Alternative (X) Conventional ( ) Innovative ( ) Modified Conventional ( ) Other: _____

Please answer the following to the best of your ability:
( ) Yes (X) No Does the site contain any jurisdictional wetlands?
( ) Yes (X) No Is any non-domestic sewage (i.e. industrial) to be generated?
( ) Yes (X) No Is the site subject to approval by any other public agency?

I have read this application and certify that the information provided herein is true, complete, and correct. Authorized county and state officials are granted right of entry to conduct necessary inspections to determine compliance with applicable laws and rules. I understand that I am solely responsible for the proper identification and labeling of all property lines and corners and making the site accessible so that a complete site evaluation can be performed.

Signature: _____ 11-27-2018
Property owner or owner's legal representative signature (SIGNATURE REQUIRED) DATE

2/28/19


IREDELL COUNTY DEPARTMENT of ENVIRONMENTAL HEALTH

SITE PLAN WORKSHEET

SEE THE "SAMPLE SITE PLAN" BELOW. *INCOMPLETE SITE PLANS WILL BE RETURNED TO YOU FOR COMPLETION AND MAY RESULT IN A DELAY IN THE ISSUANCE OF YOUR SEPTIC SYSTEM OR WELL PERMIT!!!*

Place an (X) beside each item as you complete the site plan:

( ) Property Line measurements are clearly identified
( ) All proposed structures are indicated
( ) Front and side setbacks from property line
( ) Preferred driveway location
( ) Preferred well location
( ) Preferred septic system location
( ) North arrow, or other sufficient indicator of direction

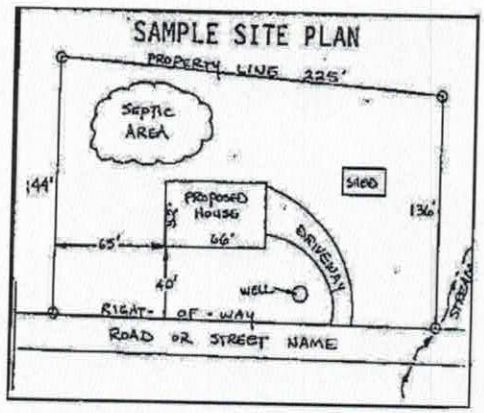


Circle N/A on the following if appropriate:

Location of septic systems and wells within 100' of your property	N/A
Location of easements and rights of ways on your property	N/A
Location of any designated wetlands on the property	N/A

USE THIS SPACE TO DRAW YOUR SITE PLAN

Show: proposed house or business footprint, wells, water lines, patios, pools and decks, and any other item that will occupy space on the site

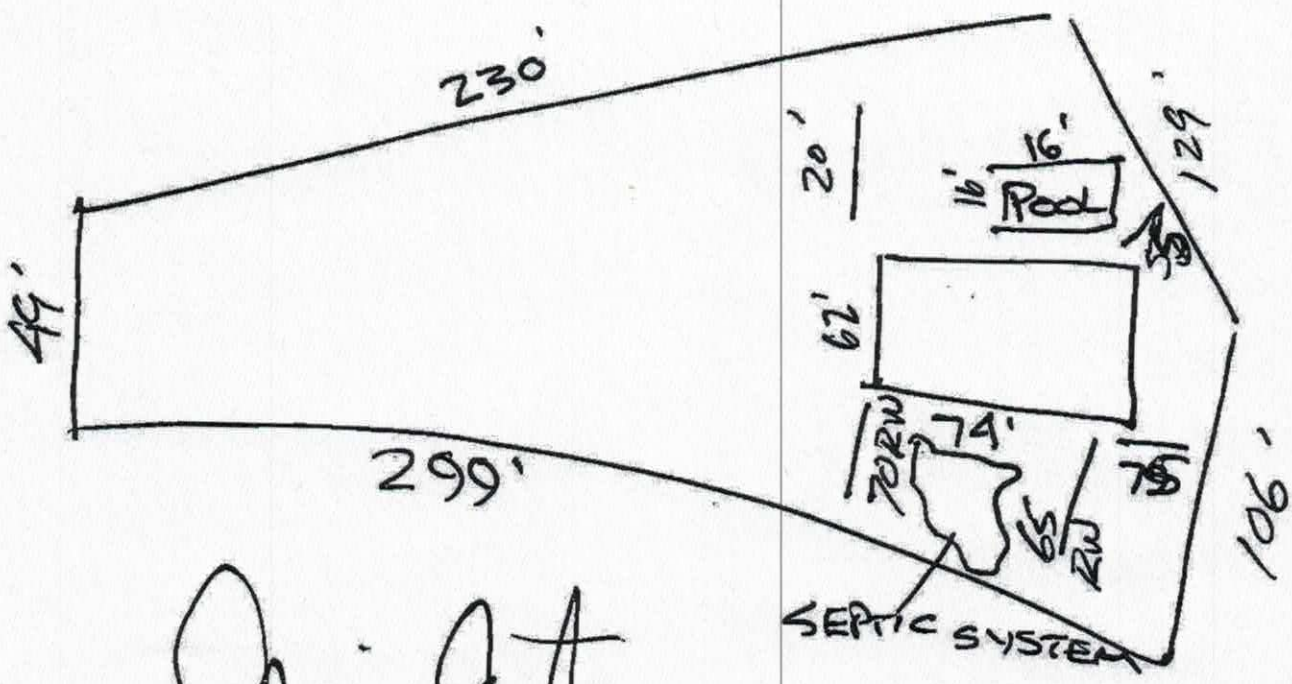

Signature: _____
Property owner or owner's legal representative signature (SIGNATURE REQUIRED)

11-28-2018
DATE

2/28/19

IREDELL COUNTY DEPARTMENT OF ENVIRONMENTAL HEALTH

DOCUMENTATION TO AUTHORIZE AN OWNER'S LEGAL REPRESENTATIVE

(Check and sign only ONE of the options below)

1. *** APPLICANT AND OWNER ARE THE SAME. *** (*Sign here*) _____

Applications for permits require the "signature of the owner or owner's legal representative" (15A NCAC 18A .1937). If the owner does not sign the application himself or herself, they can submit any one of the following documents to designate their legal representative: *Power of Attorney; Real Estate Contract; Estate executor; Bankruptcy trustee; Court ordered guardianship*
In the absence of the above documentation, the property owner may provide the local health department with documentation that designates a legal representative. A property owner may:
Complete this form to document his or her legal representative, or provide his or her own form that contains the information in this form. If there are multiple property owners, then all property owners must sign the form that designates a legal representative.
By signing a form that designates a legal representative for purposes of 15A NCAC 18A .1937, the property owner authorizes that representative to act on their behalf in matters pertaining to the application and permitting process, including signing or receiving any application, document or permit. The owner retains full responsibility to meet all permit conditions specified by the local health department.

2. I, FAIRWAYS AT RIVER OAKS LLC, am the legal owner(s) of the property located at LOT 1 BUFFALO SHOALS NAT'L GOLF CLUB ES, identified as PIN (Parcel Identification Number) 3793-13-7898.000 ~~-23-0873.000~~, located in Iredell County, North Carolina.

I do hereby authorize (**print legal representative/company name**) JIMMY GENTRY CONSTRUCTION & Remodeling Co. _____, to act as an agent on my behalf in applying for/signing/obtaining any of the documents described below.

- Application for Improvement Permit (IP) / Authorization to Construct (AC)
- Improvement Permit (IP) / Authorization to Construct (AC)
- Application for soil-site evaluation (new/repair)
- Application/permit for private drinking water well/well abandonment
- Application for Compliance Inspection


I agree to abide by all decisions and/or conditions between the legal representative acting on my behalf and the Iredell County Department of Public Health, Environmental Health Division.

MGR
Signature of Owner(s)

28 Nov 18
Date

Mooresville - Environmental Health
adrienne.shea@co.iredell.nc.us
Fax: 704-662-3239
610 E. Center Avenue, Mooresville, NC 28115

Statesville - Environmental Health
ronda.hart@co.iredell.nc.us
Fax: 704-871-3483
349 N. Center Street, Statesville, NC 28677

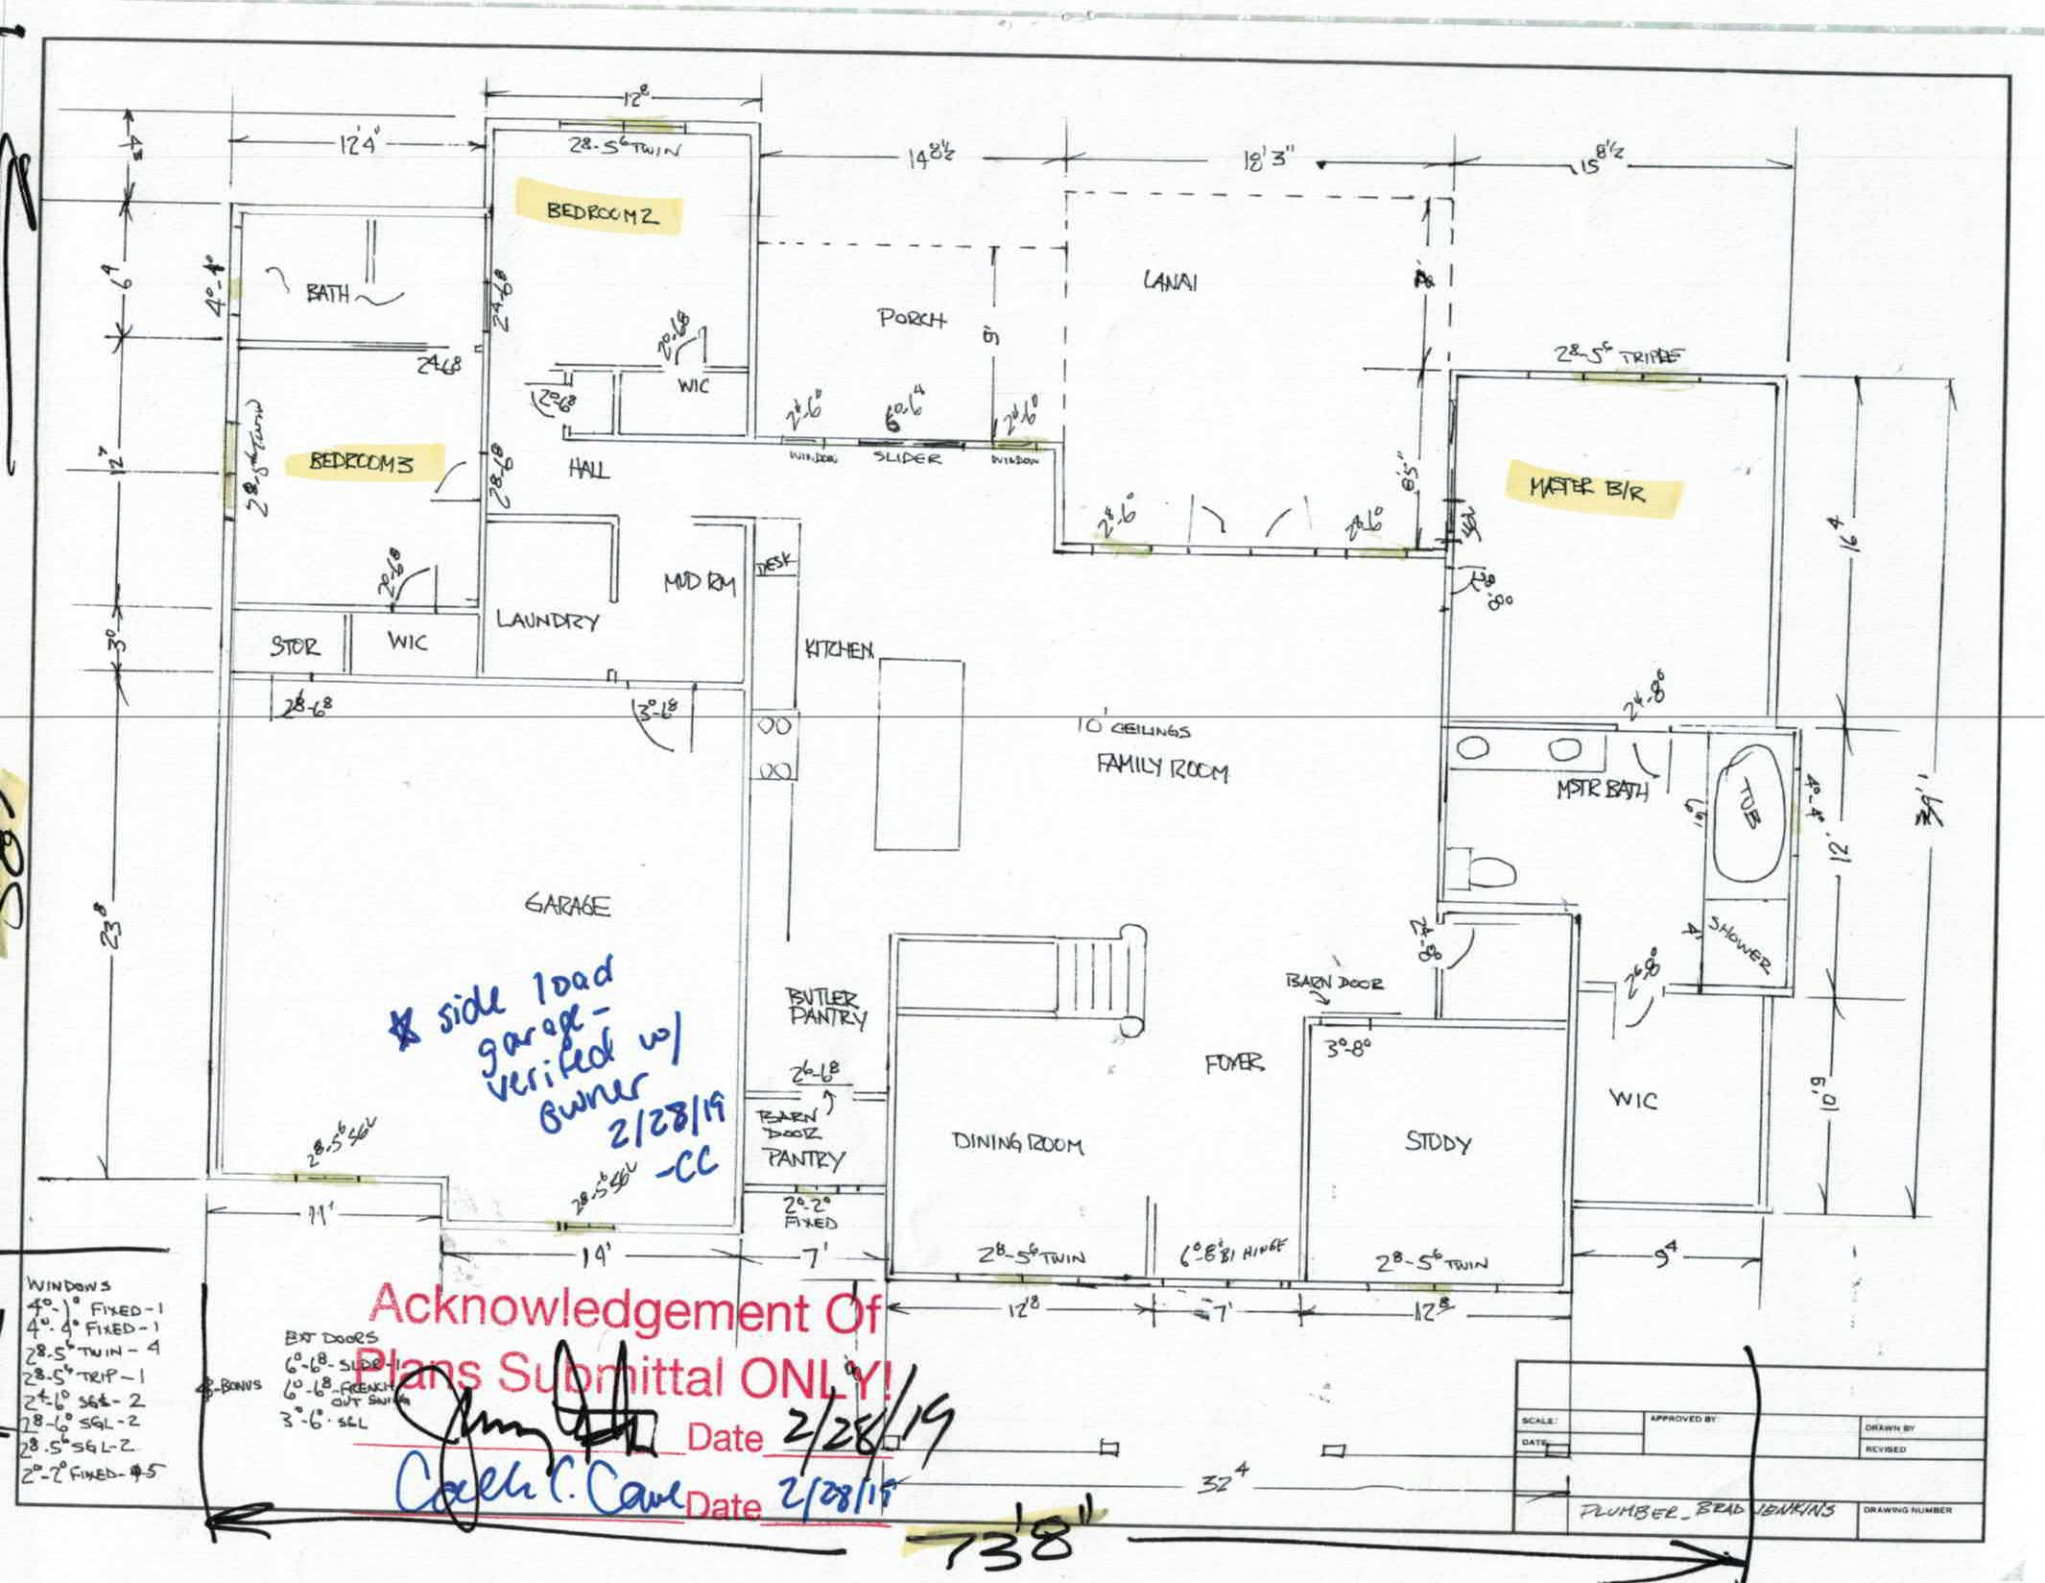
BEDROOM 2
BATH
BEDROOM 3
HALL
WIC
PORCH
LANAI
MASTER B/R
MSTR BATH
TUB
SHOWER
WIC
LAUNDRY
MUD RM
STOR
WIC
KITCHEN
DESK
10' CEILINGS
FAMILY ROOM
GARAGE
BUTLER PANTRY
BARN DOOR
PANTRY
FOYER
DINING ROOM
STUDY
WIC
* side load garage - verified w/ owner 2/28/19 -CC
WINDOWS
4'-0" FIXED - 1
4'-4" FIXED - 1
28-5⁶ TWIN - 4
28-5⁶ TRIP - 1
2'-6" SGL - 2
28-6" SGL - 2
28-5⁶ SGL - 2
2'-2" FIXED - 5
EXT DOORS
6'-8" SLIDER - 1
6'-8" FRENCH OUT SWING
3'-6" SGL
8 BOXES
Acknowledgement Of
Plans Submittal ONLY!
Date 2/28/19
Date 2/28/19
PLUMBER_BRAD HENRINS
DRAWING NUMBER
73'8"

IREDELL COUNTY

PO Box 788
349 North Center St.
Statesville, NC 28677

APPLICATION NUMBER
240660
Issue Date: 11/30/2018

ZONING PERMIT

Open Space

Parcel Number	Street Address	Jurisdiction
3793137898.000	117 BROKEN ARROW DRIVE, STATESVILLE, NC	IREDELL COUNTY

Owner Information	Applicant Information
Owner: FAIRWAYS AT RIVER OAKS LLC	Applicant: GENTRY JAMES M+KAREN S
Address: 104 COMANCHE CT	Address: 156 KINGSWOOD DR
STATESVILLE, NC 28677	STATESVILLE, NC 28625
Phone:	Phone:

Use Requested	Zone Code
	RA

Lot Acreage	F Setback	B Setback	L Setback	R Setback	Watershed	Flood Zone
.870	35.00	35.00	15.00	15.00	PACL	X


Remarks:

The applicant certifies that there are no deed restrictions, contractual agreements or governmental regulations of any kind that interfere with or prohibit the use of the property or the use for which this permit is requested. The applicant further acknowledges that enforcement of deed restrictions, plat conditions and other contractual agreements will not be undertaken by Iredell County and is the sole responsibility of the affected parties.

Applicant: _____ Date: _____

Permit Number	160903	TOTAL FEES:	$ 77.25

ZONING DISCLAIMER

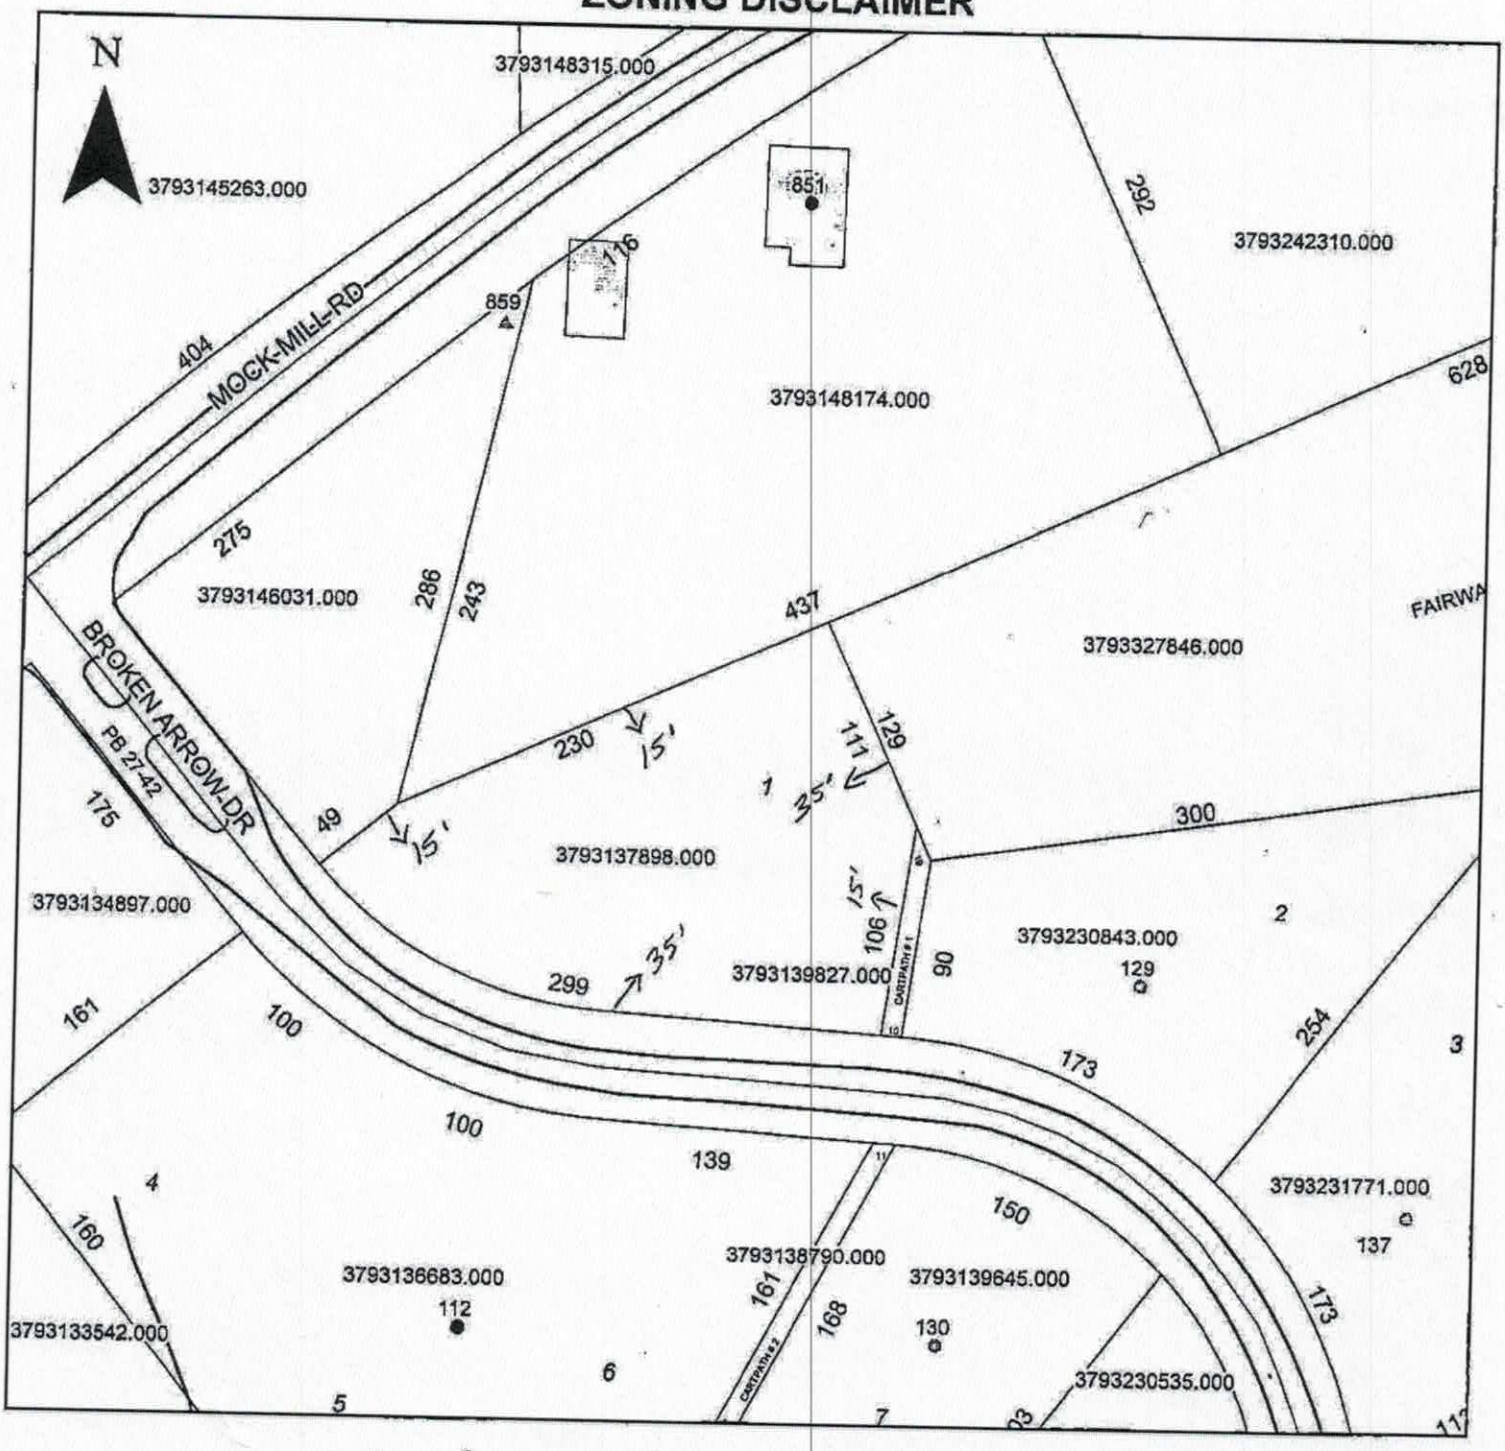

Property Address 117 Broken Arrow Dr.

The applicant certifies that there are no deed restrictions, contractual agreements or governmental regulations of any kind that interfere with or prohibit the use of the property or the use for which this permit is requested. Applicant further acknowledges that the enforcement of deed restrictions, plat conditions, and other contractual agreements will not be undertaken by Iredell County and is the sole responsibility of the affected parties.

Applicant

11-30-2018
Date