IREDELL COUNTY HEALTH DEPARTMENT

Statesville Office (704) 878-5305 Mooresville Office (704) 660-3625 PERMIT # 181599 BF

IMPROVEMENT PERMIT / AUTHORIZATION TO CONSTRUCT / OPERATION PERMIT / EXISTING SYSTEM

PIN # 3793152726

APPLICANT: Agnes Jakubowski APPLICANT ADDRESS: 223 Dagenhart Farm Rd.

SITE ADDRESS: 140 Sharon Crest Dr. PHONE: 704-871-1328 ALT. PHONE: 704-880-2555

SITE DIRECTIONS: I-40 W to Sharon School Exit TR Sharon School TR Whitney TL Sharon Crest Dr.


SUBDIVISION: N/A SECTION: N/A LOT # N/A LOT AREA: 0.53 acres DESIGN FLOW: 360 gpd L.T.A.R.: Existing

Septic Tank	1000 (gal)	STB	1000	Date	8-12-13	☐ New System	☑ Repair	☐ Expansion	System Type: I II III IV V VI	☑ Residence	No. Bedrooms 3
Pump Tank	(gal)	PT		Date		System Description:				☐ Business	No. Persons
Pump Make	Model		Serial #			Repair System Description:	TANK			☐ Other	No. Employees
# Nitrification Fields	Ex # Lines	Ex	Linear Ft:	Ex		Maintenance Agreement Required:	☐ YES	☑ NO		☐ Slab	☑ Crawl Space
Trench Width	Ex Max. Trench Bottom Depth	Ex	Gravel Depth	Ex			☑ GRAVITY	☐ PRESSURE		☐ Basement w/plumbing	☐ Basement w/o plumbing

Water Supply: ☐ Private ☑ Public ☐ Community

Comments / Conditions: Set new 1000 gallon septic tank at location shown below, and connect to existing drainfield. Maintain a minimum of 5' between deck & new septic tank.

INITIAL SITE SKETCH

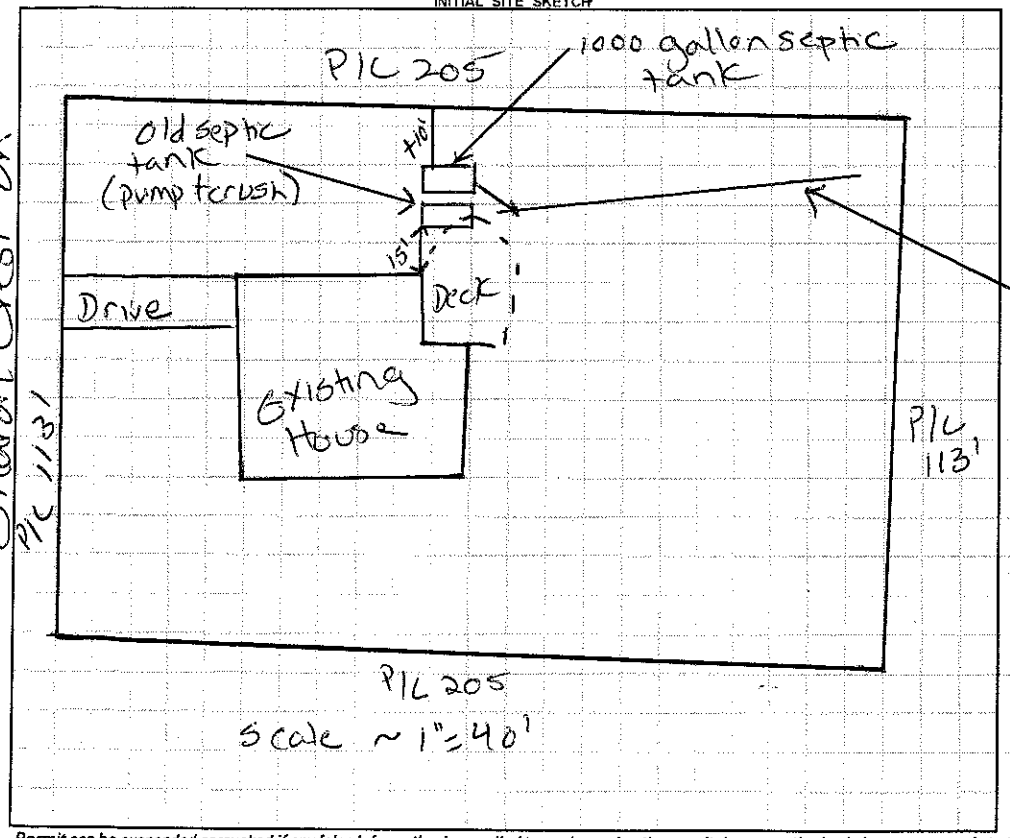

AS BUILT SKETCH

- 2" PVC Tank marker installed
- Red Polylok filters installed
- Installed as drawn

Permit can be suspended or revoked if any false information is supplied toward securing the permit / any unauthorized changes are made to the site / any unauthorized changes are made in the installation of the system. **CONTACT A LOCATOR SERVICE PRIOR TO ANY EXCAVATION**

☐ **IMPROVEMENT PERMIT** *with plat valid without expiration.* ☑ **IMPROVEMENT PERMIT** *with site plan valid for 60 mos.* ☑ **AUTHORIZATION TO CONSTRUCT** *valid for period equal to IMPROVEMENT PERMIT--not to exceed 60 mo.*

Owner / Applicant Signature: Dawn Combs Date: Installed by: K & M Grading

IMPROVEMENT PERMIT by: Justin Henderson Date: 10-24-13 OPERATION PERMIT by: Justin Henderson Date: 10-29-13

AUTHORIZATION TO CONSTRUCT by: Justin Henderson Date: 10-24-13 Existing System Inspected by: Date:

Health Dept. Copy - WHITE Applicant (Final Approval) - YELLOW Applicant (Conditional Approval) - PINK