IREDELL COUNTY HEALTH DEPARTMENT

Statesville Phone TR 3-7271 Mooresville Phone NO 3-1271

PERMIT TO INSTALL SEPTIC TANK

Permit Date 10/24 1962

Permit NO. _____

Owner EVERET HOLTE Address _____

Installed By CATAWBA SEPTIC TANK CO Address _____


Location of Property HP IS #40 RIGHT ON SHARON ROAD RIGHT AT 1st DIRT ROAD GO TO LAST HOUSE ON RIGHT - BRICK -

Tank		Capacity		Length of Lines		Fixtures	
Block	( )	800	( )	150'	( )	No. of Baths	(1½)
Precast	(X)	900	( )	175'	( )	Dishwasher	( )
		1000	(X)	200'	( )	Garbage Grdr.	( )
		1100	( )	225'	(X)	Auto-Washer	( )
		1200	( )	250'	( )	Other _____	
		Other _____		Other _____			

NOTIFY HEALTH DEPARTMENT AT LEAST EIGHT HOURS BEFORE TANK IS TO BE INSPECTED.

Final Inspection 10/24 1962 Approved (✓) Disapproved ( )

Remarks WELL

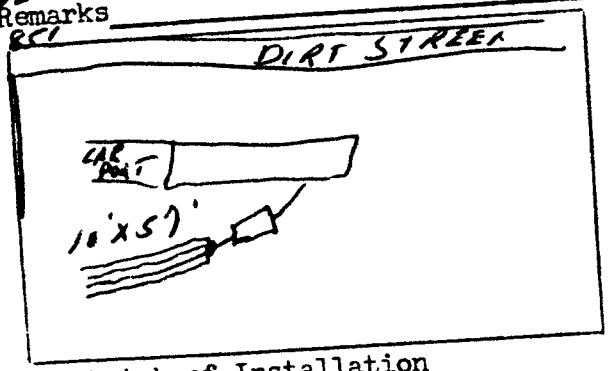

Sketch of Installation

Rupert B. Thomas
Sanitarian