# IREDELL COUNTY HEALTH DEPARTMENT

STATESVILLE 704-878-5305 (a) (d) MOORESVILLE 704-664-5281 (b)

## IMPROVEMENT PERMIT / AUTHORIZATION TO CONSTRUCT / OPERATION PERMIT / EXISTING SYSTEM INSPECTION

PERMIT # 160692 PIN # 3793-20-[redacted] 0261 DATE 4-28-10

OWNER or APPLICANT Cardice Williams PHONE: Business Home: 704 928-7036

OWNER or APPLICANT ADDRESS 139 Oley Ln.

LOCATION / DIRECTIONS I40 W to Sharon School Rd, (L) off ramp, (L) on Oley, on (L)

SUBDIVISION n/a BLOCK / SECTION LOT # LOT AREA DESIGN FLOW 360 total L.T.A.R. .4

Septic Tank ~~1000~~ ex Gallons: STB ex Date ex

Pump Tank Gallons: P T Date

Pump Make Model Serial #

Nitrification Field No Fields 1 No Lines 1 Linear Feet 75 added

Trench Width 36" Max. Trench Bottom Depth 36" Gravel Depth n/a ☒ GRAVITY ☐ PRESSURE

☐ New System ☐ Repair ☒ Expansion System Type I II (III) IV V VI

System Description: 25% Reduction - Gravity Exp

Repair System Description: 25% Reduction Pump

Maintenance Agreement Required ☐ YES ☒ NO

☒ Residence No. Bedrooms 3 ☐ Business No. Persons ☐ Other No. Employees ☐ Slab ☒ Crawl Space ☐ Basement w/plumbing ☐ Basement w/o plumbing


Water Supply: ☐ Private ☒ Public ☐ Community

Comments / Conditions

1"=60'

Comments / Conditions

INITIAL SITE SKETCH

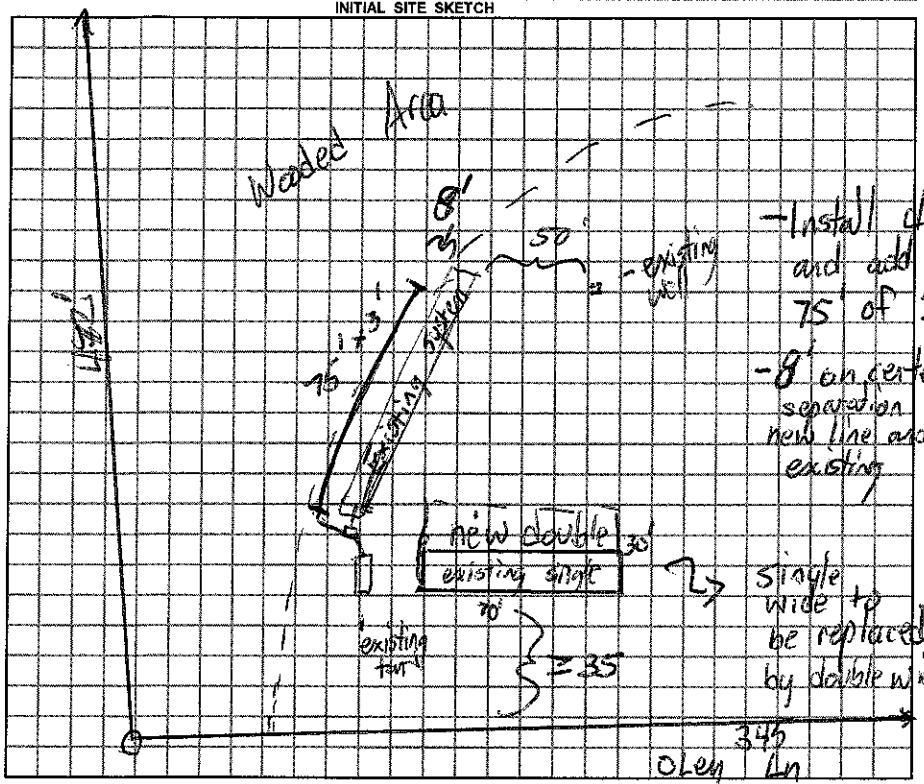


AS BUILT SKETCH

*Permit can be suspended or revoked if any false information is supplied toward securing the permit / any unauthorized changes are made to the site / any unauthorized changes are made in the installation of the system.*

☐ *IMPROVEMENT PERMIT w / plat valid without expiration.* ☒ *IMPROVEMENT PERMIT w / site plan valid for 60 mos.* ☒ *AUTHORIZATION TO CONSTRUCT valid for period equal to IMPROVEMENT PERMIT-not to exceed 60 mo.*

Owner / Applicant Signature: Cardice J. Williams Date 5-3-10

Improvement Permit by: Date 5-3-10

Authorization to Construct by: Date 5-3-10

***YOU SHOULD CONTACT A LOCATOR SERVICE PRIOR TO ANY EXCAVATION.***

Installed by: Handyman (Bryce)

Operation Permit by: Date: 1-28-11

Existing System Inspected by: Date:

WHITE COPY Environmental Health YELLOW COPY (Final) Owner / Applicant PINK COPY (initial) Owner / Applicant