IREDELL COUNTY HEALTH DEPARTMENT

STATESVILLE 704-878-5305 MOORESVILLE 704-664-5281

IMPROVEMENT PERMIT / AUTHORIZATION TO CONSTRUCT / OPERATION PERMIT / EXISTING SYSTEM INSPECTION

PERMIT# 139679 PIN# 3793-22-6865 DATE 15 February 07

OWNER OR APPLICANT L&N Builders LLC PHONE: Business 704-201-9178 Home

ADDRESS 7862 Sarah Dr. Denver, N.C. 28037

LOCATION Sharon School Rd. Turn onto Mock Mill Rd. TR Broken Arrow - Lot on Rt.

SUBDIVISION Buffalo Shoals Est BLOCK / SECTION LOT 19 LOT AREA 0.58 ac. SITE CLASS. P3 DESIGN FLOW 360 gpd. L.T.A.R. 0.25 gpd/ft²/d

Septic Tank: 1000 g Gallons: STB Date

Pump Tank: Gallons: PT Date

Pump Make: Model Serial No.

Nitrification Field: No Fields 1 Square Feet = 1440 Linear Feet 240'

No Lines 6 @ 40' Trench Width 24" Max Trench Bottom Depth 36"

☑ New System ☐ Repair ☐ Expansion System Type: I II III IV V VI

System Description: 50% Reduction

Repair System Description: 50% Reduction

Maintenance Agreement Required: ☐ Yes ☑ No

☑ House/Mod. Home No. Bedrooms 2

☐ Mobile Home No. Persons

☐ Business No. Employees

☐ Other


Water Supply: ☐ Individual ☑ Public ☐ Community

Gravel Depth N/A ☑ Gravity ☐ Pressure ☐ Slab ☑ Crawl Space ☐ Basement w/plumbing ☐ Basement wo/plumbing


Comments:/Conditions: Keep out of unsuitable soil & topo Area / Install 54 panels in 6 equal-length lines. / use Flow-divider Tee & (2) effluent-splitters. (Follow contour /

Comments:/Conditions: Filter installed.

INITIAL SITE SKETCH

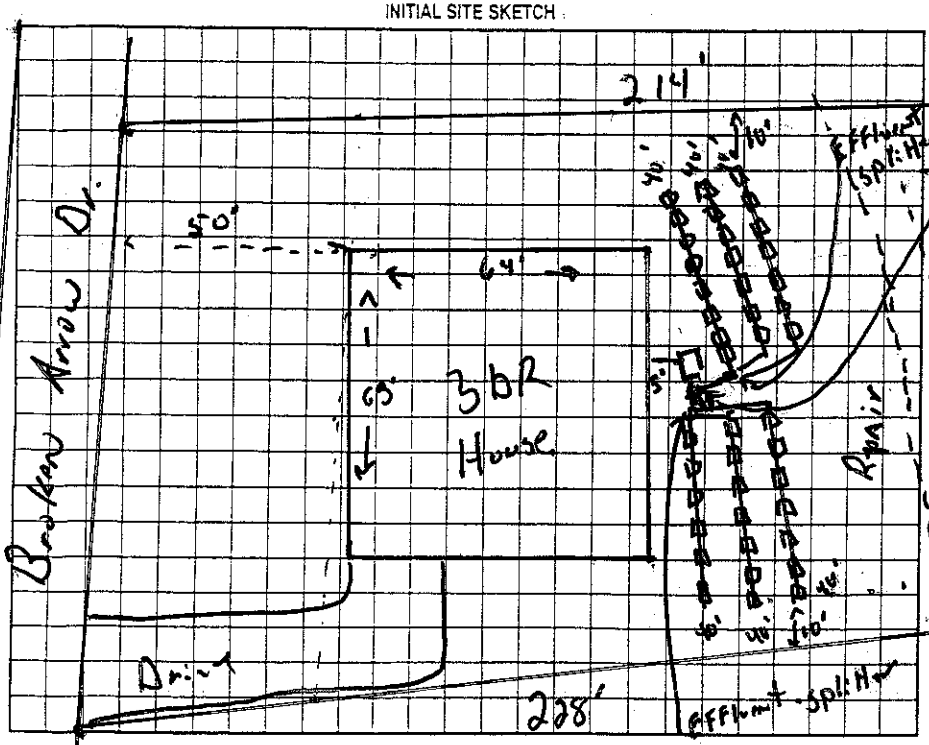

AS BUILT SKETCH

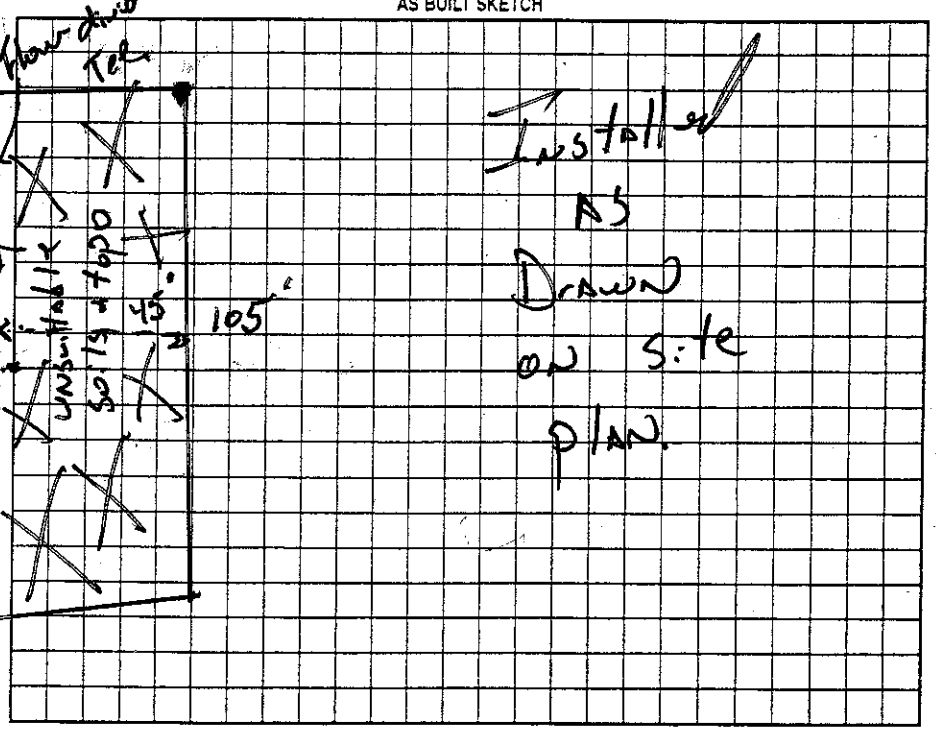

Permit can be suspended or revoked if any false information is supplied toward securing the permit/any unauthorized changes are made to the site/any unauthorized changes are made in the installation of the system. Improvement Permit with plat valid without expiration ☐ Improvement Permit with site plan valid for sixty months ☐ Authorization to Construct is valid for a period equal to that of Improvement Permit – not to exceed sixty months.

Staked: D. K. Cook date 2/16/07 Installed by: Tim Call & Brad Johnson

Improvement Permit by: [signature] R.S. date 15 Feb. 07 Operation Permit by: [signature] R.S. date 17 July 07

Authorization to Construct by: [signature] R.S. date 15 Feb. 07 Existing System Inspection by: date

HEALTH DEPT. COPY: WHITE OWNER COPY (FINAL): YELLOW OWNER COPY (INITIAL): PINK