IREDELL COUNTY HEALTH DEPARTMENT

CI

STATESVILLE 704-878-5305 MOORESVILLE 704-664-5281

IMPROVEMENT PERMIT / AUTHORIZATION TO CONSTRUCT / OPERATION PERMIT / EXISTING SYSTEM INSPECTION

PERMIT# 105924 PIN# 3792-25-9048.B

OWNER OR CONTRACTOR Thomas + Janna Cook DATE 5/8/02

ADDRESS 819 Mack Mill Rd Statesville N.C. 28677 PHONE: Business — Home (704) 872-3851

LOCATION I-40 W, (L) Sharon School Rd, (L) Mack Mill Rd, 6th on Right

SUBDIVISION — BLOCK / SECTION — LOT — LOT AREA 1 Ac SITE CLASS. PS DESIGN FLOW 360 L.T.A.R. .30

Septic Tank: 1000 Gallons; STB 102 Date 7-23-02
Pump Tank: Gallons; PT Date
Pump Make: Model Serial No.
Nitrification Field: No Fields 1 Square Feet 1200 Linear Feet 400'
No Lines 4 @ 100' Trench Width 36" Max Trench Bottom Depth 36" Gravel Depth 12"

X New System ☐ Repair System Type: I II III. IV. V. VI
System Description: Gravity Conventional
Repair System Description: Rep. 50% Reduction
Maintenance Agreement Required: ☐ Yes ☐ No
☐ Slab X Crawl Space ☐ Basement w/plumbing ☐ Basement wo/plumbing

☐ House/Mod. Home
X Mobile Home
☐ Business
☐ Other


No. Bedrooms 3
No. Bathrooms 2
No. Employees

Water Supply:
X Individual
☐ Public
☐ Community

Comments:/Conditions: (1) Install lines on contour (2) keep well 100 ft from system (3) maintain proper setbacks

Comments:/Conditions: – Tuff-Tite Filter Installed
– S.T. Marker Installed

INITIAL SITE SKETCH (Not to Scale)

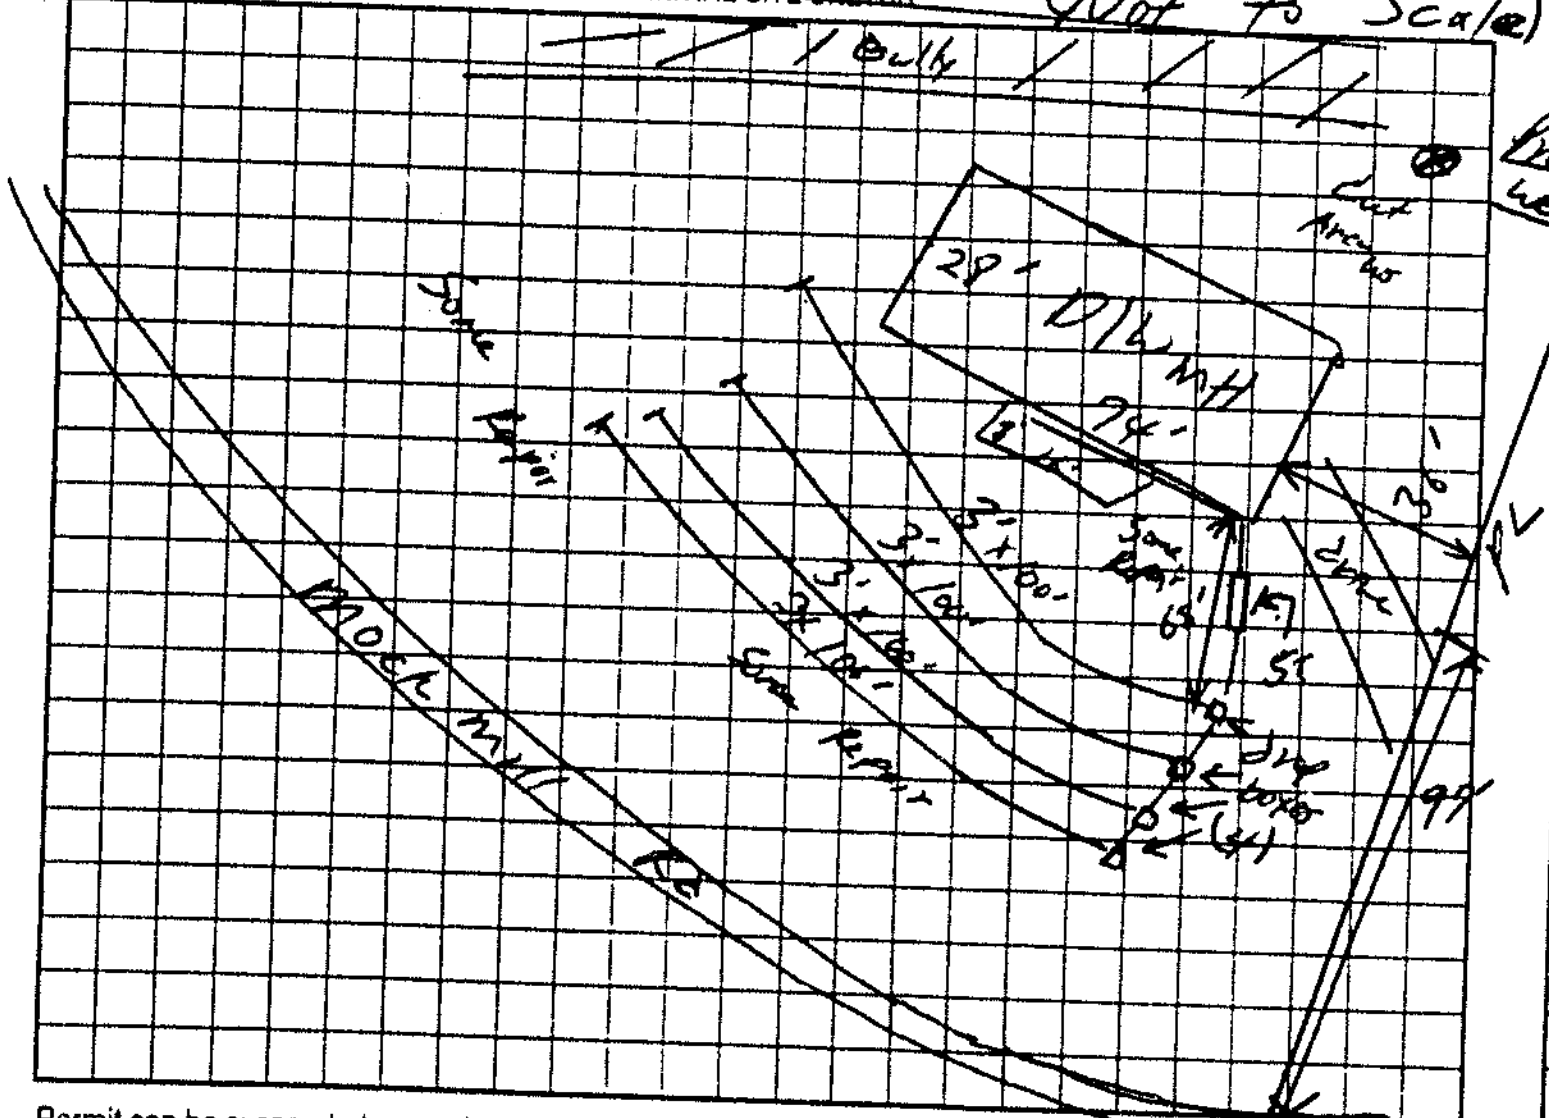

AS BUILT SKETCH

Installed as Shown per Initial Site Sketch

Permit can be suspended or revoked if any false information is supplied toward securing the permit/any unauthorized changes are made to the site any unauthorized changes are made in the installation of the system. Improvement Permit with plat valid without expiration. Improvement Permit with site plan valid for sixty months. Authorization to Construct is valid for a period equal to that of Improvement Permit – not to exceed sixty months

Signed: Jana B Cook date 5-10-02

Improvement Permit by: William O. Johnson date 5/9/02

Authorization to Construct by: William O. Johnson date 5/9/02

Installed by: Dale Wingler

Operation Permit by: William O. Johnson date 10/1/02

Existing System Inspection by: date

HEALTH DEPT COPY WHITE OWNER COPY (FINAL) YELLOW OWNER COPY (INITIAL) PINK