IREDELL COUNTY HEALTH DEPARTMENT

STATESVILLE 704-878-5305 CJ MOORESVILLE 704-664-5281

IMPROVEMENT PERMIT / AUTHORIZATION TO CONSTRUCT / OPERATION PERMIT / EXISTING SYSTEM INSPECTION

PERMIT# 121782 PIN# ~~3793-58-3451~~ 3793-38-9401 DATE 6/28/04

OWNER OR CONTRACTOR John Andersen PHONE: Business — Home (704) 872-9744

ADDRESS 276 Goble Rd Statesville N.C. 28625

LOCATION I-40 west, (L) Shaver School Rd, (L) Mock Mill Rd (L) on Goble Rd, property on right before 266 Goble

SUBDIVISION — BLOCK / SECTION — LOT — LOT AREA 6.65 Acres SITE CLASS. PS DESIGN FLOW 360 L.T.A.R. .35

Septic Tank: 4000 Gallons; STB 825 Date 5-10-04
Pump Tank: — Gallons; PT — Date —
Pump Make: — Model — Serial No. —
Nitrification Field: No Fields 1 Square Feet 1029 Linear Feet 345
No Lines 4 @ 86 Trench Width 36" Max Trench Bottom Depth 29" Gravel Depth 12"


☒ New System ☐ Repair System Type: I, (II) III, IV, V, VI
System Description: Gravity Conventional
Repair System Description: Gravity, Conventional
Maintenance Agreement Required: ☐ Yes ☒ No

☐ House/Mod. Home ☒ Mobile Home ☐ Business ☐ Other — No. Bedrooms 3 No. Bathrooms — No. Employees —
☐ Slab ☒ Crawl Space ☐ Basement w/plumbing ☐ Basement wo/plumbing

Water Supply: ☒ Individual ☐ Public ☐ Community: well

Comments:/Conditions: ① Keep well minimum 100ft From all Septic systems ② Install lines on Contour

INITIAL SITE SKETCH (Not to Scale)

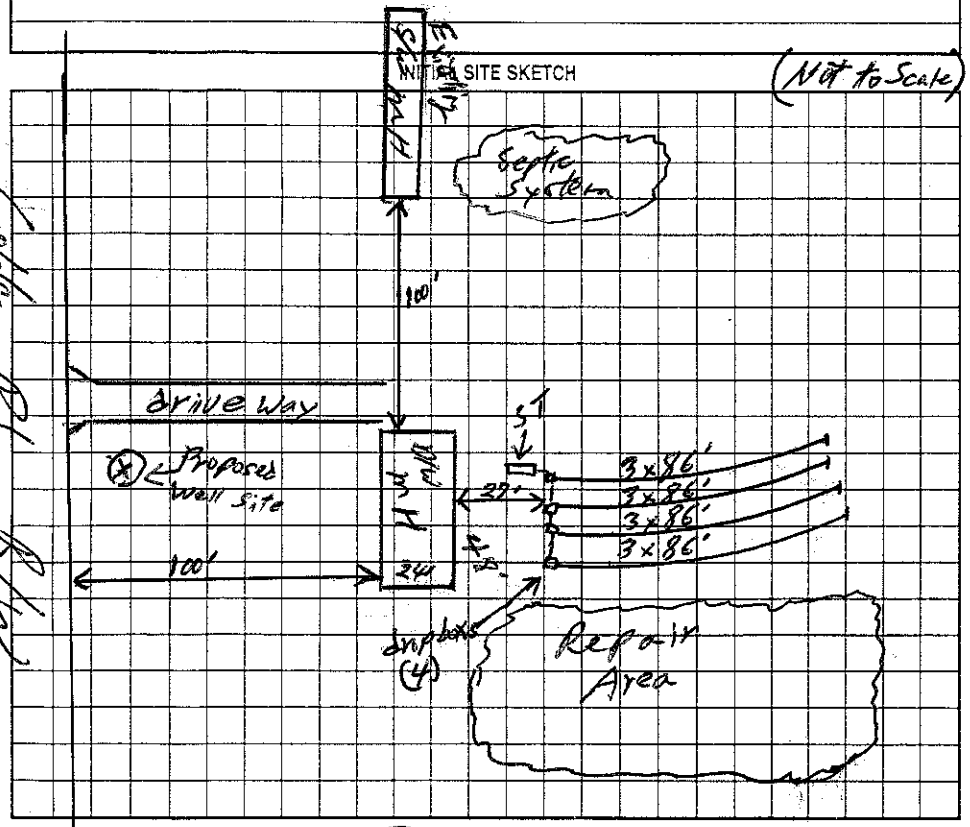

Comments:/Conditions:
- Blue Polylok Filter Installed
- House + Footings not installed @ time of Septic installation

AS BUILT SKETCH

Septic System Installed As Shown On Initial Site Sketch

Permit can be suspended or revoked if any false information is supplied toward securing the permit/any unauthorized changes are made to the site/any unauthorized changes are made in the installation of the system. Improvement Permit with plat valid without expiration. Improvement Permit with site plan valid for sixty months. Authorization to Construct is valid for a period equal to that of Improvement Permit – not to exceed sixty months.

Signed: Glenn Andersen date 6/25/04 Installed by: Rowan Septic

Improvement Permit by: William O. Johnson date 6/29/04 Operation Permit by: William O. Johnson date 7/15/04

Authorization to Construct by: William O. Johnson date 6/29/04 Existing System Inspection by: — date —

HEALTH DEPT. COPY: WHITE OWNER COPY (FINAL): YELLOW OWNER COPY (INITIAL): PINK