IREDELL COUNTY HEALTH DEPARTMENT Statesville Office

IMPROVEMENT PERMIT / AUTHORIZATION TO CONSTRUCT / OPERATION PERMIT / EXISTING SYSTEM

PERMIT # 219509

PIN # 3793902826

APPLICANT: Rollans Soil | APPLICANT ADDRESS: P.O. Box 832 Mooresville NC 28115

SITE ADDRESS: 120 Cheyenne Ln Statesville NC 28677 | PHONE: 704-746-5046 | ALT. PHONE: 704-883-8724

SITE DIRECTIONS: 70 W T/R Sharon Schoolhouse Rd T/R Mock Mill Rd T/R Broken Arrow T/R Dakota T/L Cheyenne

SUBDIVISION: Buffalo Shoals National Golf Club | SECTION: Bldg | LOT # 71 | LOT AREA: 0.58 ac | DESIGN FLOW: 360 | L.T.A.R.: 0.3

Septic Tank	1000 (gal)	STB		Date					
Pump Tank	(gal)	PT		Date					
Pump Make		Model		Serial #					
# Nitrification Fields	1	# Lines	3	Linear Ft:	300				
Trench Width	36"	Max. Trench Bottom Depth	30"	Gravel Depth	N/A				

☒ New System ☐ Repair ☐ Expansion System Type: I II ☒ IV V VI

System Description: 25% Reduction

Repair System Description: PPBS (50% Reduction)

Maintenance Agreement Required: ☐ YES ☒ NO

☒ GRAVITY ☐ PRESSURE

☒ Residence ☐ Business ☐ Other ☐ Slab ☐ Basement w/plumbing

No. Bedrooms: 3 | No. Persons: 6 | No. Employees: | ☒ Crawl Space

Water Supply: ☐ Private ☒ Public ☐ Community


☐ Basement w/o plumbing

Comments / Conditions: Install per plan by Rollans Soil & Environmental

INITIAL SITE SKETCH

See plan by Rollans Soil & Environmental

AS BUILT SKETCH

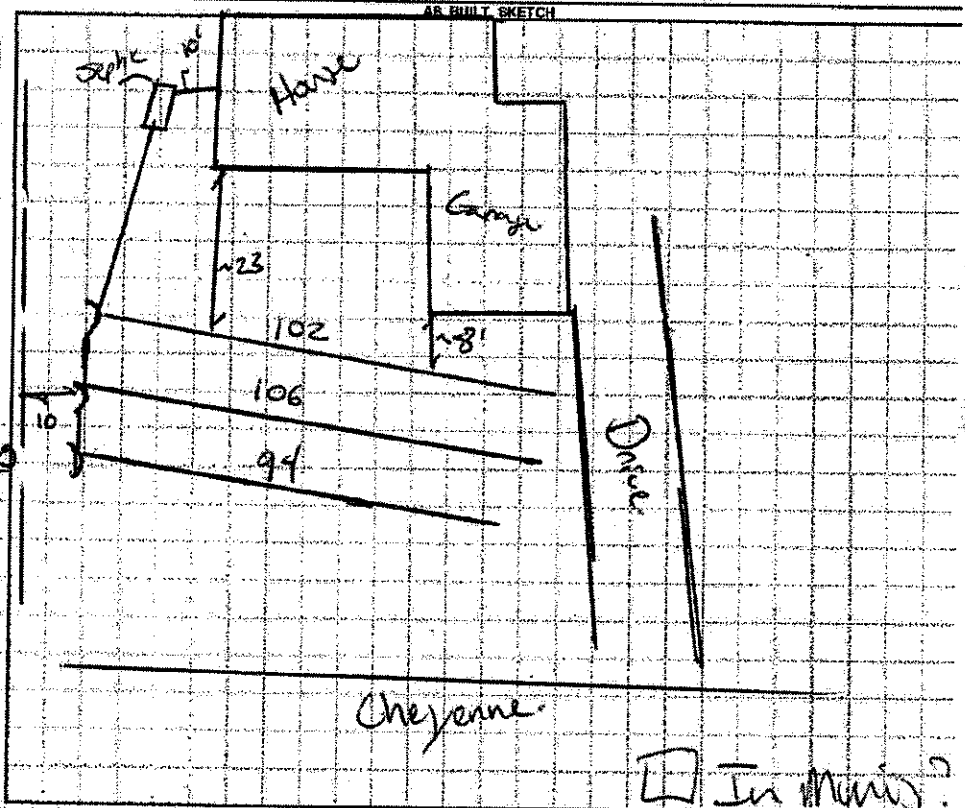

☐ In Mound?

Permit can be suspended or revoked if any false information is supplied toward securing the permit / any unauthorized changes are made to the site / any unauthorized changes are made in the installation of the system. CONTACT A LOCATOR SERVICE PRIOR TO ANY EXCAVATION

☐ IMPROVEMENT PERMIT with plat valid without expiration. ☒ IMPROVEMENT PERMIT with site plan valid for 60 mos. ☒ AUTHORIZATION TO CONSTRUCT valid for period equal to IMPROVEMENT PERMIT--not to exceed 60 mo.

Owner / Applicant Signature: [signature] Date: 7/5/16

IMPROVEMENT PERMIT by: [signature] Date: 06/23/16


AUTHORIZATION TO CONSTRUCT by: [signature] Date: 06/23/16

Installed by: Gary Leatherman

OPERATION PERMIT by: B. Bottins Date: 3/21/2017

Existing System Inspected by: Date:

Health Dept. Copy - WHITE Applicant (Final Approval) - YELLOW Applicant (Conditional Approval) - PINK

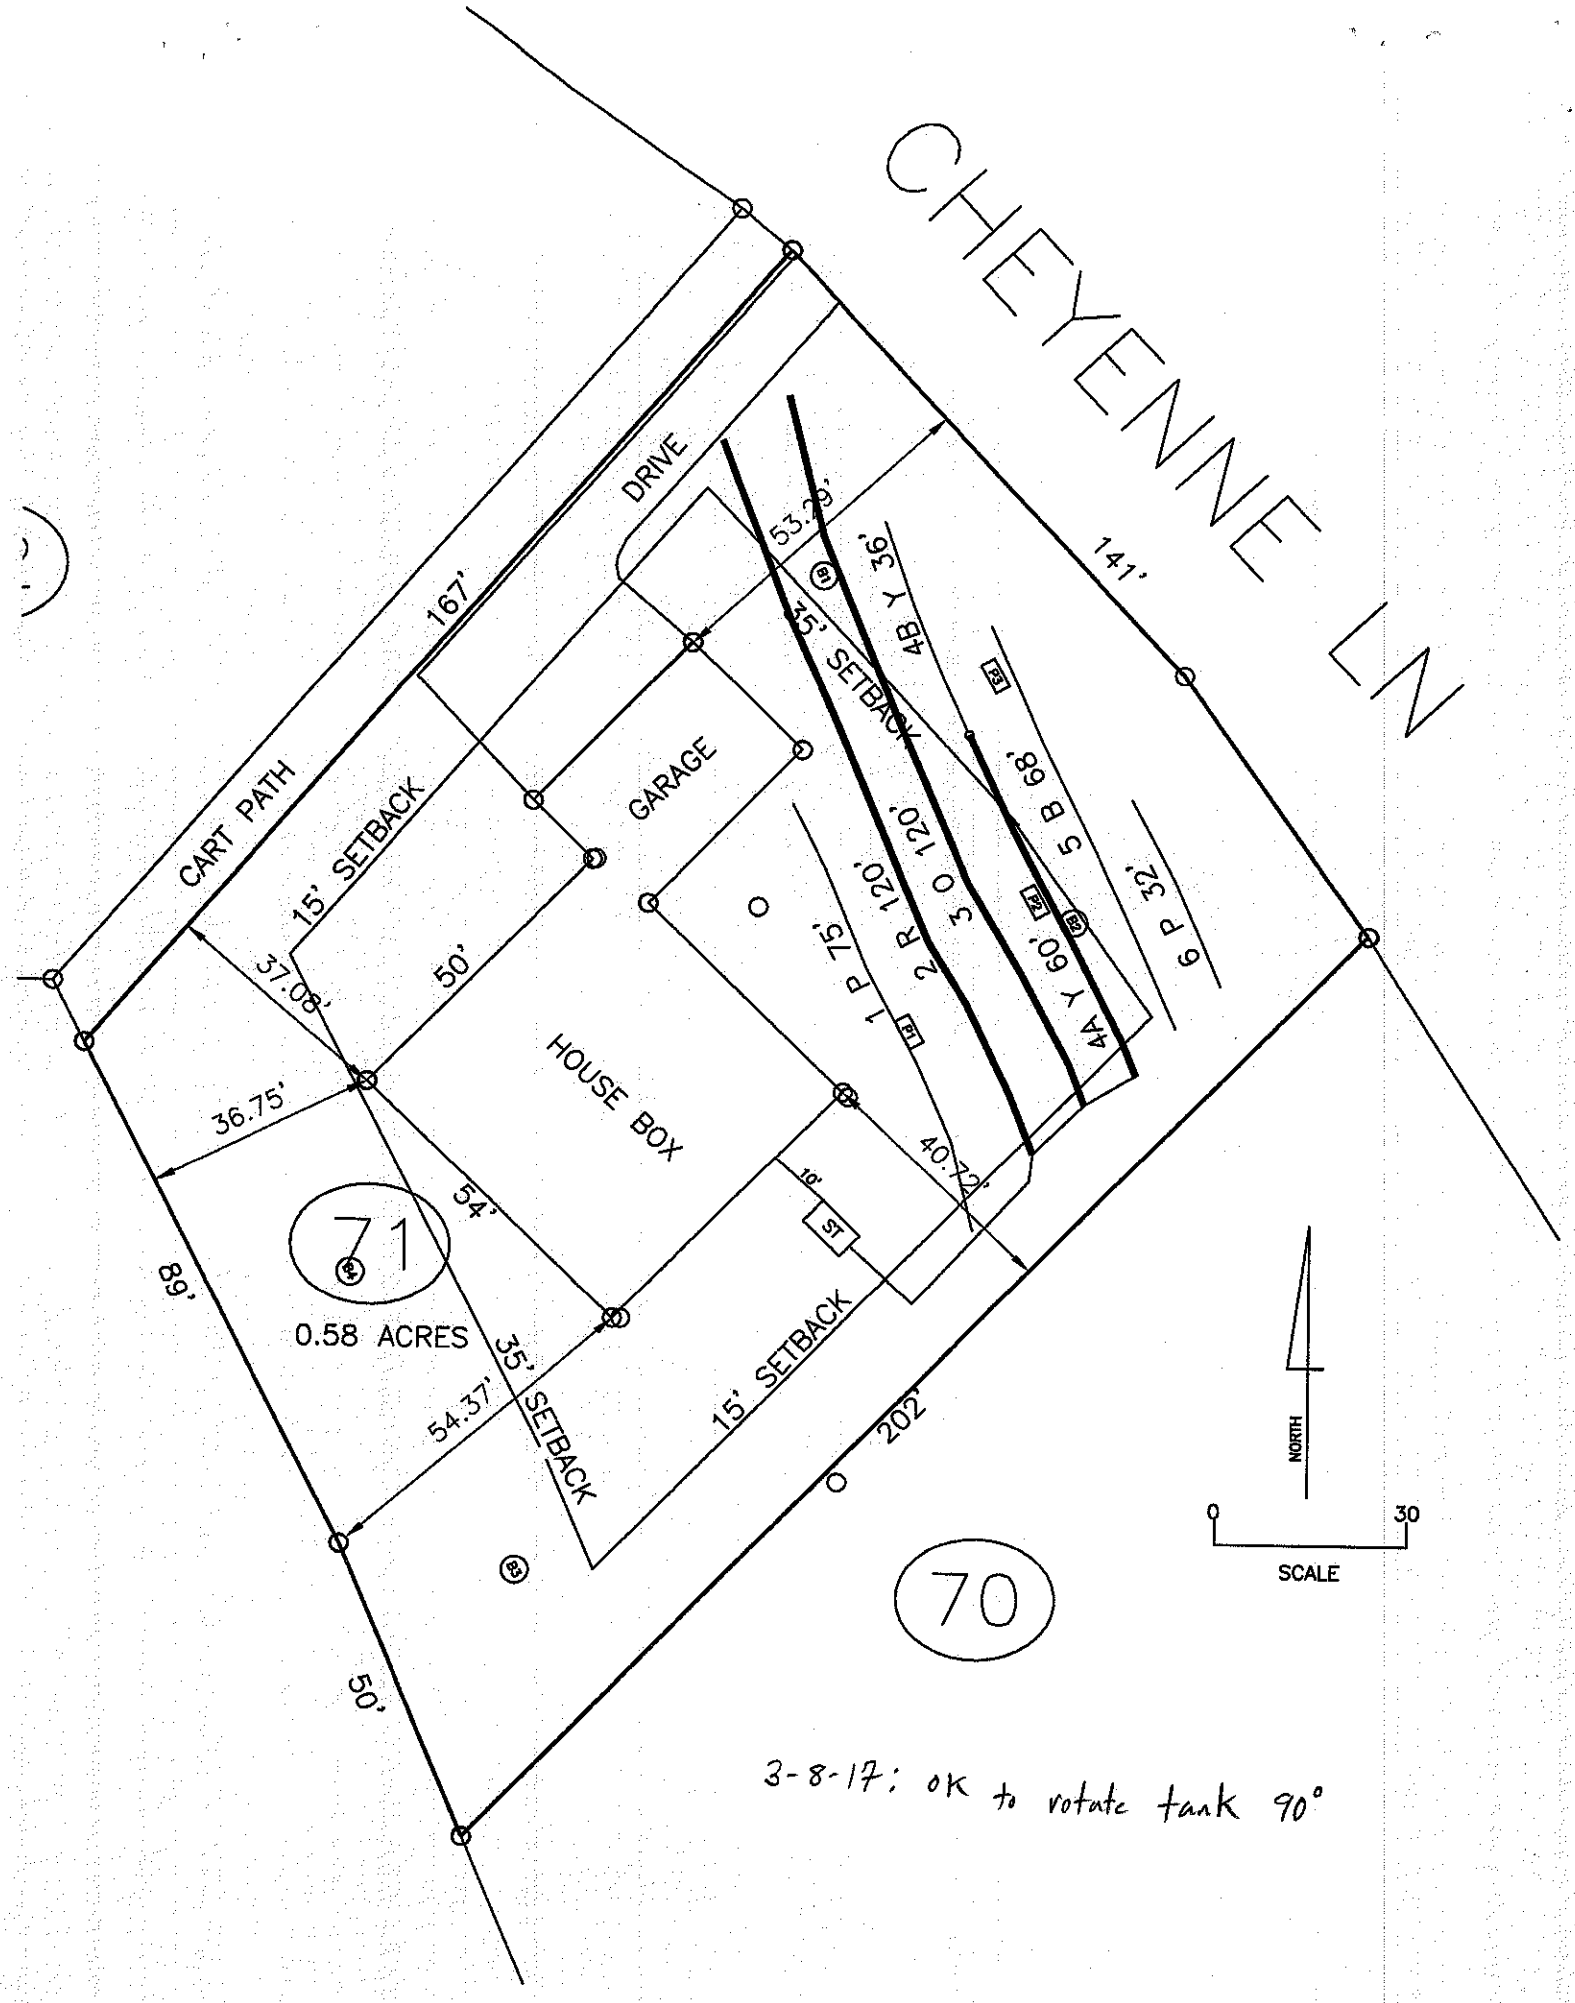

3-8-17; ok to rotate tank 90°