IREDELL COUNTY HEALTH DEPARTMENT

Statesville Office (704) 878-5305 Mooresville Office (704) 660-3625 PERMIT # 266334

IMPROVEMENT PERMIT / AUTHORIZATION TO CONSTRUCT / OPERATION PERMIT / EXISTING SYSTEM

PIN # 3793419027

APPLICANT: Keith Miller APPLICANT ADDRESS: 117 Airport Rd.

SITE ADDRESS: 336 Broken Arrow Dr. - Statesville PHONE: 704-902-3764 ALT. PHONE: N/A

SITE DIRECTIONS: Old Mtn Rd TR Mack Mill Rd TL Broken Arrow Dr.

SUBDIVISION: Buffalo Shoals National Golf Club SECTION: F LOT # 57 LOT AREA: 0.16 acres DESIGN FLOW: 720gpd L.T.A.R.: 0.275

Septic Tank Min 1350 (gal) STB 160 Date 9-15-14
Pump Tank N/A (gal) PT N/A Date N/A
Pump Make N/A Model Pol/Ole Serial # PL-68
Nitrification Fields 1 # Lines 4 Linear Ft: 220
Trench Width 36" Max. Trench Bottom Depth 36" Gravel Depth N/A

☐ New System ☐ Repair ☑ Expansion System Type: I II III IV V VI
System Description: 25% Reduction
Repair System Description: ~~40~~ Low Pressure PPBPS
Maintenance Agreement Required: ☐ YES ☑ NO
☑ GRAVITY ☐ PRESSURE

☑ Residence No. Bedrooms 6
☐ Business No. Persons 12
☐ Other No. Employees
☐ Slab ☐ Crawl Space
☑ Basement w/plumbing ☐ Basement w/o plumbing

Water Supply: ☐ Private ☑ Public ☐ Community

Comments / Conditions: Install a 25% Reduction system on contour with serial distribution. Minimum size septic tank is 1350 gallon. May replace existing septic with appropriate size as installed another tank in series to meet minimum requirement. Fill must be removed from repair area prior to issuance of repair permit if ever needed.

INITIAL SITE SKETCH

See Attached Plan by Kenny Owens, LSS

AS BUILT SKETCH

- 2" PVC ST marker installed
- Quick 4 Chambers installed
- Installed as drawn

Permit can be suspended or revoked if any false information is supplied toward securing the permit / any unauthorized changes are made to the site / any unauthorized changes are made in the installation of the system. **CONTACT A LOCATOR SERVICE PRIOR TO ANY EXCAVATION**

☐ **IMPROVEMENT PERMIT** *with plat* valid without expiration. ☑ **IMPROVEMENT PERMIT** *with site plan* valid for 60 mos. ☑ **AUTHORIZATION TO CONSTRUCT** valid for period equal to IMPROVEMENT PERMIT--not to exceed 60 mo.

Owner / Applicant Signature: Date: 6-17-14 Installed by: K+M Grading


IMPROVEMENT PERMIT by: Justin Henderson Date: 6-17-14 OPERATION PERMIT by: Justin Henderson Date: 11-14-14

AUTHORIZATION TO CONSTRUCT by: Justin Henderson Date: 6-17-14 Existing System Inspected by: Date:

Health Dept. Copy - WHITE Applicant (Final Approval) - YELLOW Applicant (Conditional Approval) - PINK

Plan By
Kenny Owens
LSS

40

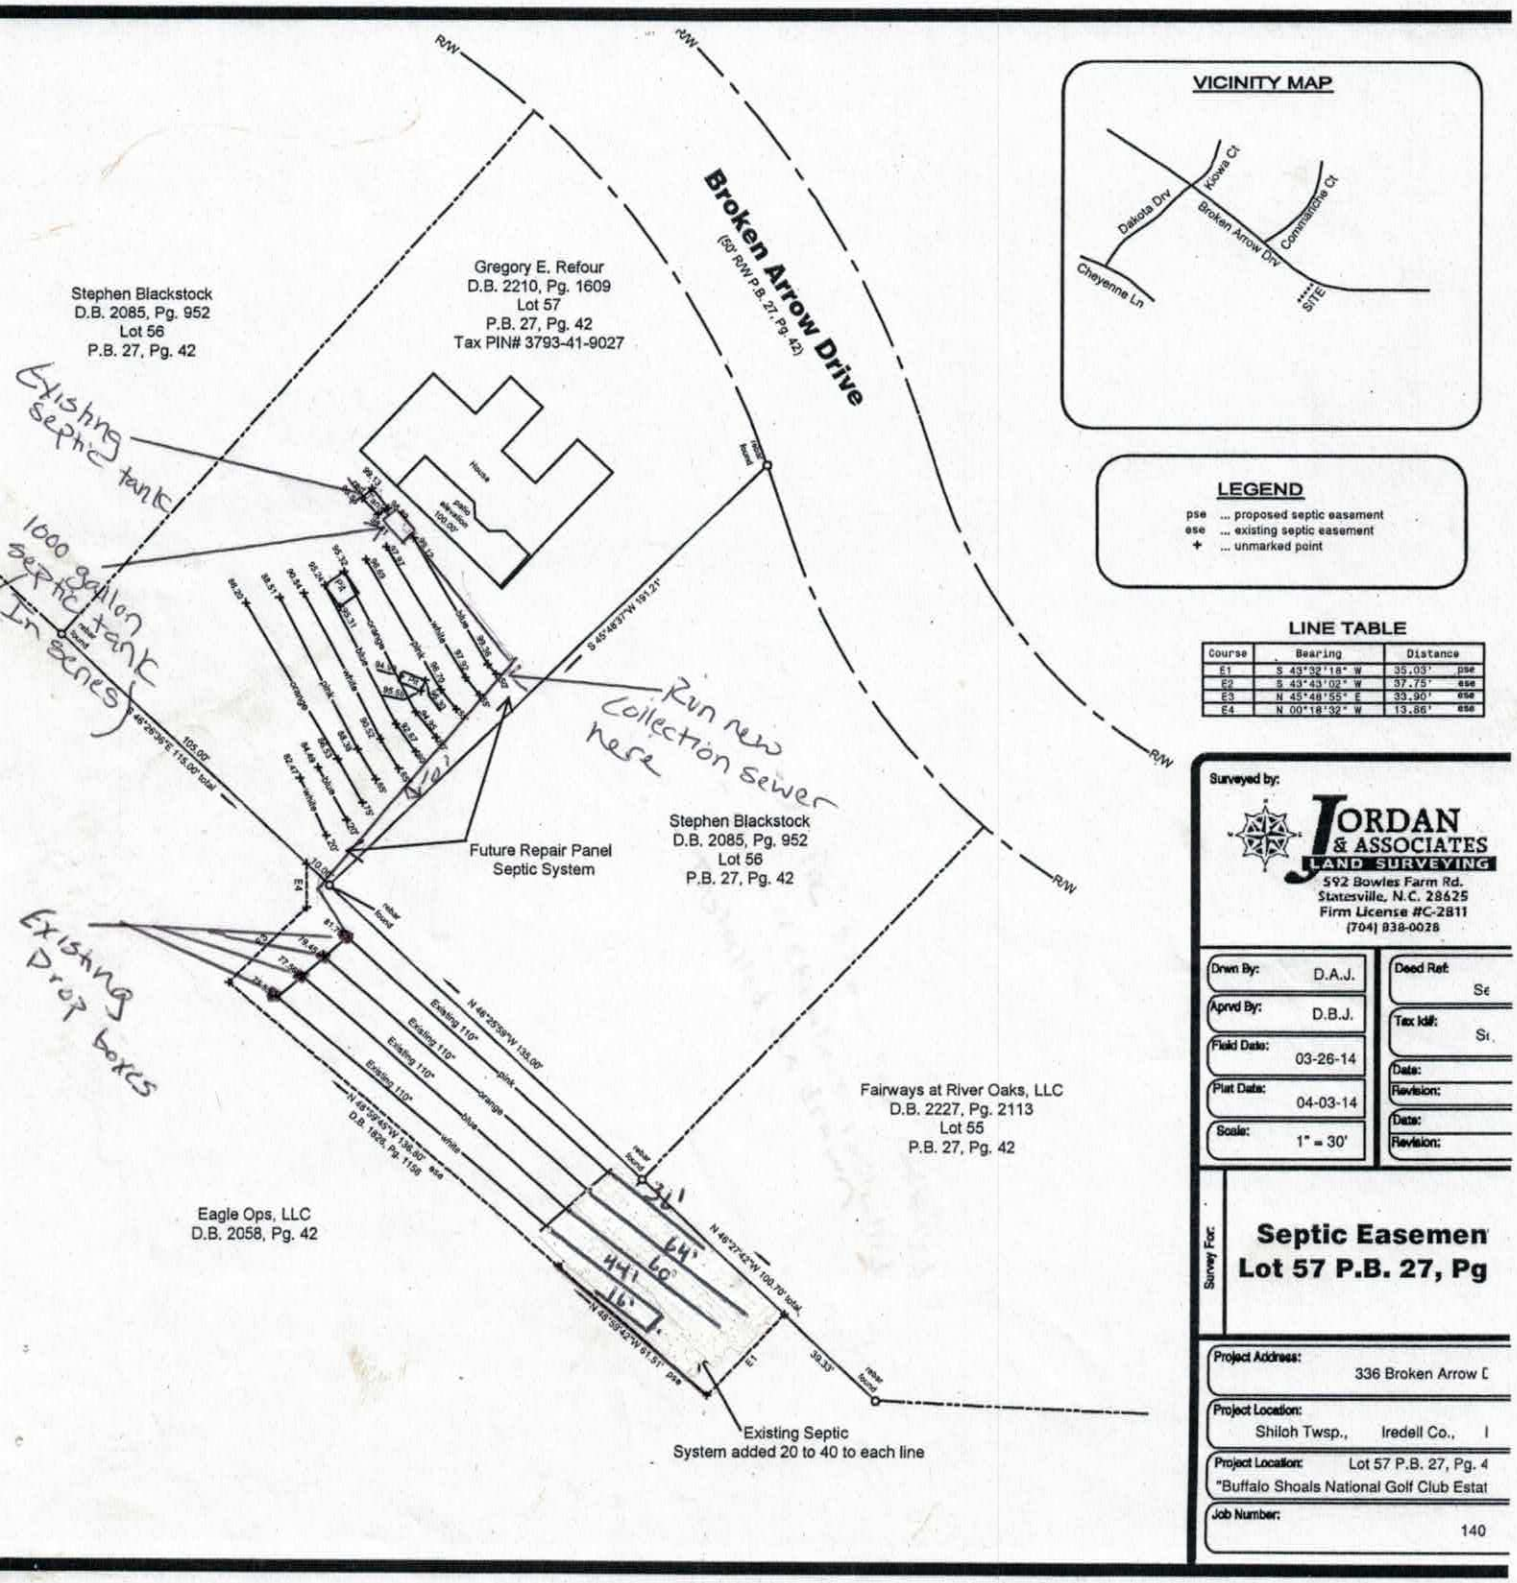

VICINITY MAP

LEGEND

pse ... proposed septic easement
ese ... existing septic easement
+ ... unmarked point

LINE TABLE

Course	Bearing	Distance	
E1	S 43°32'18" W	35.03'	pse
E2	S 43°43'02" W	37.75'	ese
E3	N 45°48'55" E	33.90'	ese
E4	N 00°18'32" W	13.86'	ese

Surveyed by:

JORDAN & ASSOCIATES
LAND SURVEYING
592 Bowles Farm Rd.
Statesville, N.C. 28625
Firm License #C-2811
(704) 838-0028

Drwn By: D.A.J.	Deed Ref: Se
Aprvd By: D.B.J.	Tax Id#: St
Field Date: 03-26-14	Date:
Plat Date: 04-03-14	Revision:
Scale: 1" = 30'	Date:
	Revision:

Survey For: **Septic Easemen**
Lot 57 P.B. 27, Pg

Project Address: 336 Broken Arrow D
Project Location: Shiloh Twsp., Iredell Co., I
Project Location: Lot 57 P.B. 27, Pg. 4
"Buffalo Shoals National Golf Club Estat
Job Number: 140

DENR/DEH

ON-SITE WASTEWATER SECTION

Sheet 1 of 1

PROPERTY ID #: 3793419027

COUNTY: Iredell

SOIL/SITE EVALUATION
for ON-SITE WASTEWATER SYSTEM

OWNER: Keith Miller

ADDRESS: 117 Airport Rd

APPLICATION DATE 11-19-13

PROPOSED FACILITY: 4BR → 6BR SF PROPOSED DESIGN FLOW (.1949): 720gpd

DATE EVALUATED: 12-5-13

LOCATION OF SITE: 336 Broken Arrow Dr

PROPERTY SIZE: 0.6acres

WATER SUPPLY: • Private • Public • Well • Spring • Other

PROPERTY RECORDED: Yes

EVALUATION METHOD: • Auger Boring • Pit • Cut

TYPE OF WASTEWATER: N/A • Sewage • Industrial Process • Mixed

PROFILE #	.1940 LANDSCAPE POSITION/ SLOPE %	HORIZON DEPTH (IN.)	SOIL MORPHOLOGY (.1941) .1941 STRUCTURE/ TEXTURE	SOIL MORPHOLOGY (.1941) .1941 CONSISTENCE/ MINERALOGY	OTHER PROFILE FACTORS .1942 SOIL WETNESS/ COLOR	.1943 SOIL DEPTH	.1956 SAPRO CLASS	.1944 RESTR HORIZ	PROFILE CLASS & LTAR
1	25% L	0-10"	Fill		>70"	10-70"	>70"	>70"	PS .275 >20"
		10-35	RC SPL	Fri SSSP					
		35-48	RCL WSBK						
		48-70	RCL Mottled	SAPRock					
2	28% L upper hole in fairway	0-6	Compacted Fill		>60"	51"	51" PS	>60"	PS 0.275
		6-32	RC ABK/SBK	Fi SS/SP mod SE					
		32-51	CL WSBK	Fi Mod SE					
		51-60	SLSAP W/C	inclusion					
3	29% L lower hole on fairway	6-34	C ABK	Fi mod SE	>60"	34"	34" PS	>60"	PS 0.275
		34-60	SAP SL WBK	Fi Mod SE					
4	24% L	0-36	Fill		>100"	100"	100"	100"	PS 0.275
		36-100	RC/CL WSBK	Fi SS/SP mod SE					
		100+	SAP						

DESCRIPTION	INITIAL SYSTEM	REPAIR SYSTEM
Available Space (.1945)	PS	PS
System Type(s)	III	IV
Site LTAR	0.275	0.275

OTHER FACTORS (.1946): N/A

SITE CLASSIFICATION (.1948): PS

EVALUATED BY: Matt Anderson

OTHER(S) PRESENT: Brady Freeman

COMMENTS: N/A

36 64 60 44 16

LEGEND

use the following standard abbreviations

LANDSCAPE POSITION	GROUP	SOIL TEXTURE	CONVENTIONAL .1955 LTAR*	LPP .1957 LTAR*	MINERALOGY/ CONSISTENCE	STRUCTURE
CC (Concave Slope) CV (Convex Slope) D (Drainage Way) DS (Debris Slump) FP (Flood Plain) FS (Foot Slope) H (Head Slope) L (Linear Slope) N (Nose Slope) R (Ridge) S (Shoulder Slope) T (Terrace)	I	S (Sand) LS (Loamy Sand)	1.2 - 0.8	0.6 - 0.4	NEXP (Non-expansive) SEXP (Slightly Expansive) EXP (Expansive)	G (Single Grain) M (Massive) CR (Crumb) GR (Granular) SBK (Subangular Blocky) ABK (Angular Blocky) PL (Platy) PR (Prismatic)
	II	SL (Sandy Loam) L (Loam)	0.8 - 0.6	0.4 - 0.3		
	III	Si (Silt) SiCL (Silty Clay Loam) CL (Clay Loam) SCL (Sandy Clay Loam) SiL (Silt Loam)	0.6 - 0.3	0.3 - 0.15		
	IV	SC (Sandy Clay) SiC (Silty Clay) C (Clay)	0.4 - 0.1	0.2 - 0.05		
		O (Organic)	None	None		

MOIST	WET
VFR (Very Friable)	NS (Non-sticky)
FR (Friable)	SS (Slightly Sticky)
FI (Firm)	S (Sticky)
VFI (Very Firm v. Very Sticky)	VS (Very Sticky)
EFI (Extremely Firm)	NP (Non-plastic)
	SP (Slightly Plastic)
	P (Plastic)
	VP (Very Plastic)

*Adjust LTAR due to depth, consistence, structure, soil wetness, landscape, position, wastewater flow and quality.


NOTES

HORIZON DEPTH	In inches below natural soil surface
DEPTH OF FILL	In inches from land surface
RESTRICTIVE HORIZON	Thickness and depth from land surface
SAPROLITE	S(suitable) or U(unsuitable)
SOIL WETNESS	Inches from land surface to free water or inches from land surface to soil colors with chroma 2 or less - record Munsell color chip designation
CLASSIFICATION	S (Suitable), PS (Provisionally Suitable), or U (Unsuitable)

Evaluation of saprolite shall be by pits.

Long-term Acceptance Rate (LTAR): gal/day/ft^2

Show profile locations and other site features (dimensions, reference or benchmark, and North).

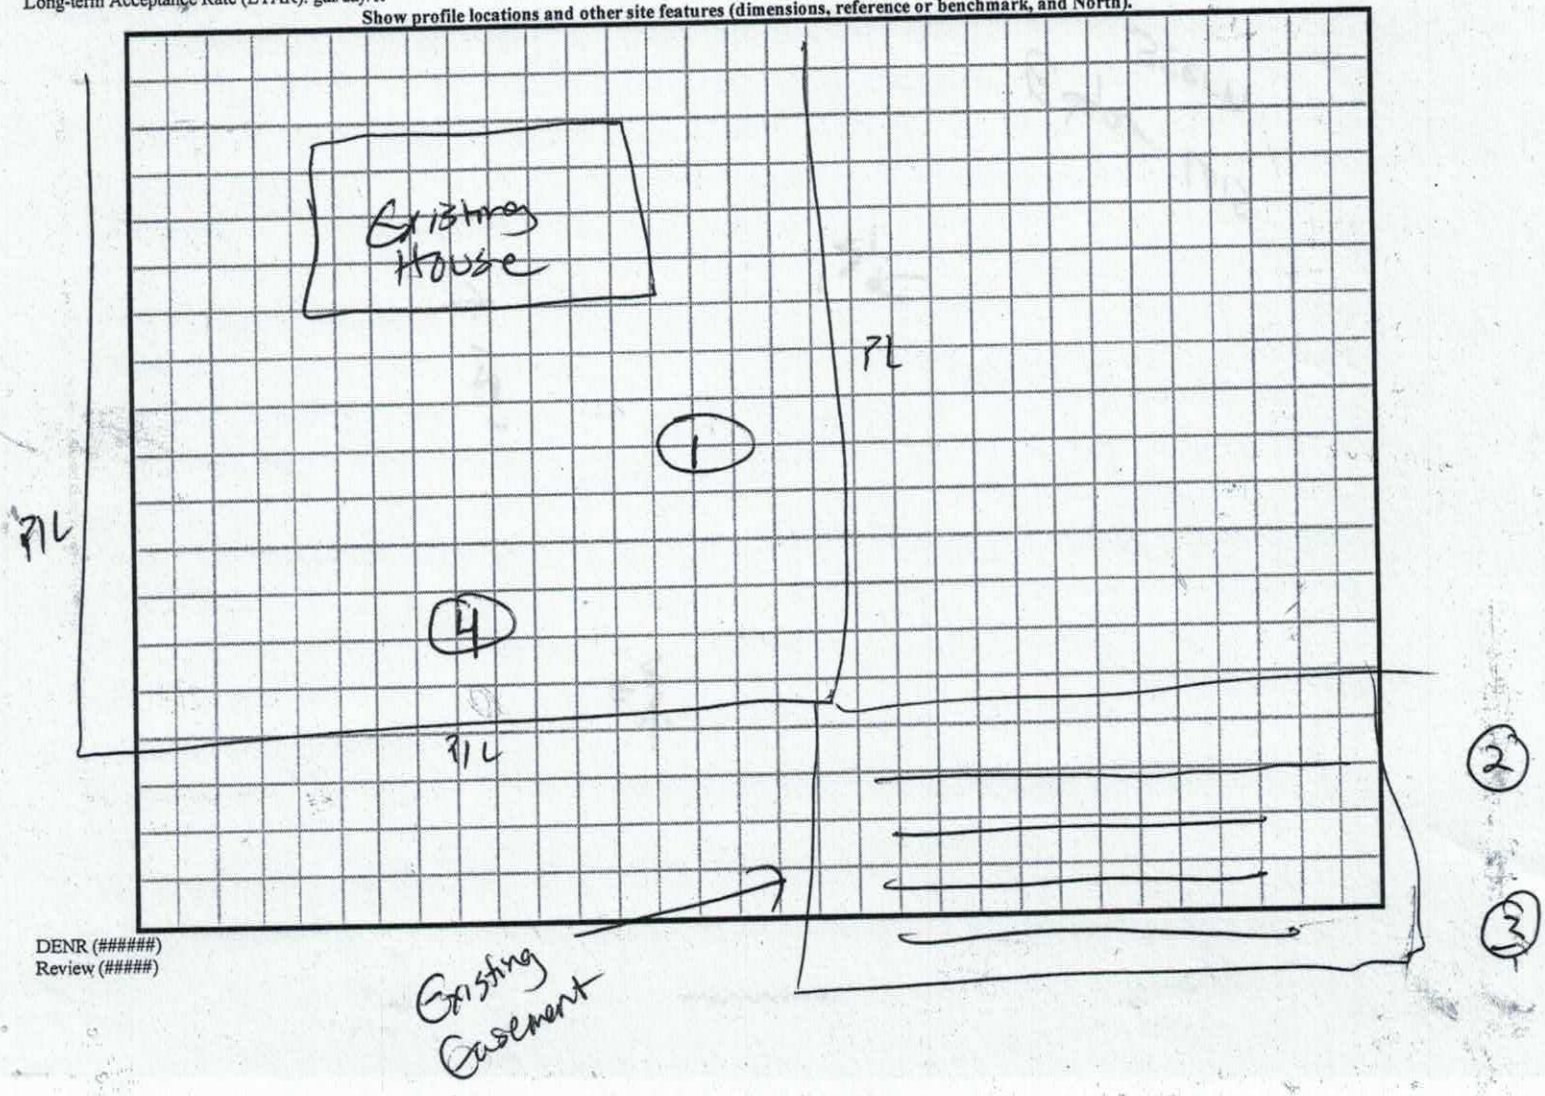

DENR (######)
Review (#####)

IREDELL COUNTY HEALTH DEPARTMENT
ENVIRONMENTAL HEALTH DIVISION
Application for IMPROVEMENT PERMIT, AUTHORIZATION TO CONSTRUCT, or EXISTING SYSTEM INSPECTION

(THE ABOVE PERMIT DOCUMENTS WILL BECOME INVALID IF INFORMATION PROVIDED ON THIS APPLICATION IS FALSIFIED OR CHANGED, OR IF THE SITE IS ALTERED. THE IMPROVEMENT PERMIT IS VALID FOR EITHER 60 MONTHS OR WITHOUT EXPIRATION DEPENDING UPON DOCUMENTATION SUBMITTED - APPLICATION WITH SITE PLAN 60 MONTHS, APPLICATION WITH COMPLETE, SCALED PLAT WITHOUT EXPIRATION. SEE 15A NCAC 18A .1937(f) FOR DETAILS)

1. APPLICATION FOR: X Improvement Permit ___ Authorization To Construct ___ BOTH ___ Existing System Inspection

2. Page 2: *Site Plan Worksheet* Form MUST Accompany This Application
   The following optional attachments may also be submitted: ___ Survey Plat, Scaled no more than 1 Inch = 60 Feet
   Place check ( ) beside whichever is submitted if applicable ___ Custom Site Plan, Scaled no more than 1 Inch = 60 Feet

3. Applicant Information:

Applicant Name	Mailing Address	Home Phone #	Alternate Phone #
Keith Miller	117 Airport Rd, Statesville, NC	704-838-0461	704-902-3764
Owner Name	Mailing Address	Home Phone #	Alternate Phone #
Greg Refour	Pinebur - Valdese, NC	828-878-2832	

4. Property Information:

Street Address	Subdivision Name	Section/Phase and Lot Number
336 Broken Arrow	River Oaks Statesville	

Driving Directions: I-40 - To Sharon School, To Mock Mill - To Broken Arrow (River Oaks) lot on right past club house

$ PAID

5. RESIDENTIAL Site Development Information: *(Check or Complete ALL that apply)*

( ) New, Single Family Residence
( ) New, Multi-Family Residence
(✓) Expansion of Existing Septic System
( ) Repair To Failing Septic System due to ___
( ) Other ___

Maximum Number of Bedrooms 6
Maximum Number of Occupants ___
If Expansion, Current Number of Bedrooms 4

( ) Crawl Space Foundation?
( ) Concrete Slab Foundation?
(✓) Basement w/Plumbing?
( ) Basement w/out Plumbing?

IF Non-Residential Site Development:
Type of Business ___
Square Footage of Building ___
Maximum Number of Employees ___
Maximum Number of Seats ___

6. Proposed Water Supply:

( ) New Well ( ) Existing Well ( ) Community Well ( ) City Water (✓) Other Public Water

7. Desired Septic System Type: *(You may rank in order of preference, if any)* ( ) Existing system--installed in ___ (YEAR)

( ) Alternative ( ) Conventional ( ) Innovative ( ) Modified Conventional ( ) Other ___ ( ) No Preference


8. Please Answer The Following To The Best of Your Ability:

( ) Yes ( ) No Does the site contain any jurisdictional wetlands?
( ) Yes ( ) No Is any non-domestic sewage (i.e. industry) to be generated?
( ) Yes ( ) No Is the site subject to approval by any other public agency?

I have read this application and certify that the information provided herein is true, complete, and correct. Authorized county and state officials are granted right of entry to conduct necessary inspections to determine compliance with applicable laws and rules. I understand that I am solely responsible for the proper identification and labeling of all property lines and corners and making the site accessible so that a complete site evaluation can be performed.

9. Signature: K. Miller — 11-19-13 (DATE)
Property owner or owner's legal representative signature (SIGNATURE REQUIRED)

email

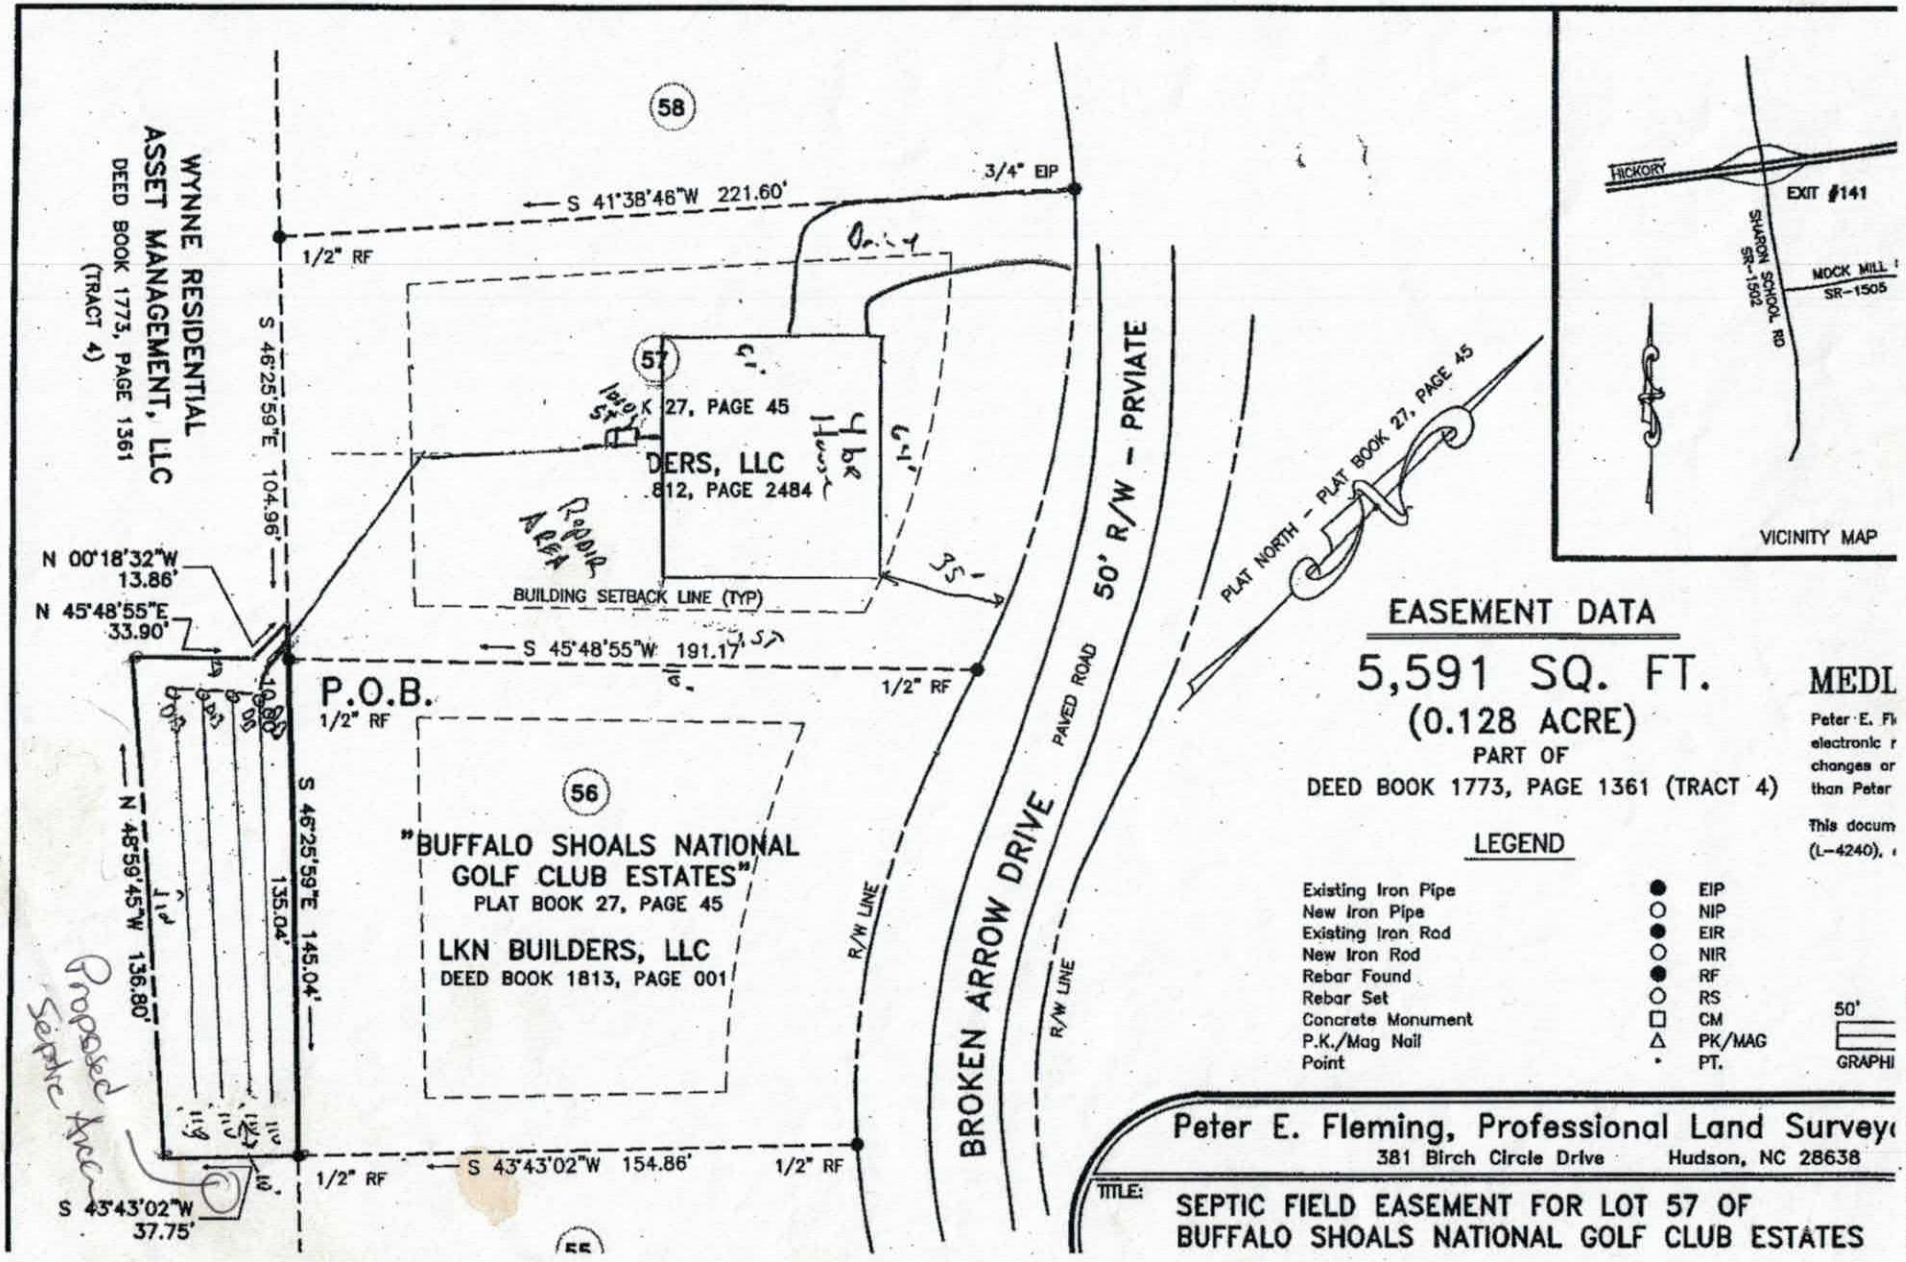
58
57
56
WYNNE RESIDENTIAL ASSET MANAGEMENT, LLC
DEED BOOK 1773, PAGE 1361
(TRACT 4)
S 41°38'46"W 221.60'
3/4" EIP
1/2" RF
S 46°25'59"E 104.96'
N 00°18'32"W 13.86'
N 45°48'55"E 33.90'
S 45°48'55"W 191.17'
P.O.B.
1/2" RF
1/2" RF
S 46°25'59"E 145.04'
N 48°59'45"W 136.80'
135.04'
S 43°43'02"W 154.86'
1/2" RF
1/2" RF
S 43°43'02"W 37.75'
BUILDING SETBACK LINE (TYP)
PLAT BOOK 27, PAGE 45
DERS, LLC
812, PAGE 2484
"BUFFALO SHOALS NATIONAL GOLF CLUB ESTATES"
PLAT BOOK 27, PAGE 45
LKN BUILDERS, LLC
DEED BOOK 1813, PAGE 001
R/W LINE
BROKEN ARROW DRIVE
PAVED ROAD
50' R/W - PRVIATE
R/W LINE
PLAT NORTH - PLAT BOOK 27, PAGE 45
Proposed Septic Area
HICKORY
EXIT #141
SHARON SCHOOL RD SR-1502
MOCK MILL SR-1505
VICINITY MAP
EASEMENT DATA
5,591 SQ. FT.
(0.128 ACRE)
PART OF
DEED BOOK 1773, PAGE 1361 (TRACT 4)
LEGEND
Existing Iron Pipe EIP
New Iron Pipe NIP
Existing Iron Rod EIR
New Iron Rod NIR
Rebar Found RF
Rebar Set RS
Concrete Monument CM
P.K./Mag Nail PK/MAG
Point PT.
50'
GRAPHI
MEDI
Peter E. Fl
electronic r
changes or
than Peter
This docum
(L-4240),
Peter E. Fleming, Professional Land Surveyo
381 Birch Circle Drive Hudson, NC 28638
TITLE:
SEPTIC FIELD EASEMENT FOR LOT 57 OF
BUFFALO SHOALS NATIONAL GOLF CLUB ESTATES

IREDELL COUNTY HEALTH DEPARTMENT

STATESVILLE 704-878-5305 MOORESVILLE 704-664-5281

IMPROVEMENT PERMIT / AUTHORIZATION TO CONSTRUCT / OPERATION PERMIT / EXISTING SYSTEM INSPECTION

PERMIT# 139674 PIN# 3793-41-9037 DATE 26 February 07

OWNER OR APPLICANT LKN Builders LLC PHONE: Business 704-301-9172 Home

ADDRESS 7862 Sarah Drive Denver, N.C. 28037

LOCATION Shanda School Rd. Turn Mock Mill Rd. TR Broken Arrow Rd. Lot on Rt.

SUBDIVISION Buffalo Shoals Nat'l BLOCK / SECTION LOT 57 LOT AREA 0.60 ac. SITE CLASS DS DESIGN FLOW 480 gpd L.T.A.R. 0.275 gpd/sf

Septic Tank: 1000g Gallons: STB WP 1007 Date 3-20-07
Pump Tank: Gallons: PT Date
Pump Make: Model Serial No.
Nitrification Field: No Fields 1 Square Feet 1750 Linear Feet 440
No Lines 4 Trench Width 36" Max Trench Bottom Depth 36" Gravel Depth NA

☑ New System ☐ Repair ☐ Expansion System Type: I (II) III IV V VI
System Description: 25% Reduction - Gravity
Repair System Description: 50% Reduction
Maintenance Agreement Required: ☐ Yes ☑ No

☑ House/Mod. Home No. Bedrooms 4
☐ Mobile Home No. Persons
☐ Business No. Employees
☐ Other

Water Supply: ☐ Individual ☑ Public ☐ Community

☑ Gravity ☐ Pressure ☐ Slab ☐ Crawl Space ☑ Basement w/plumbing ☐ Basement wo/plumbing

Comments/Conditions: * Easement attached / Follow contour /

Comments/Conditions: Filter installed

INITIAL SITE SKETCH

* See attached Site plan

AS BUILT SKETCH

Installed as Drawn on Site Plans

Permit can be suspended or revoked if any false information is supplied toward securing the permit/any unauthorized changes are made to the site/any unauthorized changes are made in the installation of the system. Improvement Permit with plat valid without expiration. ☐ Improvement Permit with site plan valid for sixty months ☑ Authorization to Construct is valid for a period equal to that of Improvement Permit – not to exceed sixty months.

Signed: [signature] date 2/26/07

Improvement Permit by: [signature], R.S. date 26 Feb. 07


Authorization to Construct by: [signature], R.S. date 26 Feb. 07

Installed by: Union Grove Septic

Operation Permit by: [signature], R.S. date 16 May 07

Existing System Inspection by: date

HEALTH DEPT. COPY: WHITE OWNER COPY (FINAL): YELLOW OWNER COPY (INITIAL): PINK

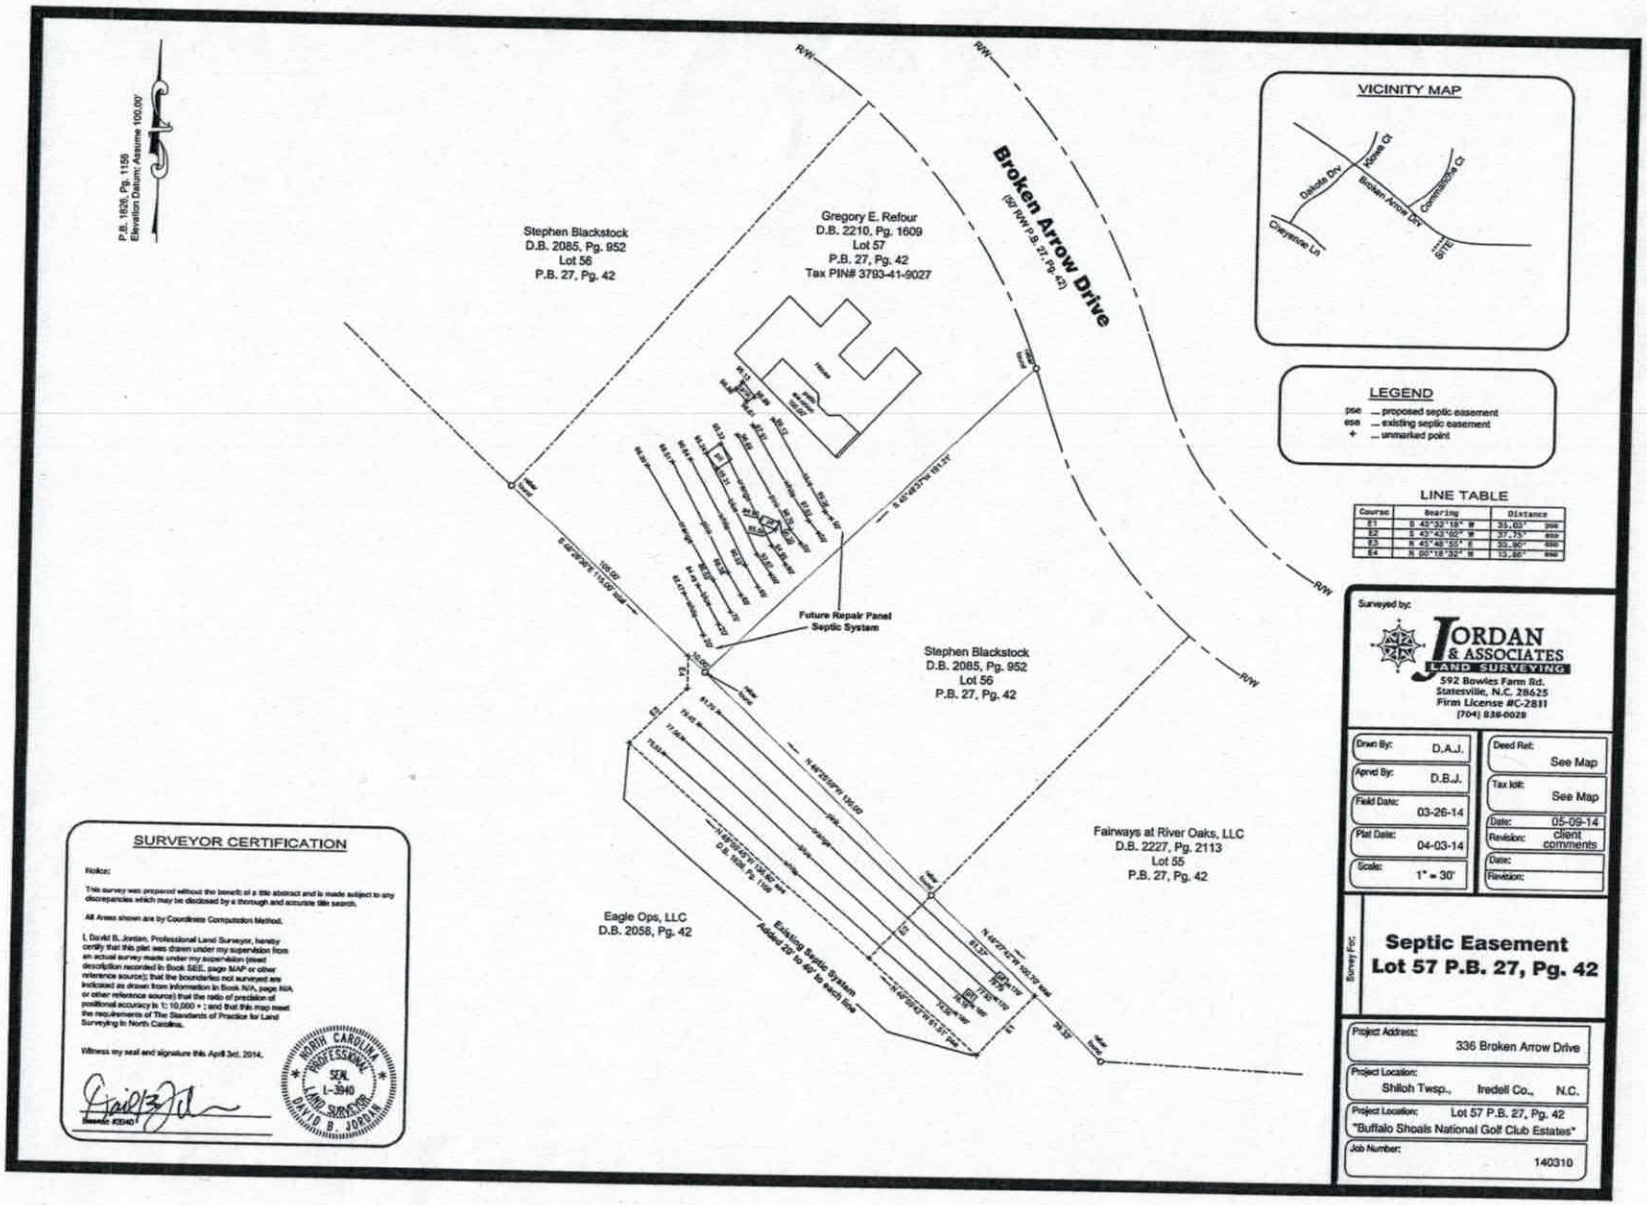

THIS MAP IS NOT A CERTIFIED SURVEY AND HAS NOT BEEN REVIEWED BY A LOCAL GOVERNMENT AGENCY FOR COMPLIANCE WITH ANY APPLICABLE LAND DEVELOPMENT REGULATIONS.

Type: CRP
Recorded: 06/17/2014 at 02:25:04 PM
Fee Amt: $26.00 Page 1 of 5
Revenue Tax: $0.00
Iredell County, NC
Matthew J. McCall Register of Deeds
BK 2304 PG 1018-1022

Prepared by: Groome, Tuttle, Pike & Blair, RLLP

STATE OF NORTH CAROLINA]
]
COUNTY OF IREDELL]

SEPTIC FIELD EASEMENT

THIS SEPTIC FIELD EASEMENT GRANT is made between ***EAGLE OPS, LLC***, a North Carolina limited liability company of Iredell County, North Carolina (referred to as "**the Grantor**") and ***GREGORY E. REFOUR***, whose address is PO Box 565, Valdese, NC 28690, (hereinafter referred to as "**the Grantee**"), all of Iredell County, North Carolina;

W I T N E S S E T H;

The following recitals of fact are a material part of this instrument:

A. The Grantor is the owner of a tract of land located in Shiloh Township, Iredell County, North Carolina, and more particularly described in a deed recorded in Book 2058, at Page 42, Iredell County Registry, and hereinafter referred to as "**Parcel 1**".

B. The Grantee is the owner of a tract of land located in Shiloh Township, Iredell County, North Carolina, and more particularly described in a deed recorded in Book 2210, at Page 1609, Iredell County Registry and hereinafter referred to as "**Parcel 2**".

Page Count: 5
☐NS ☐PQ ☐SI

R.O.T.C.

C. The Grantor wishes to grant and the Grantee wishes to receive an Easement over, under and across parcel 1 described as follows and hereafter referred to as the "**EASEMENT PREMISES**, the description of which is set forth below.

EASEMENT PREMISES

BEGINNING on a rebar, the southeast corner of Lot No. 56, Plat Book 27, Page 45, Iredell County Registry; thence proceeding from said beginning rebar, South 43 degrees 43 minutes 02 seconds West 37.75 feet to an unmarked point; thence South 48 degrees 59 minutes 42 seconds East 61.51 feet to an unmarked point; thence North 43 degrees 32 minutes 18 seconds East 35.03 feet to an unmarked point in the southern line of Lot No. 55, Plat Book 27, Page 45, Iredell County Registry; thence with said southern line of Lot No. 55, North 46 degrees 27 minutes 42 seconds West 100.70 feet to the beginning.

NOW, THEREFORE, in consideration of the sum of Ten ($10.00) Dollars and other valuable consideration, the receipt and sufficiency of which are hereby acknowledged, the following grants, agreements, covenants and restrictions are made:

1. **GRANT OF EASEMENT**. The Grantor hereby grants to the grantee, their heirs and assigns, an easement appurtenant to parcel 2, a perpetual Easement through and upon the Easement Premises for the use and maintenance of a septic field drain area including going upon said property for the purpose of construction, repair and maintenance of said septic field drain area, placing of septic equipment, pipes, and other appropriate equipment for the operation of a septic field drain area. This grant shall include the right of ingress and egress over the Easement Premises for the purpose of repair and maintenance of the drain field and, in general, any rights and privileges which may be necessary for the permanent maintenance of said septic field drain area.

2. **USE OF EASEMENT PREMISES**. Use of the Easement Premises is not confined to the present uses of Parcel 2, the present buildings thereon, if any, or present means of transportation. The installation or maintenance by the Grantee, or assigns, of pipes, conduits, or wires, under, upon or over the Easement Premises is hereby granted and more specifically the use of the Easement Premises for a septic field drain area including going upon said property for the purpose of construction, repair and maintenance of said septic field drain area, placing of septic equipment, pipes, and other appropriate equipment for the operation of a septic field drain area. Exclusive use of the Easement Premises is not granted. Grantee may improve the Easement Premises by grading, removal, addition, and displacement of dirt, application of gravel or other surface materials.

3. **USE OF PARCELS 1 AND 2.** The uses of Parcel 1 or 2 are not restricted in any way by the

grant of this Easement. Either parcel may be used by their respective owners in such manner as they deem appropriate and as by law allowed.

4. **ADDITIONS TO DOMINANT TENEMENT.** Said easement is also appurtenant to any land that may hereafter come into common ownership with Parcel 2 aforesaid and that is contiguous to Parcel 2. An area physically separated from Parcel 2 but having access thereto by means of public ways or private easements, rights or license is deemed to be contiguous to Parcel 2.

5. **WARRANTIES OF TITLE.** Grantor warrants that he has good and indefeasible fee simple title to the Easement Premises; subject only to the following permitted title objections: None

6. **RUNNING OF BENEFITS AND BURDENS.** All provisions of this instrument, including the benefits and burdens, run with the land and are binding upon and enure to the heirs, assigns, successors, tenants and personal representatives of the parties hereto.

7. **CONSTRUCTION.** The rule of strict construction does not apply to this grant. This grant shall be given a reasonable construction so that the intention of the parties to confer a usable right of enjoyment on the grantee is carried out.

IN WITNESS WHEREOF the Grantor have set their hands and seals this 16th day of JUNE, 2014.

EAGLE OPS, LLC **(SEAL)**

by: _____

Anthony L. Henderson
Member/Manager

NORTH CAROLINA

IREDELL COUNTY

I certify that the following person(s) personally appeared before me this day, and (I have personal knowledge of the identity of the principal(s)) (I have seen satisfactory evidence of the principal's identity, by a current state or federal identification with the principal's photograph in the form of a known) (a credible witness has sworn to the identity of the principal's); each acknowledging to me that he or she voluntarily signed the foregoing document for the purpose stated therein and in the capacity indicated: **ANTHONY L. HENDERSON as Member/Manager of EAGLE OPS, LLC**


Date: June 16th 2014 Lynn H. Poole
Official Signature of Notary

Lynn H. Poole
Notary's printed or typed name, Notary Public


(Official Seal)



My commission expires: 3/4/17

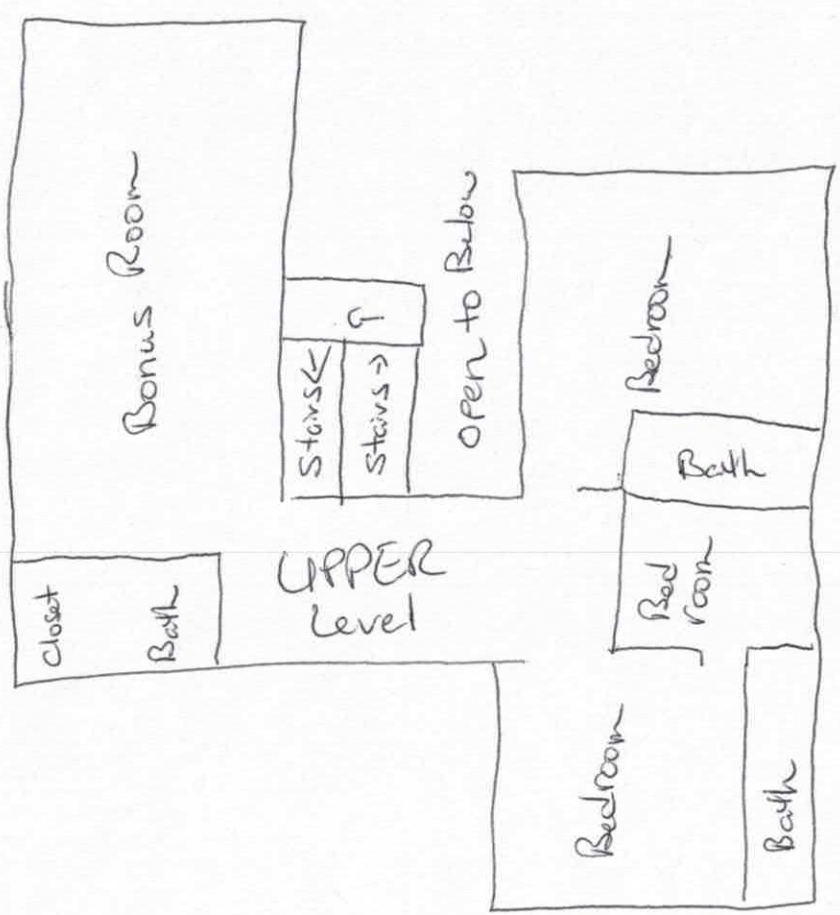



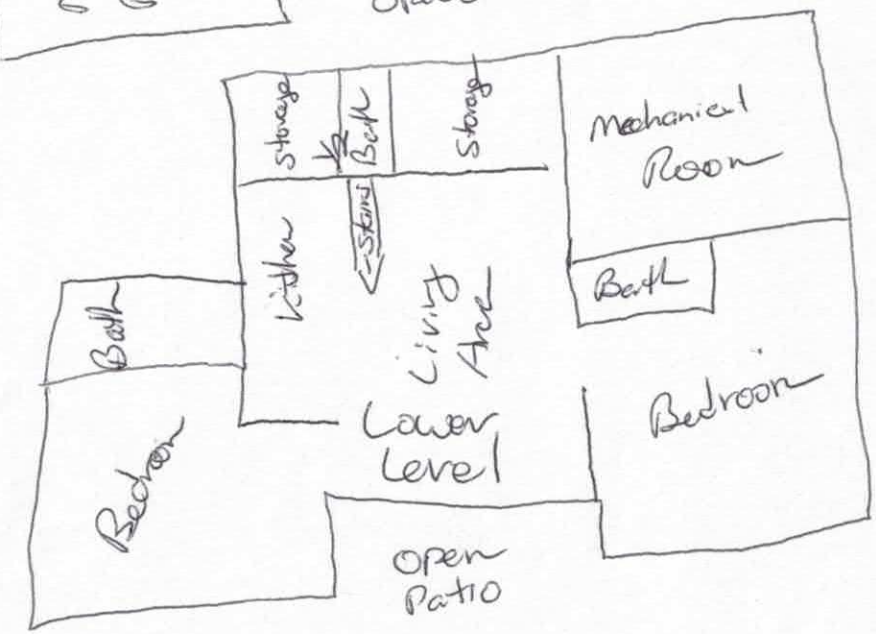

Acknowledgement Of
Plans Submittal ONLY!

Justin Henderson Date 6-17-14

Date 6-17-14

Corrected Parcel info.

IREDELL COUNTY

PO Box 788
349 North Center St.
Statesville, NC 28677

APPLICATION NUMBER
200334
Issue Date: 11/19/2013

Permit Type: IMPROVEMENT PERMIT APPLICATION

Parcel Number	Street Address	Jurisdiction
3793419027.000	336 BROKEN ARROW DRIVE	STATESVILLE

Owner Information	Applicant Information	Contractor Information
Owner: Greg Refore	Applicant:	Contractor: MILLER, KEITH
Address: Pine Burr Valdese, NC	Address:	Address: 117 AIRPORT ROAD STATESVILLE, NC 28677
Phone: 828-878-2832	Phone:	Phone: 704-402-3764
		License Type License Number

Project Description

NEW SEPTIC SYSTEM PERMIT GRAVI

Scope of Work

ADD LINES

Permit Details:

	IMPROVEMENT PERMIT FEE	Amount:	500.00
		Amount:	
		Amount:	
		Amount:	
		Amount:	
		Amount:	
		Amount:	

I hereby certify that all information in this application is correct and all work will comply with the state code and all other applicable state and local laws, ordinances and regulations. The respective department will be notified of any changes in the approved plans, a change of contractor, and/or specifications for the project permitted herein. This application becomes a permit only when validated and approved.

Date: 11/19/2013

Signature of Owner/Contractor

ANY PERMIT ISSUED EXPIRES SIX (6) MONTHS AFTER ISSUANCE IF NO INSPECTIONS HAVE BEEN MADE. ANY PERMIT ISSUED SHALL EXPIRE TWELVE (12) MONTHS AFTER LAST INSPECTION IF THE WORK IS DISCONTINUED.

Permit Number	1173	TOTAL FEES:	$ 500.00