IREDELL COUNTY HEALTH DEPARTMENT

STATESVILLE 704-878-5305 MOORESVILLE 704-664-5281

IMPROVEMENT PERMIT / AUTHORIZATION TO CONSTRUCT / OPERATION PERMIT / EXISTING SYSTEM INSPECTION

PERMIT# 139674 PIN# 3793-41-9037 DATE 26 February 07

OWNER OR APPLICANT LKN Builders LLC PHONE: Business 704-201-9172 Home

ADDRESS 7862 Sandy Drive Denver, N.C. 28037

LOCATION Sharon School Rd. from Mock Mill Rd. TR Broken Arrow Rd. Lot on Rt.

SUBDIVISION Buffalo Shoals Nat'l BLOCK / SECTION LOT 57 LOT AREA 0.60 ac. SITE CLASS. DS DESIGN FLOW 480 gpd. L.T.A.R. 0.275 gpd/sf/d

Septic Tank: 1000g Gallons: STB WP 1007 Date 3-20-07
Pump Tank: Gallons: PT Date
Pump Make: Model Serial No.
Nitrification Field: No Fields 1 Square Feet 1750 Linear Feet 440
No Lines 4 Trench Width 36" Max Trench Bottom Depth 36"

☑ New System ☐ Repair ☐ Expansion System Type: I II III IV V VI
System Description: 25% Reduction - Conv. I/
Repair System Description: 50% Reduction
Maintenance Agreement Required: ☐ Yes ☑ No

☑ House/Mod. Home No. Bedrooms 4
☐ Mobile Home No. Persons
☐ Business No. Employees
☐ Other

Water Supply: ☐ Individual ☑ Public ☐ Community

Gravel Depth NA ☑ Gravity ☐ Pressure ☐ Slab ☐ Crawl Space ☑ Basement w/plumbing ☐ Basement wo/plumbing

Comments:/Conditions: * Easement Attached / Follow contour /

Comments:/Conditions: Filter installed

INITIAL SITE SKETCH

* See Attached Site plan

AS BUILT SKETCH

Installed as Drawn on Site Plan.

Permit can be ~~suspended or revoked if any false information~~ is supplied toward securing the permit/any unauthorized changes are made to the site/any unauthorized changes are made in the installation of the system. Improvement Permit with plat valid without expiration ☐ Improvement Permit with site plan valid for sixty months ☑ Authorization to Construct is valid for a period equal to that of Improvement Permit – not to exceed sixty months.

Signed: date 2/26/07

Improvement Permit by: R.S date 26 Feb. 07


Authorization to Construct by: R.S. date 26 Feb. 07

Installed by: Union Grove Septic

Operation Permit by: R.S. date 16 May 07

Existing System Inspection by: date

HEALTH DEPT. COPY: WHITE OWNER COPY (FINAL): YELLOW OWNER COPY (INITIAL): PINK

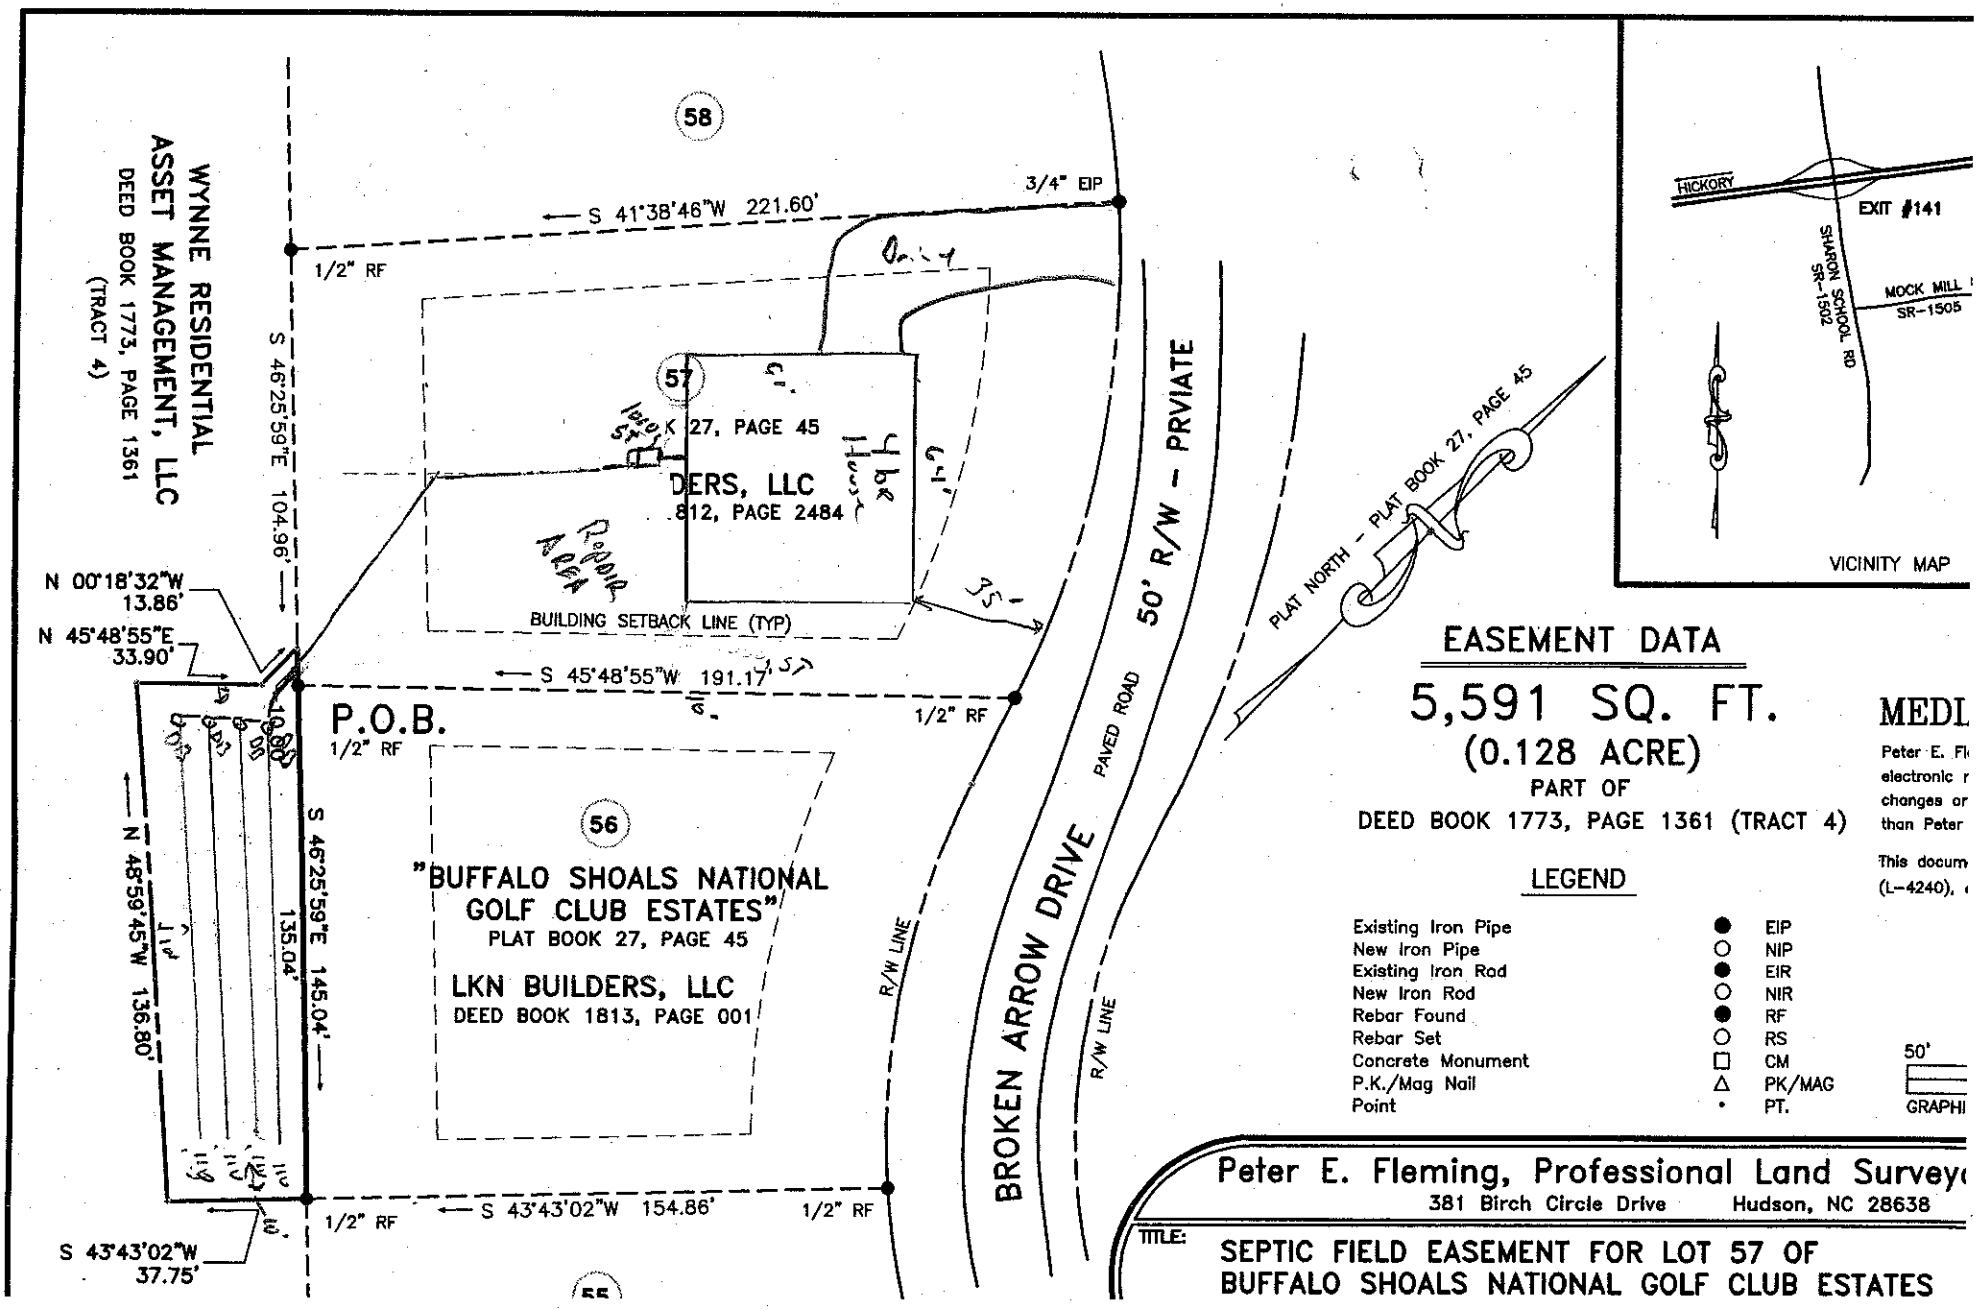

EASEMENT DATA

5,591 SQ. FT.

(0.128 ACRE)

PART OF

DEED BOOK 1773, PAGE 1361 (TRACT 4)

LEGEND

Existing Iron Pipe	●	EIP
New Iron Pipe	○	NIP
Existing Iron Rod	●	EIR
New Iron Rod	○	NIR
Rebar Found	●	RF
Rebar Set	○	RS
Concrete Monument	□	CM
P.K./Mag Nail	△	PK/MAG
Point	•	PT.

50'

GRAPHI

MEDL

Peter E. Fl
electronic r
changes or
than Peter

This docum
(L-4240), c

Peter E. Fleming, Professional Land Surveyo
381 Birch Circle Drive Hudson, NC 28638

TITLE: SEPTIC FIELD EASEMENT FOR LOT 57 OF BUFFALO SHOALS NATIONAL GOLF CLUB ESTATES