IREDELL COUNTY HEALTH DEPARTMENT

STATESVILLE 704-878-5305 MOORESVILLE 704-664-5281

IMPROVEMENT PERMIT / AUTHORIZATION TO CONSTRUCT / OPERATION PERMIT / EXISTING SYSTEM INSPECTION

PERMIT# 135305 PIN# 3793-43-6484 DATE 5-22-06

OWNER OR CONTRACTOR Christina + BRANDON SMITH PHONE: Business 800-508-1907 Home 704-451-8023

ADDRESS 1199 BRAWLEY SCHOOL RD MOORESVILLE, NC 28117

LOCATION 40 WEST (L) SHARON (L) MOLLOCKALL (R) Fitlist (R) MAXELI (R) TAYLORMADE AT END

SUBDIVISION AUGUSTA GREENS BLOCK / SECTION 2 LOT 68 LOT AREA 3.14 AC SITE CLASS. PS DESIGN FLOW 480 L.T.A.R. .13

Septic Tank: 1000 Gallons; STB 825 Date 12-4-06

Pump Tank: Gallons; PT Date

Pump Make: Model Serial No.

Nitrification Field: No Fields 1 Square Feet 1600' Linear Feet 533'

No Lines 5x107 Trench Width 36" Max Trench Bottom Depth 36" Gravel Depth 12"

☒ New System ☐ Repair System Type: I, (II), III, IV, V, VI

System Description: GRAV CONV

Repair System Description: Pump/ Grav 25%

Maintenance Agreement Required: ☐ Yes ☒ No

☐ Slab ☐ Crawl Space ☒ Basement w/plumbing ☐ Basement wo/plumbing

☒ House/Mod. Home ☐ Mobile Home ☐ Business ☐ Other


No. Bedrooms 4 No. Bathrooms 4 No. Employees

Water Supply: ☐ Individual ☒ Public ☐ Community

Comments:/Conditions: (1) SMOOTH CUT TERRACES IN SYSTEM AREA'S (2) DETOUR SURFACE H2O 15' sideslope of tank as drawn (3) MAINTAIN SETBACK (4) BASEMENT ALREADY GRADED AT TIME OF L/D

Comments:/Conditions: (5) KEEP FALL TO TANK FROM BASEMENT CUT AS DRAWN (6) AN APPROVED ACCEPTED SYSTEM MAY BE USED.

INITIAL SITE SKETCH "NOT TO SCALE"

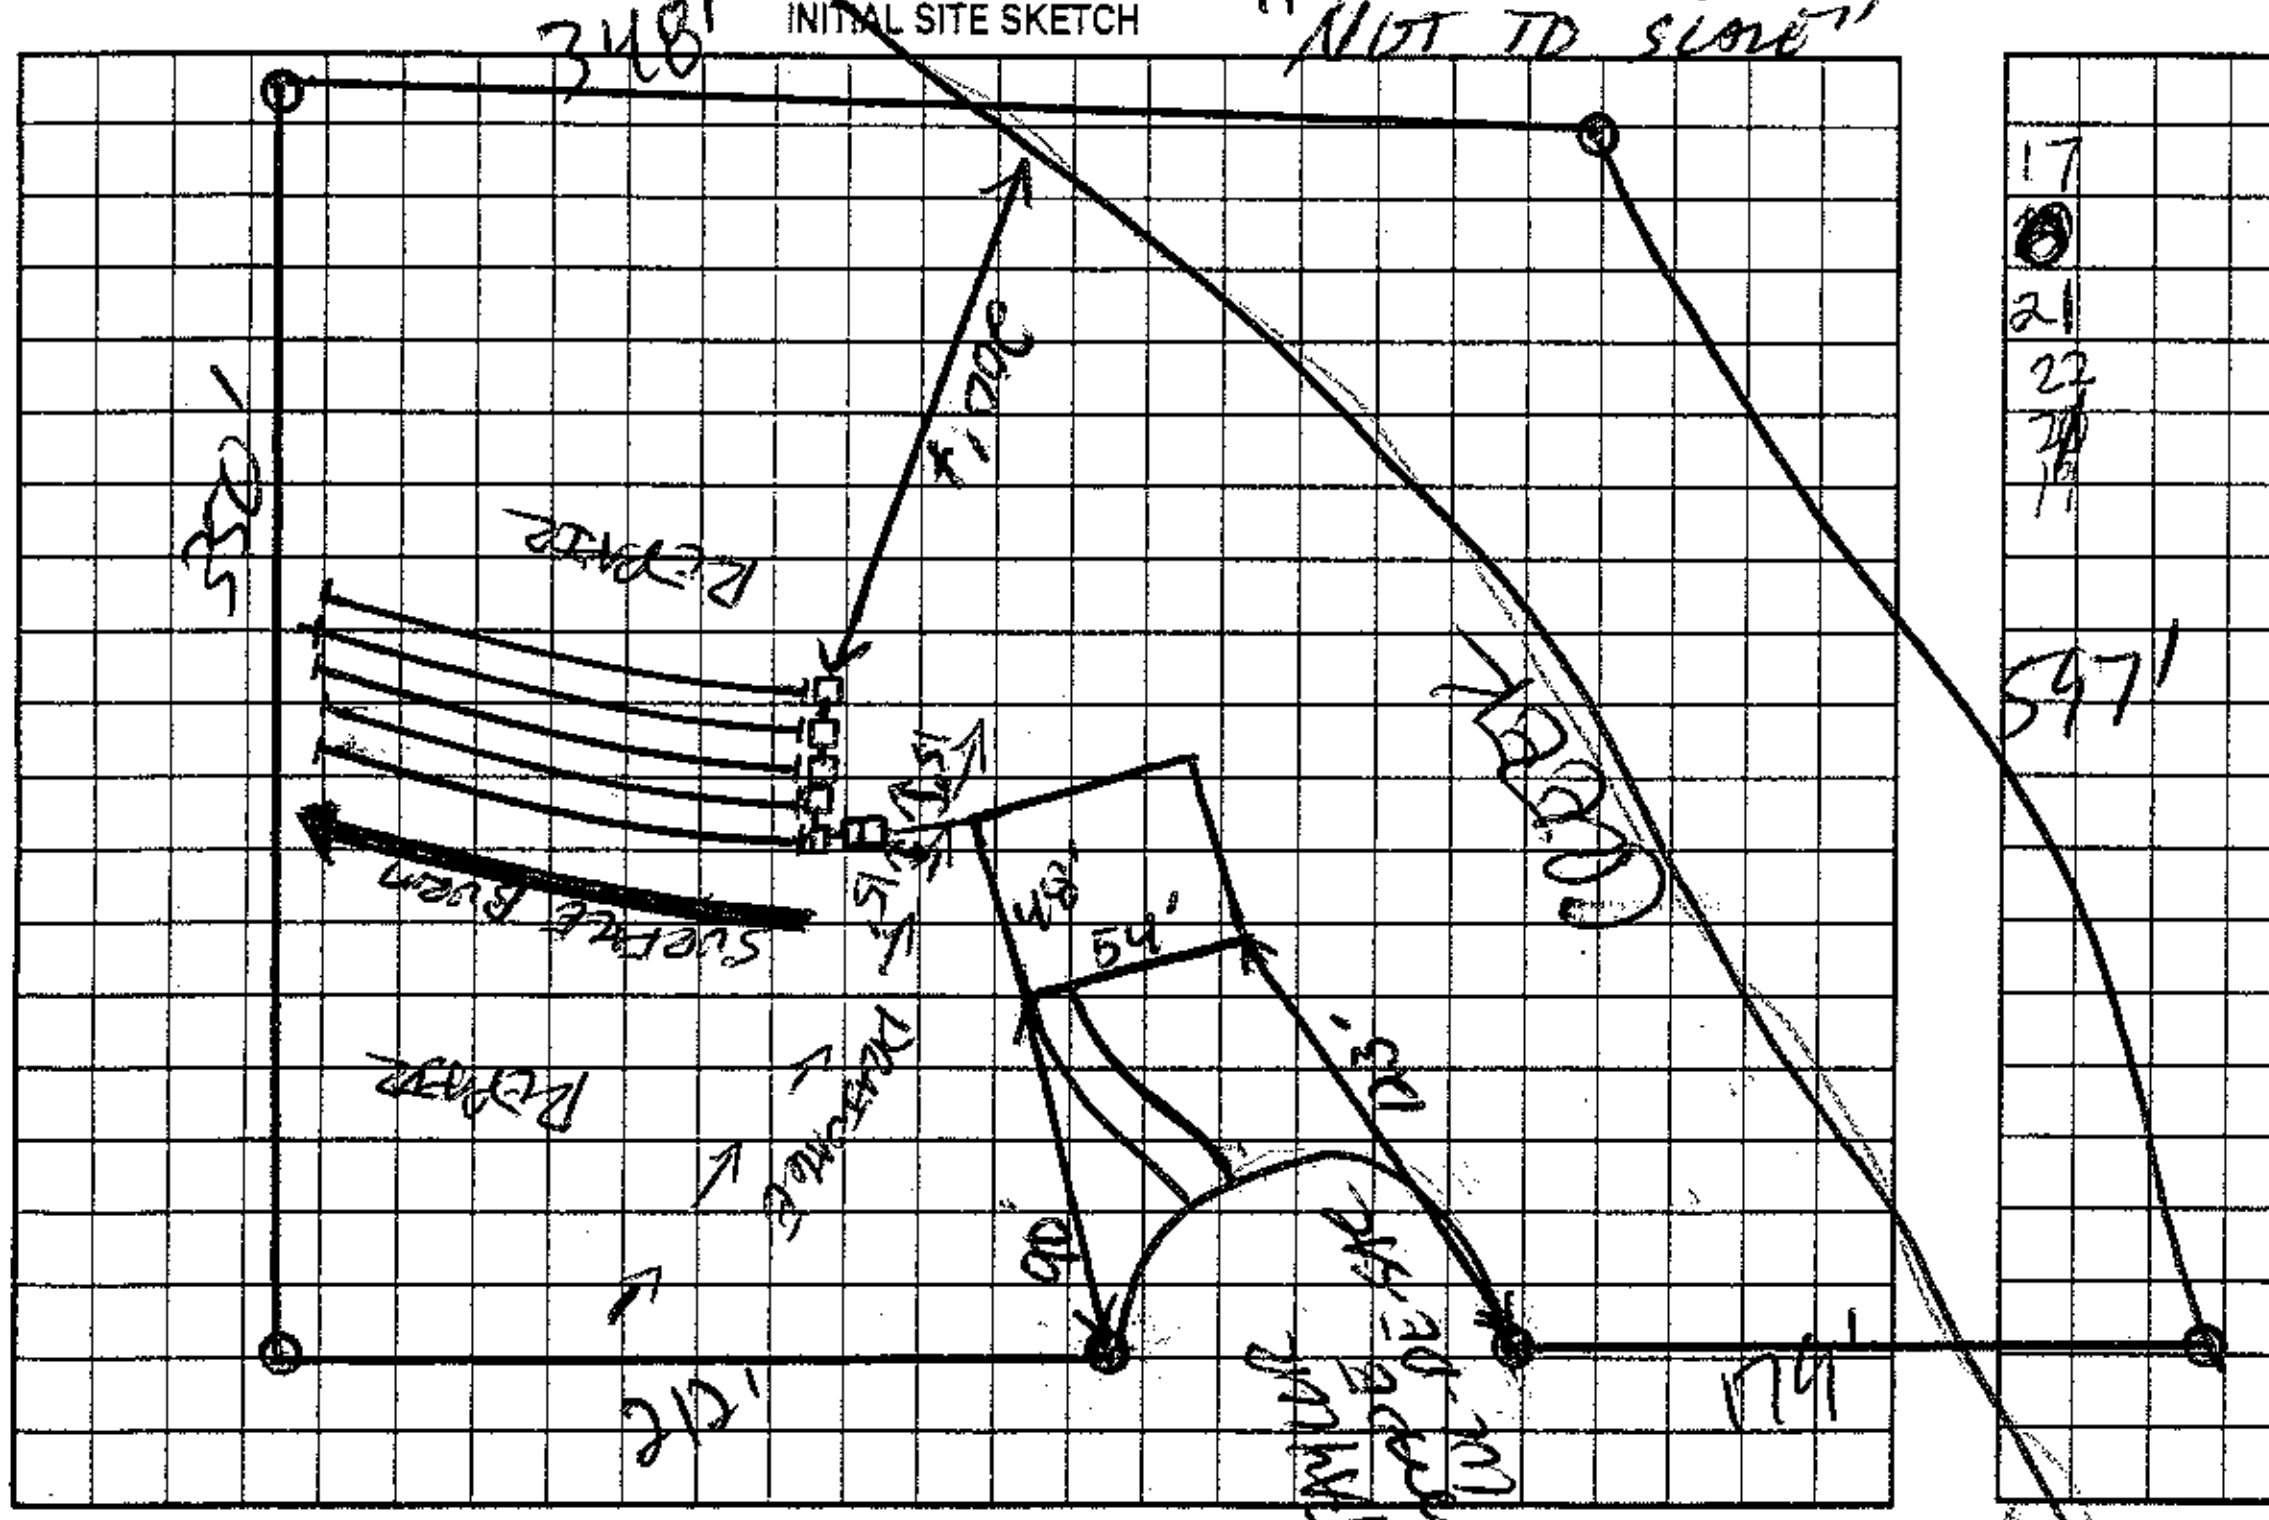

AS BUILT SKETCH

17
21
22

Permit can be suspended or revoked if any false information is supplied toward securing the permit/any unauthorized changes are made to the site/any unauthorized changes are made in the installation of the system. Improvement Permit with plat valid without expiration. Improvement Permit with site plan valid for sixty months. Authorization to Construct is valid for a period equal to that of Improvement Permit – not to exceed sixty months.

Signed: Christina Smith date 05/25/06 Installed by: Rowan Septic

Improvement Permit by: [signature] RS date 5-22-06 Operation Permit by: [signature] date 1-17-07

Authorization to Construct by: [signature] RS date 5-22-06 Existing System Inspection by: date

HEALTH DEPT. COPY: WHITE OWNER COPY (FINAL): YELLOW OWNER COPY (INITIAL): PINK