2130

IREDELL COUNTY HEALTH DEPARTMENT

[redacted] Office (704) 878-5305 Mooresville Office (704) 660-3625 PERMIT # 220174

IMPROVEMENT PERMIT / AUTHORIZATION TO CONSTRUCT / OPERATION PERMIT / EXISTING SYSTEM

PIN # 3793-44-7461 ✓

APPLICANT: Capote Builders + Developers APPLICANT ADDRESS: 5426 Capote Rd. Maiden, NC 28650

SITE ADDRESS: 112 Ping Court - Statesville, NC PHONE: 704-483-7313 ALT. PHONE:

SITE DIRECTIONS: I-40 W → L on Sharon School Rd → L on Mock Mill Rd → R on T. Heist Dr. → R on Big Bertha Dr. → Lot @ End along Ping Court

SUBDIVISION: Augusta Greens SECTION: 2 LOT # 29 LOT AREA: 0.738 acres DESIGN FLOW: 480 L.T.A.R.: 0.30


Septic Tank	1000 (gal)	STB	720	Date	9-1-16	☒ New System	☐ Repair	☐ Expansion	System Type: I II (III) IV V VI	☒ Residence	No. Bedrooms 4
Pump Tank	— (gal)	PT	—	Date	—	System Description:	25% Reduction			☐ Business	No. Persons 8
Pump Make	—	Model	—	Serial #	—	Repair System Description:	50% Reduction (PPBFS)			☐ Other	No. Employees —
# Nitrification Fields	1	# Lines	3	Linear Ft:	400	Maintenance Agreement Required:	☐ YES	☒ NO		☐ Slab	☒ Crawl Space
Trench Width	36"	Trench Bottom Depth	32" [low side]	Gravel Depth	—		☒ GRAVITY	☐ PRESSURE		☐ Basement w/plumbing	☐ Basement w/o plumbing

Water Supply: ☐ Private ☒ Public ☐ Community


Comments / Conditions: Recommend pumping septic tank every 3-5 years

4/5/17 Tank & 2 lines
4/6/17 Checked last line

INITIAL SITE SKETCH

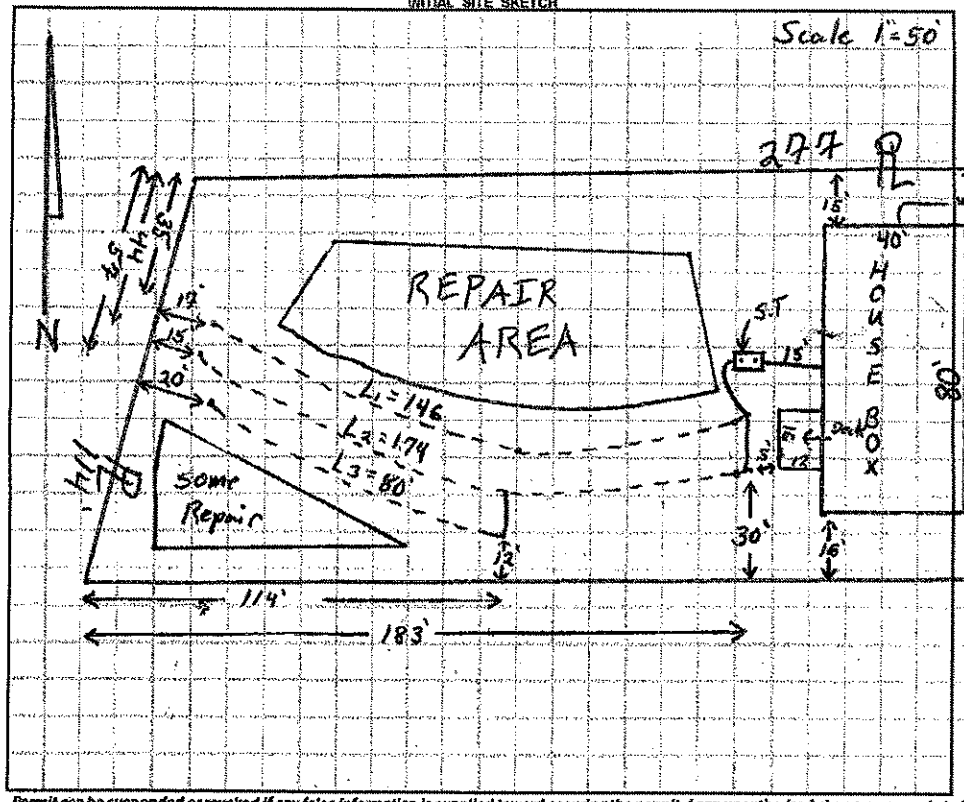

AS BUILT SKETCH

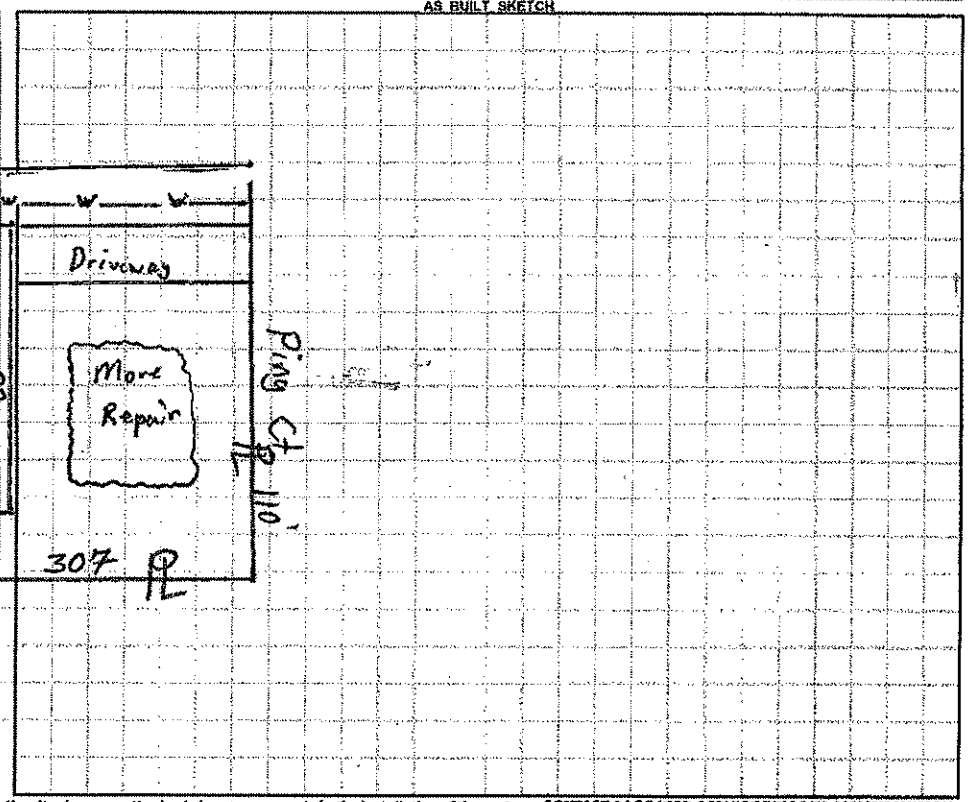

Permit can be suspended or revoked if any false information is supplied toward securing the permit / any unauthorized changes are made to the site / any unauthorized changes are made in the installation of the system. **CONTACT A LOCATOR SERVICE PRIOR TO ANY EXCAVATION**

☐ **IMPROVEMENT PERMIT** *with plat valid without expiration.* ☒ **IMPROVEMENT PERMIT** *with site plan valid for 60 mos.* ☒ **AUTHORIZATION TO CONSTRUCT** *valid for period equal to IMPROVEMENT PERMIT--not to exceed 60 mo.*

Owner / Applicant Signature: [signature] Date: 2-14-17 Installed by: Groundbreakers

IMPROVEMENT PERMIT by: [signature] Date: 3/14/17 OPERATION PERMIT by: Maria Dotson Date: 4/6/17

AUTHORIZATION TO CONSTRUCT by: [signature] Date: 3/14/17 Existing System Inspected by: Date:

Health Dept. Copy - WHITE Applicant (Final Approval) - YELLOW Applicant (Conditional Approval) - PINK