34567 Authorization To Construct 11/06 Tommy Frye

IREDELL COUNTY HEALTH DEPARTMENT

STATESVILLE 704-878-5305 MOORESVILLE 704-664-5281

IMPROVEMENT PERMIT / ~~CERTIFICATE OF COMPLETION~~ / OPERATION PERMIT / EXISTING SYSTEM INSPECTION

PROPERTY DESCRIPTION NO 23914 DATE 6/12/96 TAX MAP NO 8H-5-A-10 Watershed: Yes No

OWNER OR CONTRACTOR Morris Rasnick PHONE Business Home 872-0921

ADDRESS 628 Mock Mill Rd

LOCATION Old Mountain, Rt on Beulah To Mock Mill, Pass Lake Circle, Pass Church, MH 0.1 on Rt Baptist

SUBDIVISION BLOCK / SECTION LOT LOT AREA SITE CLASS DESIGN FLOW L.T.A.R.

Septic Tank EXISTING Gallons: STB Date
Pump Tank Gallons: RT Date
Pump Make Model Serial No
Nitrification Field: No Fields 1 Square Feet 240 Linear Feet 80
No Lines 2 Trench Width 36" Max Trench Bottom Depth 36" Gravel Depth 12"

New System / Repair System Type I II III IV V VI
System Description Conv Circuit
Repair System Description
Maintenance Agreement Required Yes No
Slab Crawl Space Basement w/plumbing Basement wo/plumbing


House/Mod. Home No Bedrooms 3
Mobile Home No Bathrooms 2½
Business No Employees
Other Doublewide

Water Supply: Individual Community Public On Site


Comments: Add 80' Line in Configuration Necessary to bring to 3 Br Compliance

Comments: Exist MH must be pulled off property !!

INITIAL SITE SKETCH

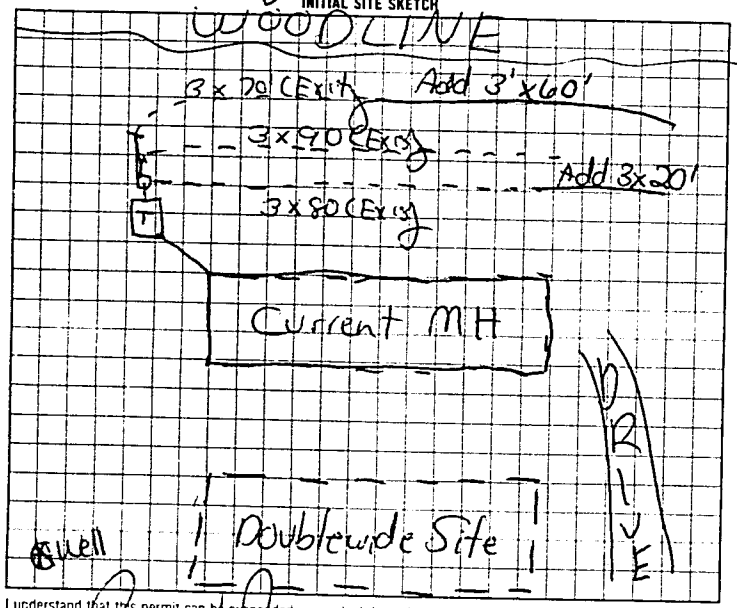

AS BUILT SKETCH

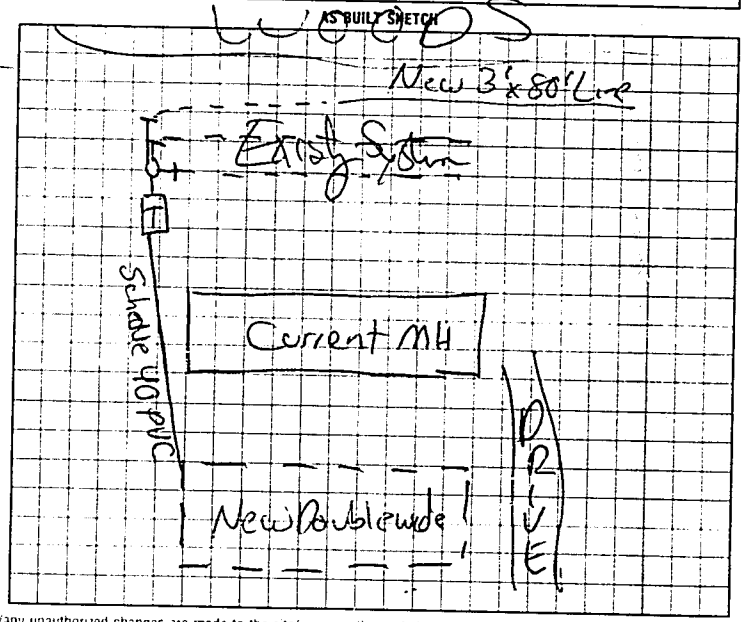

I understand that this permit can be suspended or revoked if any false information is supplied toward securing the permit/any unauthorized changes are made to the site/any unauthorized changes are made in the installation of the system

Signed

Improvement Permit by date 6/12/96

Existing System Inspection by date

Authorization To Construct

INSPECTION COPY (FINAL) GREEN OWNER COPY (FINAL) YELLOW

Installed by Tommy Frye

Certificate of Completion by date

Operation Permit by date 7/2/96

INSPECTION COPY (INITIAL) PINK OWNER COPY (INITIAL) GOLD