IREDELL COUNTY HEALTH DEPARTMENT

Statesville Office (704) 878-5305 Mooresville Office (704) 660-3625 PERMIT # 21546?

IMPROVEMENT PERMIT / AUTHORIZATION TO CONSTRUCT / OPERATION PERMIT / EXISTING SYSTEM

PIN # 3793506906

APPLICANT: Ashley Rollans APPLICANT ADDRESS: PO Box 832 Mooresville

SITE ADDRESS: 312 Broken Arrow Dr. PHONE: 704-746-5046 ALT. PHONE: N/A

SITE DIRECTIONS: I-40W to Sharon School Rd TL Sharon School TL Mockmill TR Broken Arrow

SUBDIVISION: Buffalo Shoals National Golf Club SECTION: BLK F LOT # 56 LOT AREA: 0.5 acres DESIGN FLOW: 480 gpd L.T.A.R.: 0.3

Septic Tank Existing (gal) STB Date

Pump Tank (gal) PT Date

Pump Make Model Serial #

Nitrification Fields 1 # Lines 3 Linear Ft: 150

Trench Width 24" Max. Trench Bottom Depth 35" Gravel Depth N/A

☐ New System ☐ Repair ☑ Expansion System Type: I II (III) IV V VI

System Description: PPBPS Gravity

Repair System Description: Low Pressure PPBPS

Maintenance Agreement Required: ☐ YES ☑ NO

☑ GRAVITY ☐ PRESSURE

☑ Residence No. Bedrooms 4

☐ Business No. Persons 8

☐ Other No. Employees

☐ Slab ☐ Crawl Space

☑ Basement w/plumbing ☐ Basement w/o plumbing

Water Supply: ☐ Private ☑ Public ☐ Community

Comments / Conditions: -Remove existing fill from nitrification filed as shown on plan.

INITIAL SITE SKETCH

See attached plan by:

Rollans Soil & Environmental Services, P.A.

AS BUILT SKETCH

- Installed as drawn

Permit can be suspended or revoked if any false information is supplied toward securing the permit / any unauthorized changes are made to the site / any unauthorized changes are made in the installation of the system. **CONTACT A LOCATOR SERVICE PRIOR TO ANY EXCAVATION**

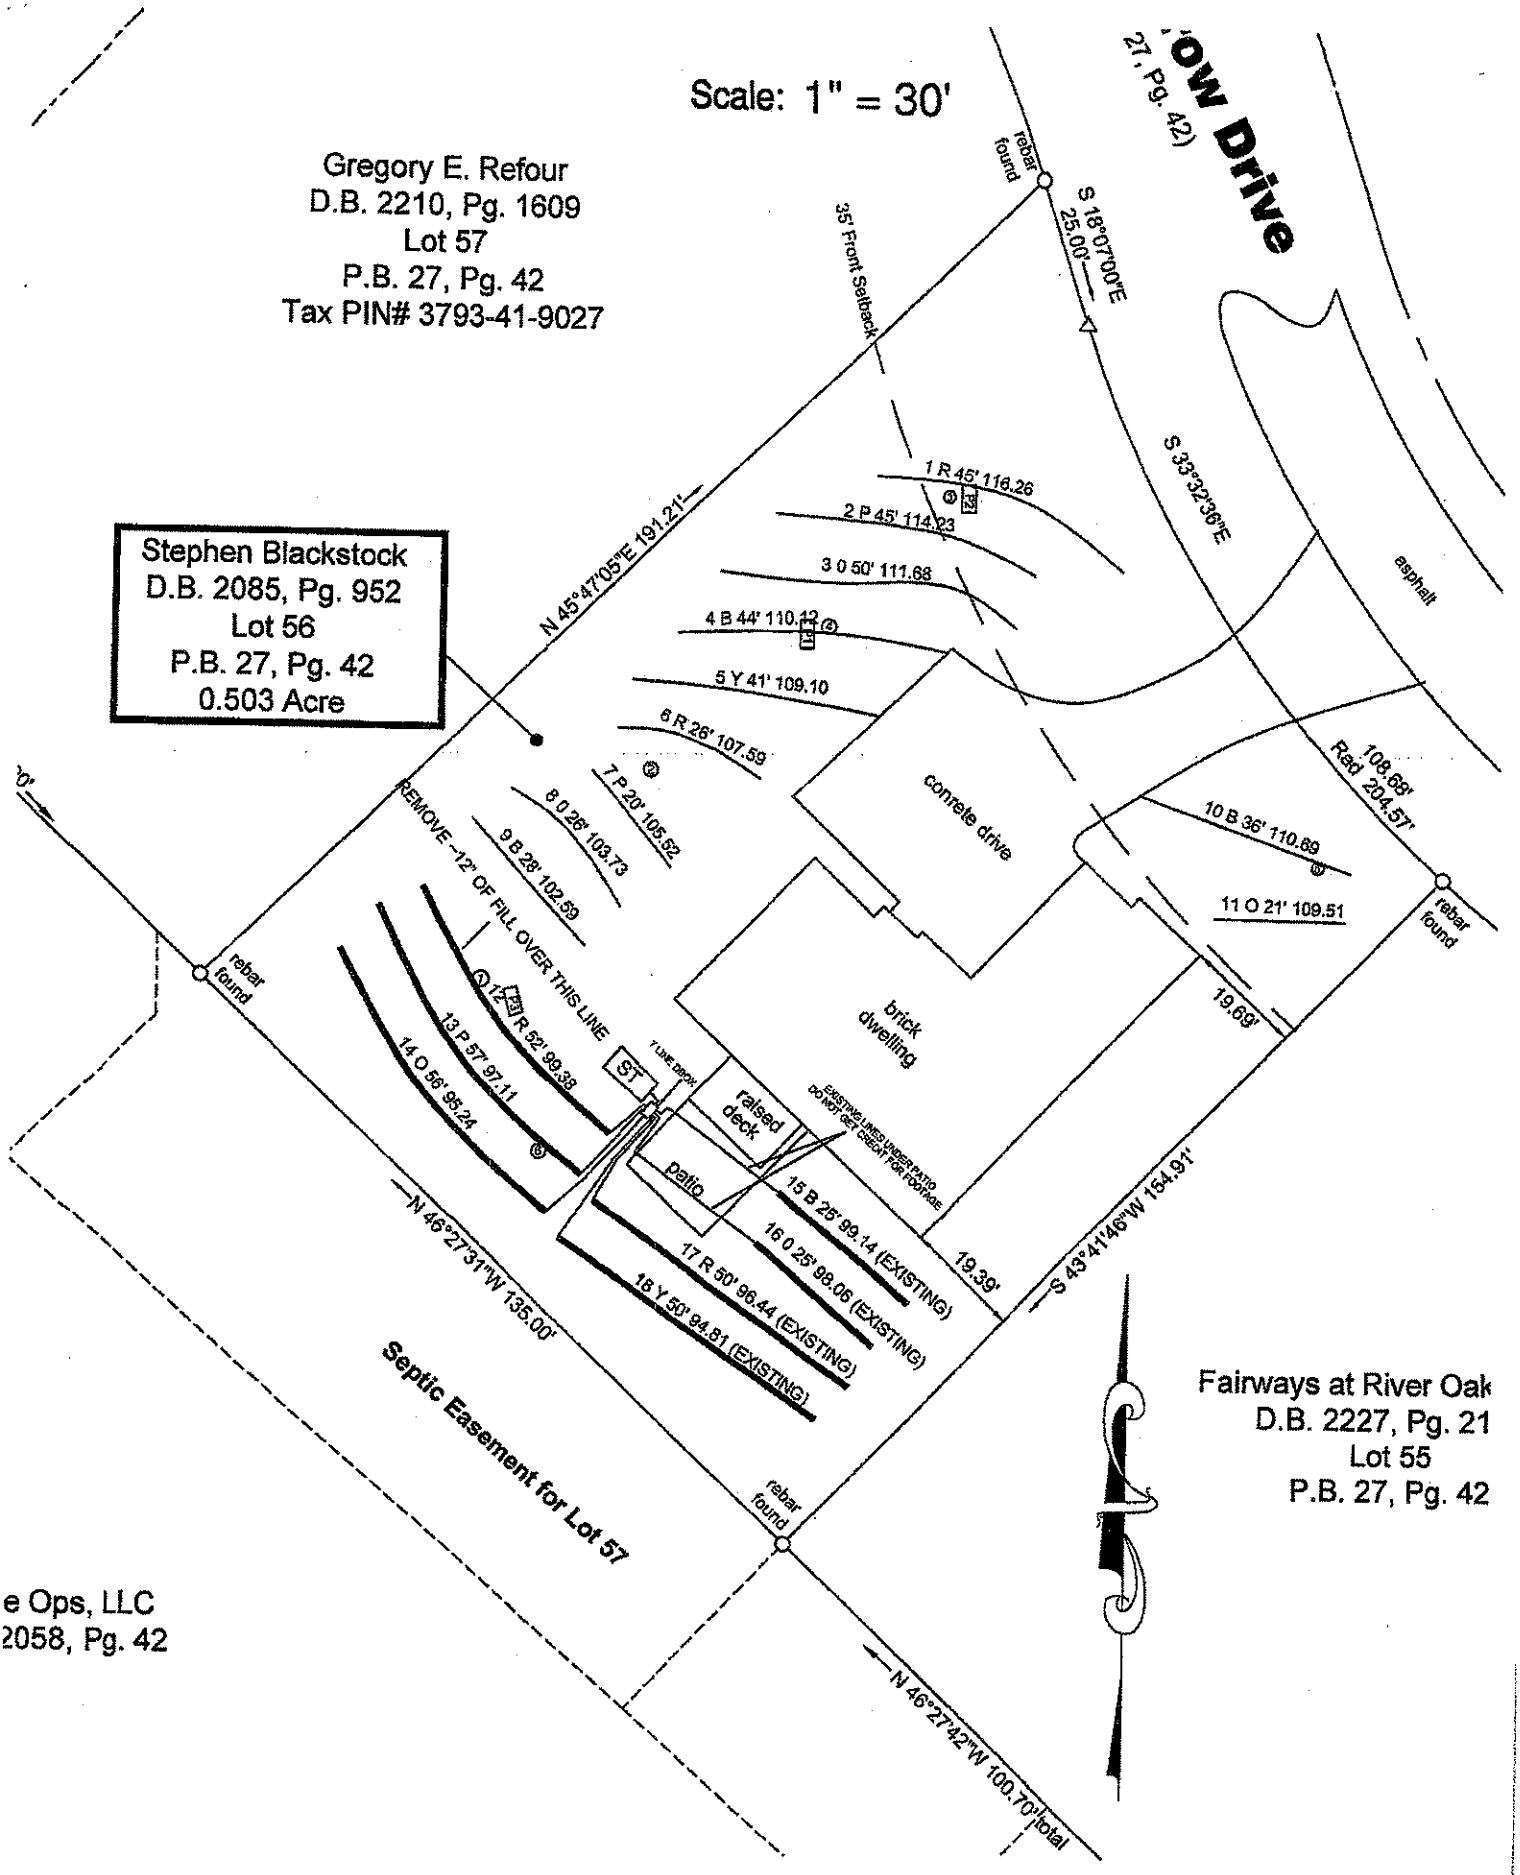
☐ **IMPROVEMENT PERMIT** *with plot valid without expiration.* ☑ **IMPROVEMENT PERMIT** *with site plan valid for 60 mos.* ☑ **AUTHORIZATION TO CONSTRUCT** *valid for period equal to IMPROVEMENT PERMIT--not to exceed 60 mo.*

Owner / Applicant Signature: Date: 1-6-15 Installed by: K & M Grading

IMPROVEMENT PERMIT by: Justin Henderson Date: 1/6/15 OPERATION PERMIT by: Justin Henderson Date: 2-2-16

AUTHORIZATION TO CONSTRUCT by: Justin Henderson Date: 1/6/16 Existing System Inspected by: Date:

Health Dept. Copy - WHITE Applicant (Final Approval) - YELLOW Applicant (Conditional Approval) - PINK


Scale: 1" = 30'
Gregory E. Refour
D.B. 2210, Pg. 1609
Lot 57
P.B. 27, Pg. 42
Tax PIN# 3793-41-9027
Stephen Blackstock
D.B. 2085, Pg. 952
Lot 56
P.B. 27, Pg. 42
0.503 Acre
rebar found
35' Front Setback
S 18°07'00"E 25.00'
S 33°32'36"E
N 45°47'05"E 191.21'
1 R 45' 116.26
2 P 45' 114.23
3 O 50' 111.68
4 B 44' 110.42
5 Y 41' 109.10
6 R 26' 107.59
7 P 20' 105.62
8 O 26' 103.73
9 B 28' 102.59
10 B 36' 110.89
11 O 21' 109.51
108.68'
Rad 204.57'
asphalt
concrete drive
brick dwelling
raised deck
patio
EXISTING LINES UNDER PATIO DO NOT GET CREDIT FOR FOOTAGE
15 B 25' 99.14 (EXISTING)
16 O 25' 98.06 (EXISTING)
17 R 50' 96.44 (EXISTING)
18 Y 50' 94.81 (EXISTING)
19.39'
19.69'
S 43°41'46"W 154.91'
REMOVE ~12' OF FILL OVER THIS LINE
12 R 52' 99.38
13 P 57' 97.11
14 O 56' 95.24
S1
7 LINE DROP
N 46°27'31"W 135.00'
Septic Easement for Lot 57
N 46°27'42"W 100.70' total
Fairways at River Oak
D.B. 2227, Pg. 21
Lot 55
P.B. 27, Pg. 42
e Ops, LLC
2058, Pg. 42